


EARTH	
22.27	691.2
22.27	492.0
22.2	601.8
22.27	692.0
1.87	

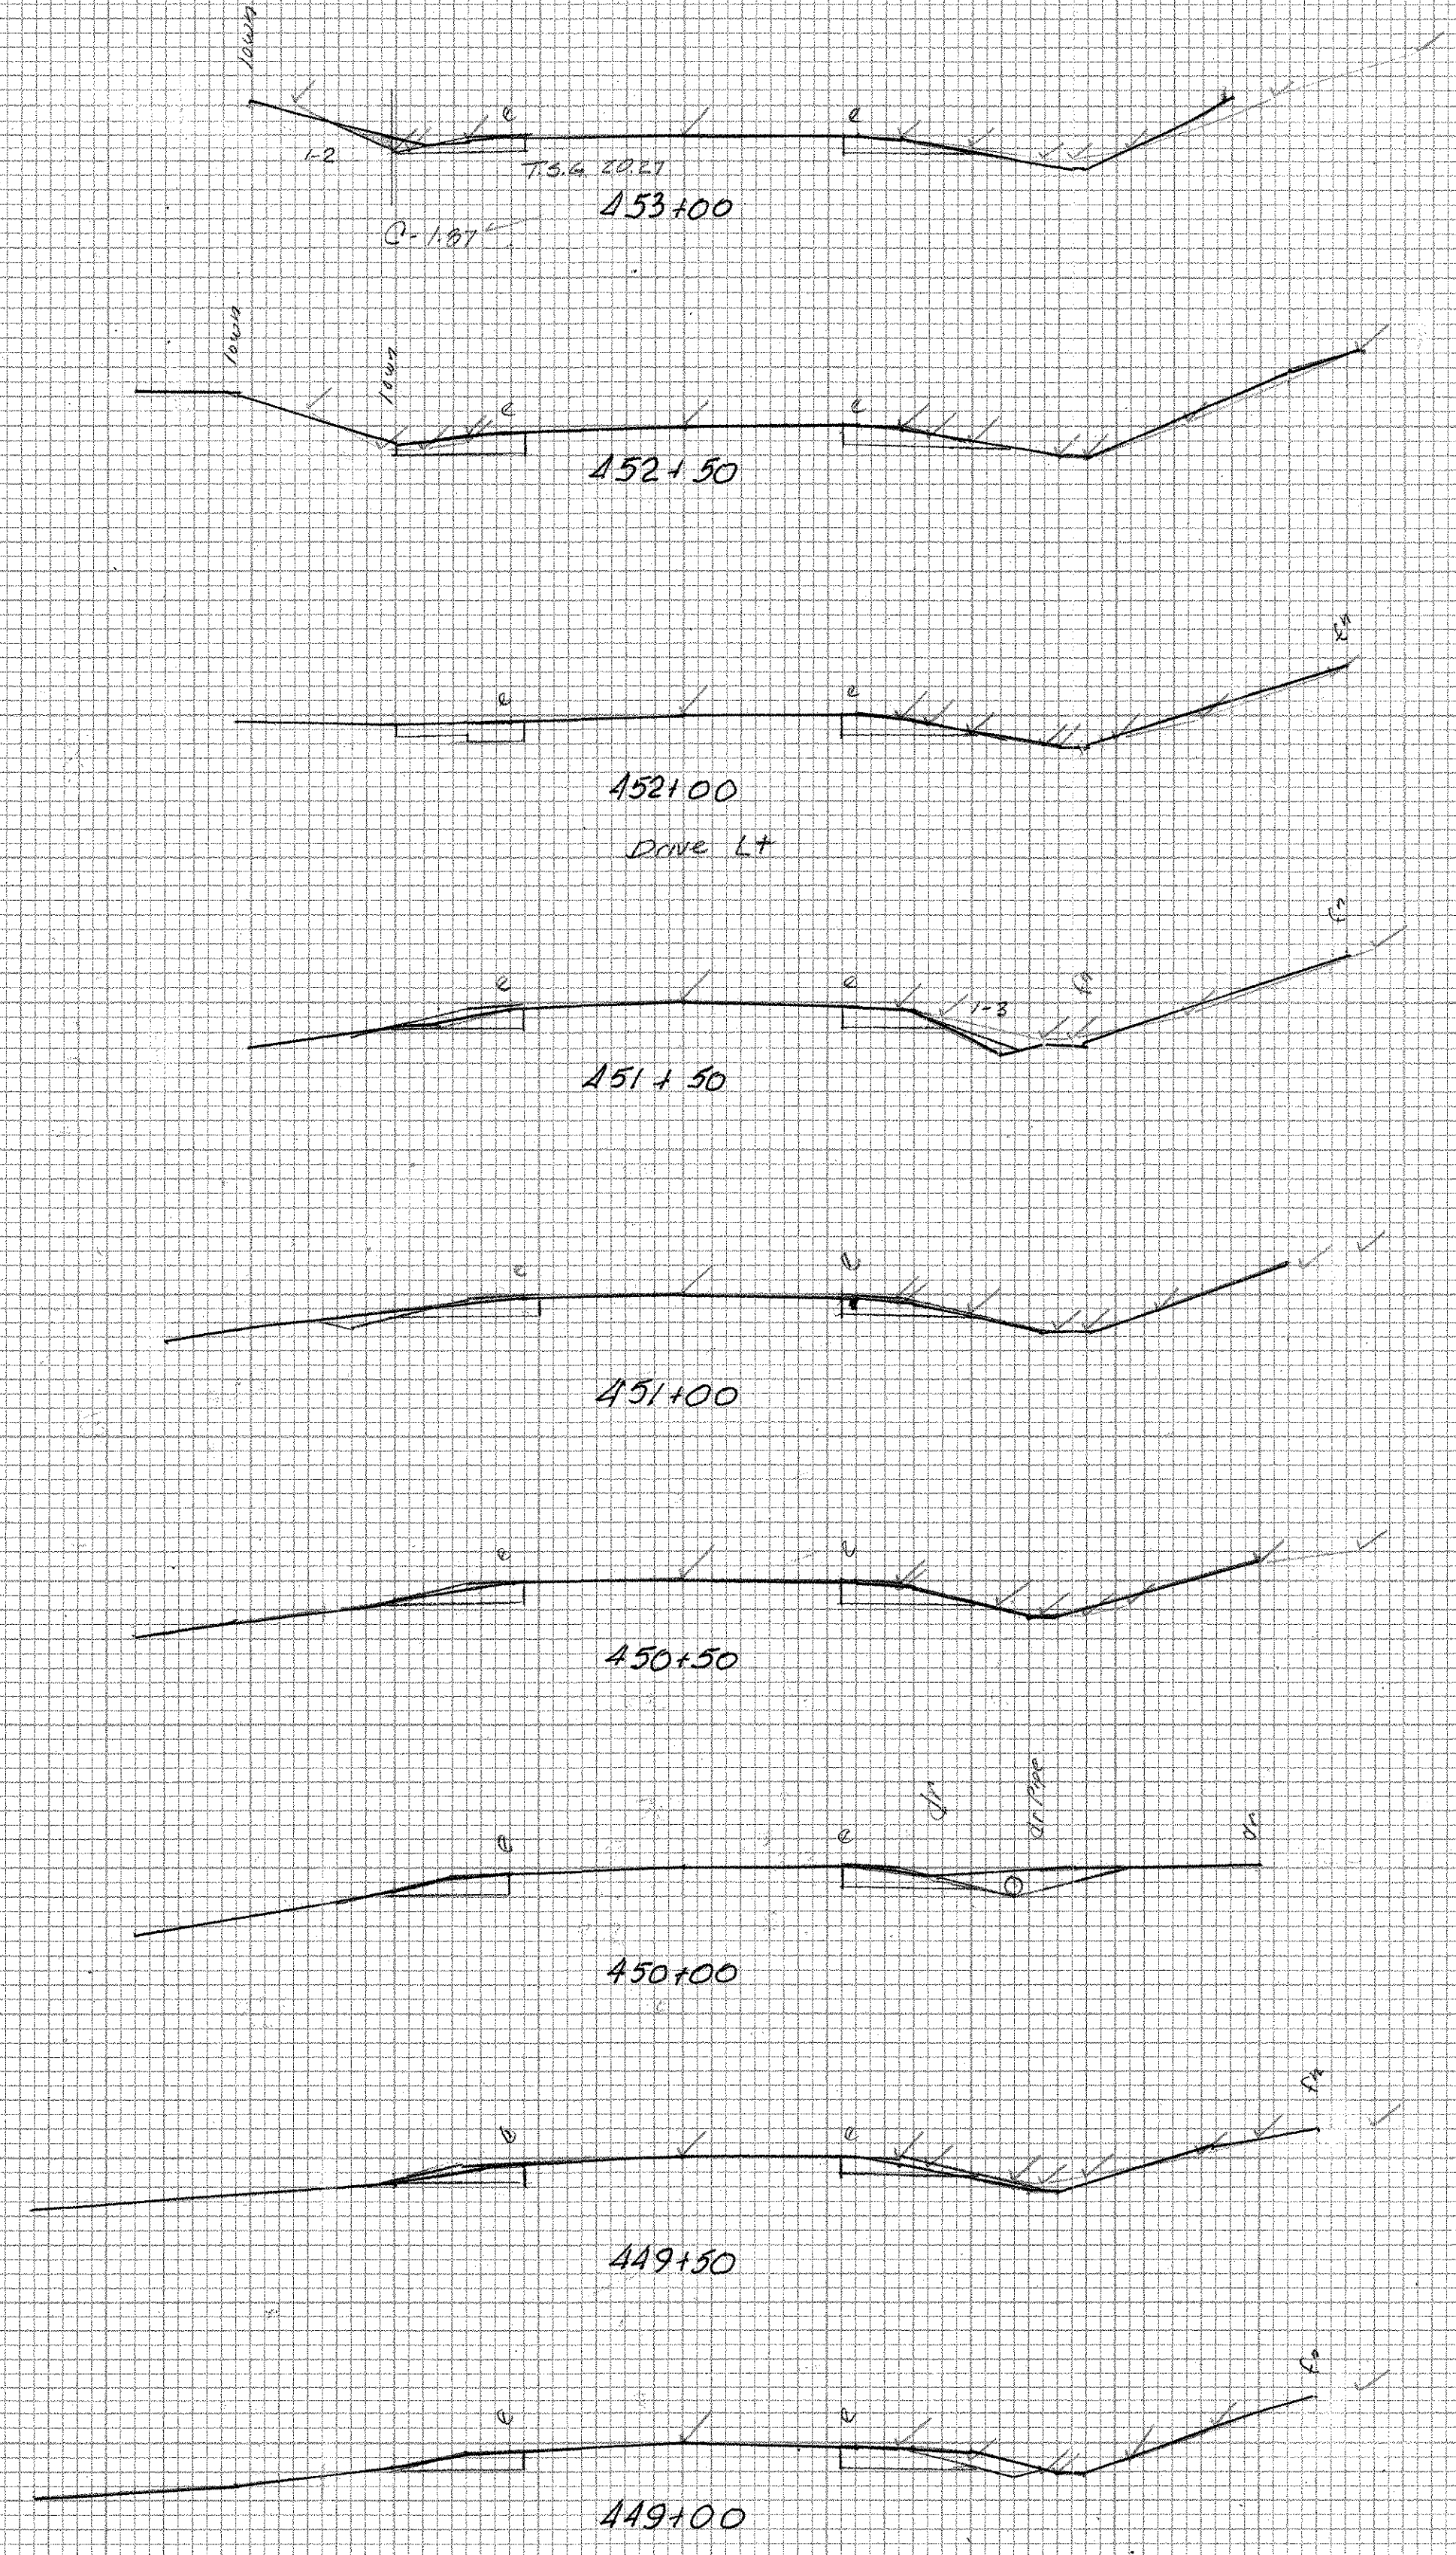

SHOREHAM-BRIDGPORT ADDISON
 FO 17-1(12)
 444+50 - 453+00
 Original Sections
 sheet 401-0 of 477

ORIGINAL SURVEY	DATE

FINAL SURVEY	DATE

W.S. 5-9-92