


FINAL SURVEY NOTE BOOK No. _____
 SURVEYED BY _____
 PLOTTED BY _____
 TEMPLATE AREA _____
 AREAS CHECKED _____

ORIGINAL SURVEY NOTE BOOK No. _____
 SURVEYED BY _____
 PLOTTED BY _____
 TEMPLATE AREA _____
 AREAS CHECKED _____

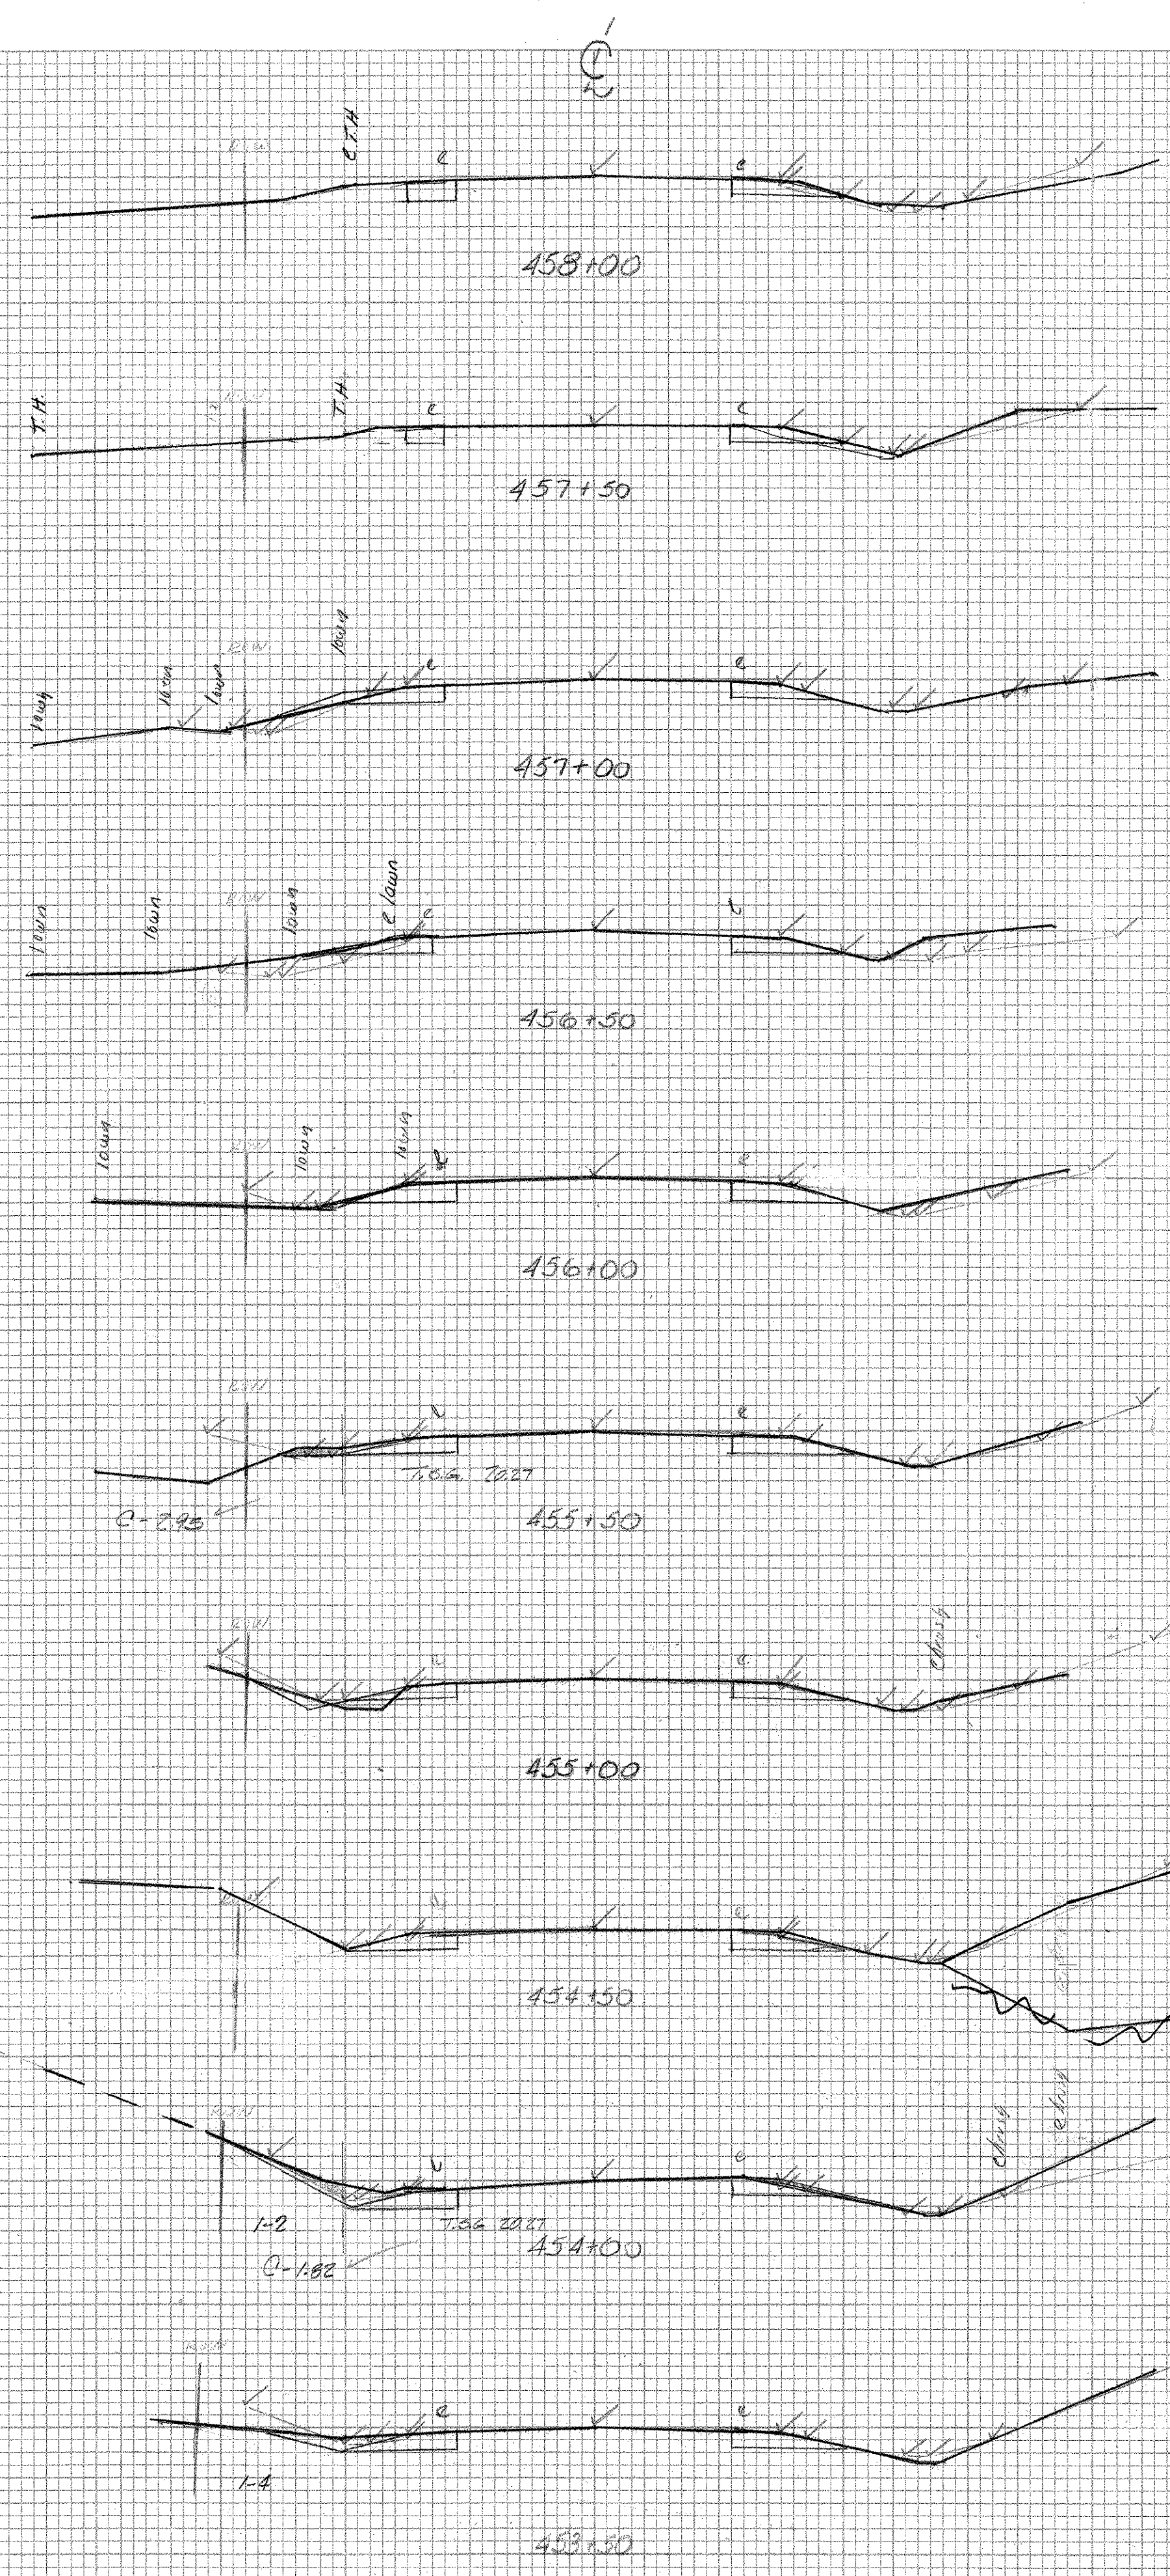


EARTH

20.21	498.6
20.21	498.0
20.2	498.0
20.0	498.7
20.27	498.6
1.95	

EARTH

20.21	497.5
20.21	497.7
20.0	500.0
20.0	500.0
20.21	497.3
1.82	

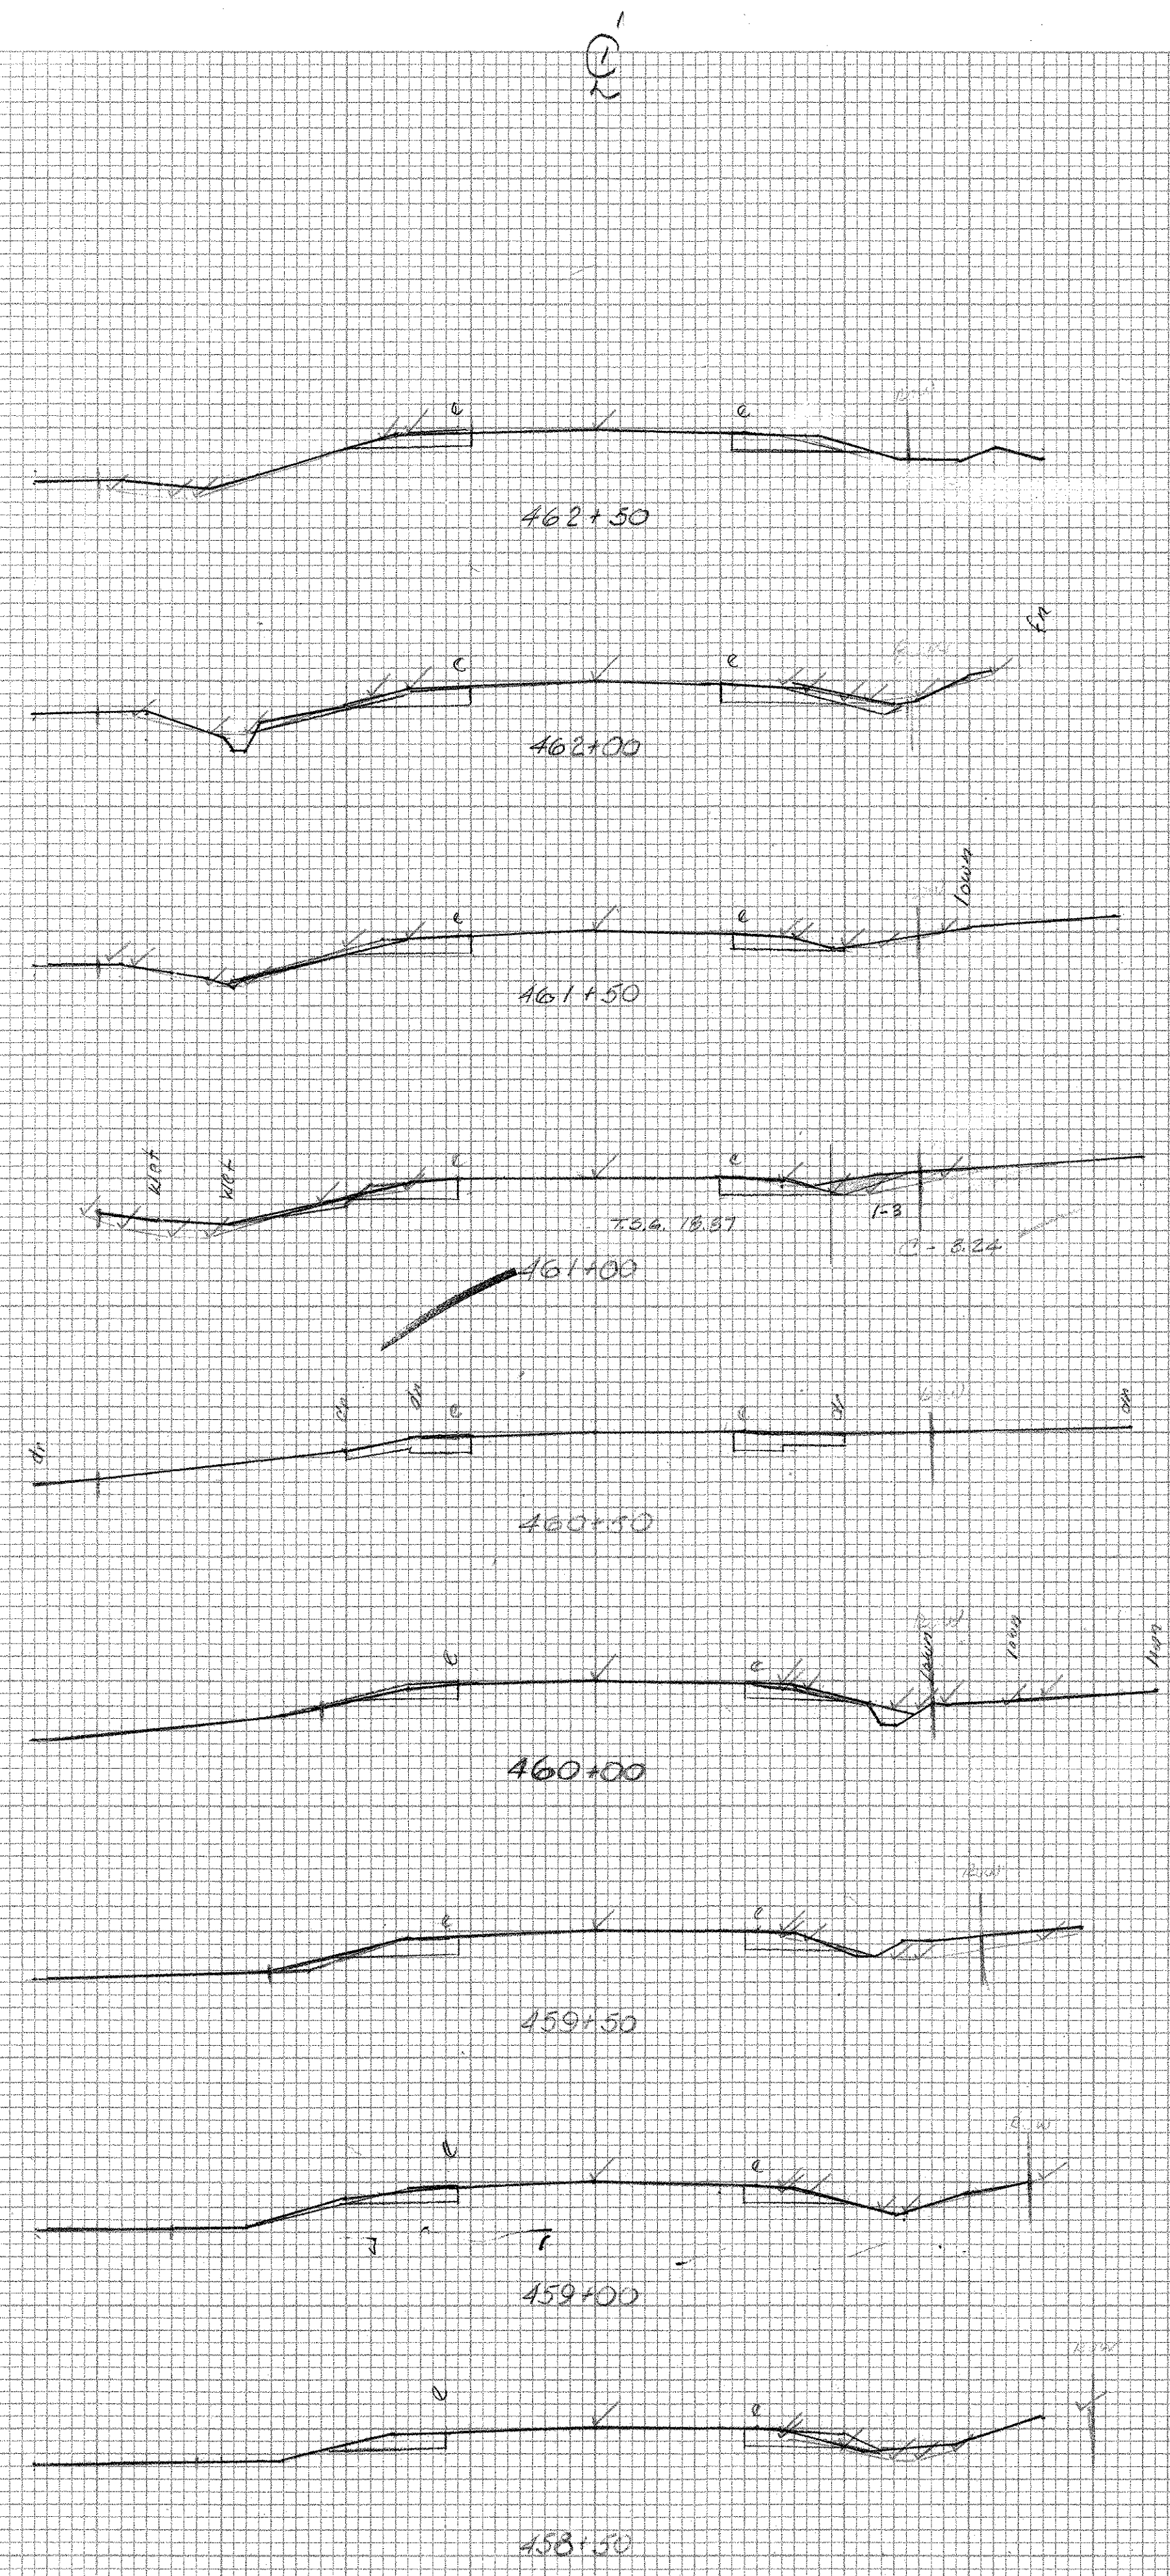

EARTH

18.87	499.7
18.87	499.0
18.0	499.0
18.0	499.0
18.87	499.7
3.24	

SHOREHAM BRIDGPORT-ADDISON
 FO17-1(2)

458+50-462+50

Sheet 404-P of 477