

FINAL SURVEY NOTE BOOK NO. _____

DATE _____ BY _____

REVISIONS: _____

PLOTTED _____

TEMPERATURE _____

AREA CHECKED _____

ORIGINAL SURVEY NOTE BOOK NO. _____



DATE _____ BY _____

REVISIONS: _____

PLOTTED _____

TEMPERATURE _____

AREA CHECKED _____

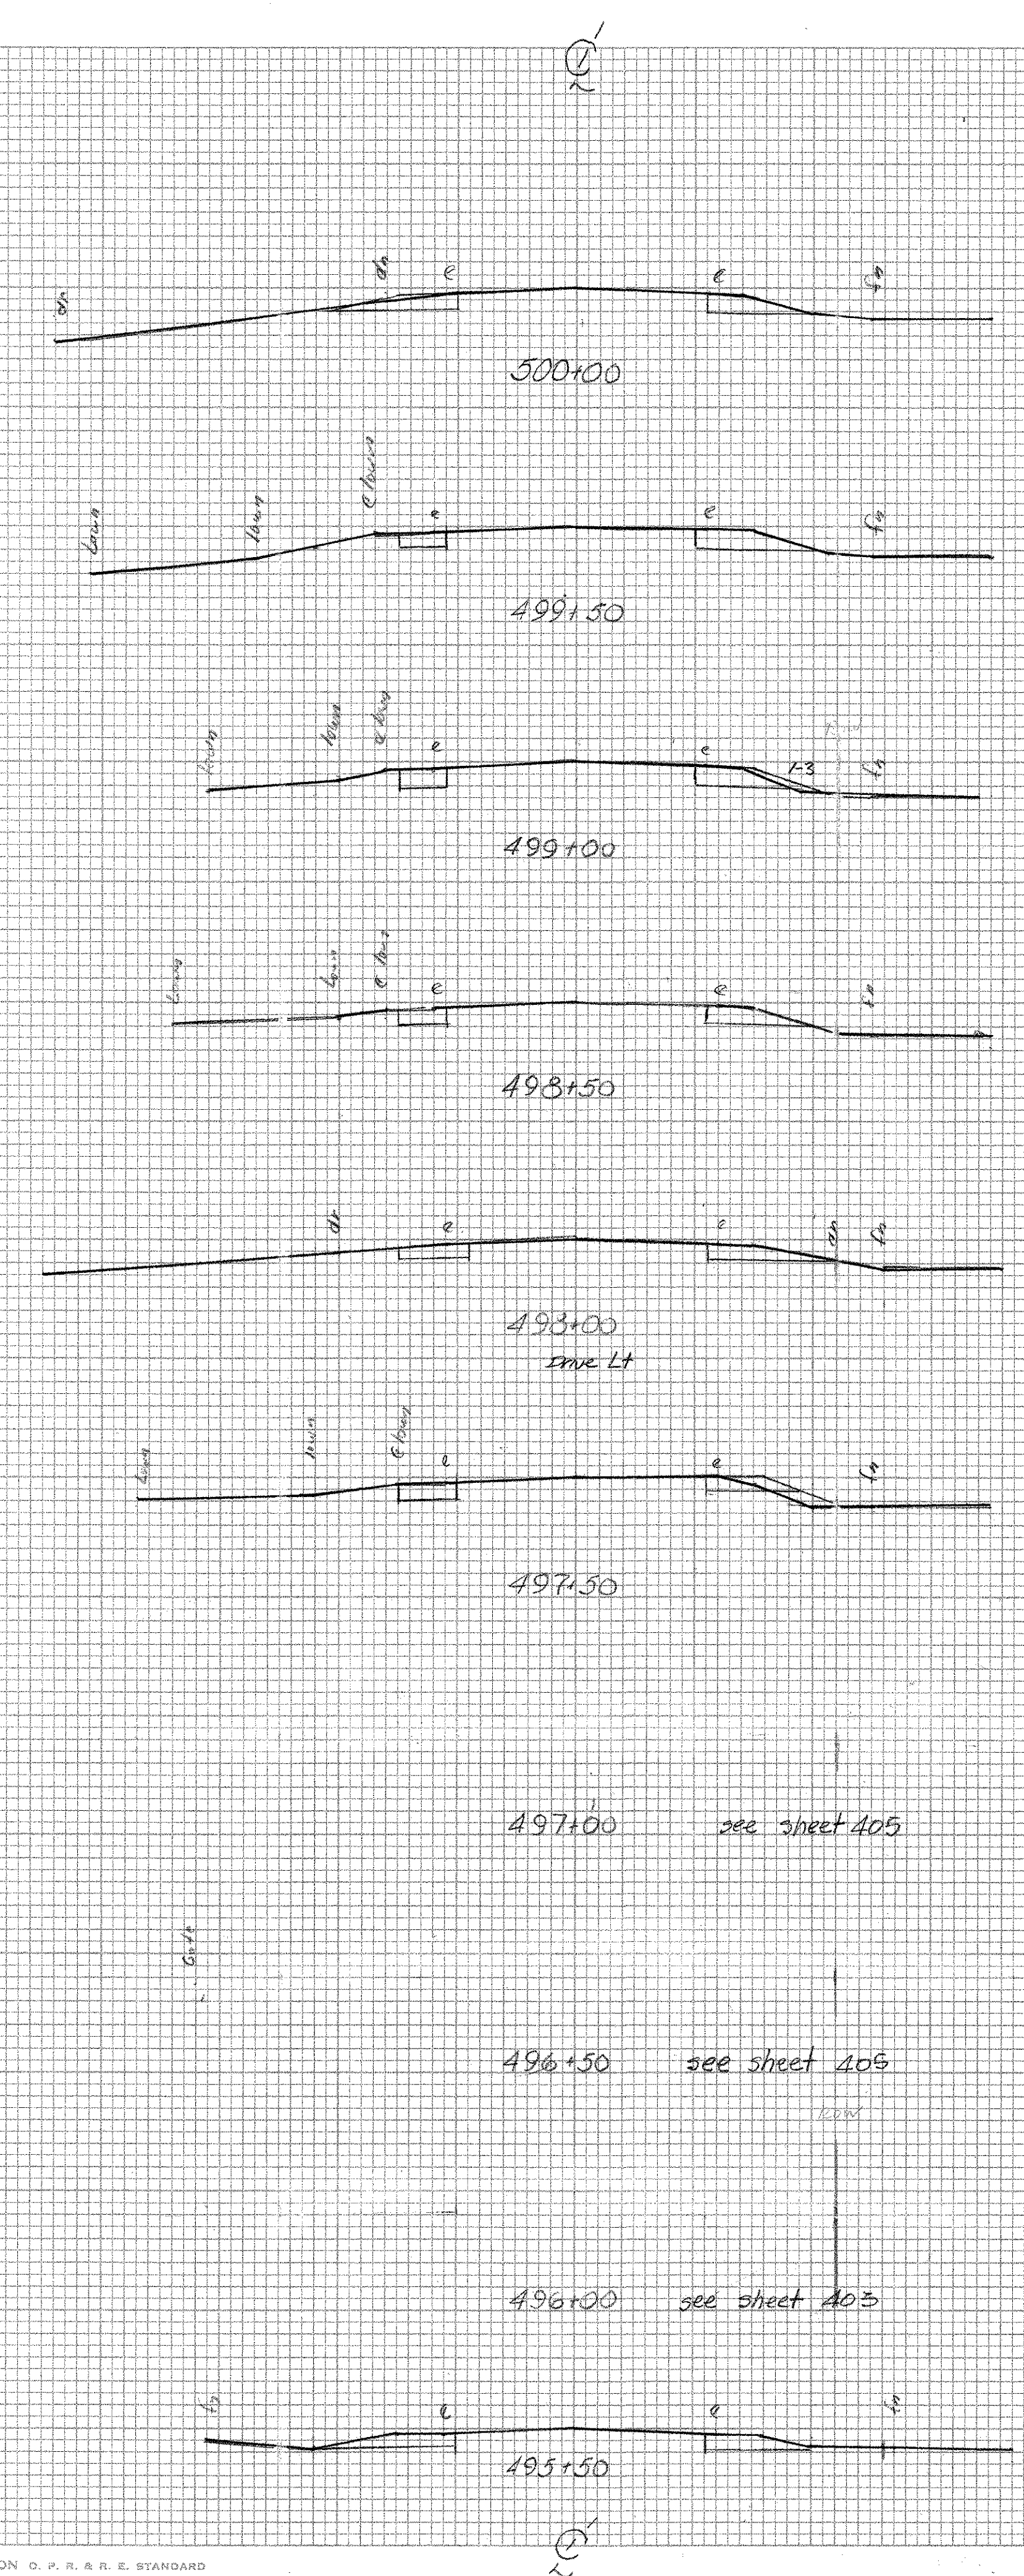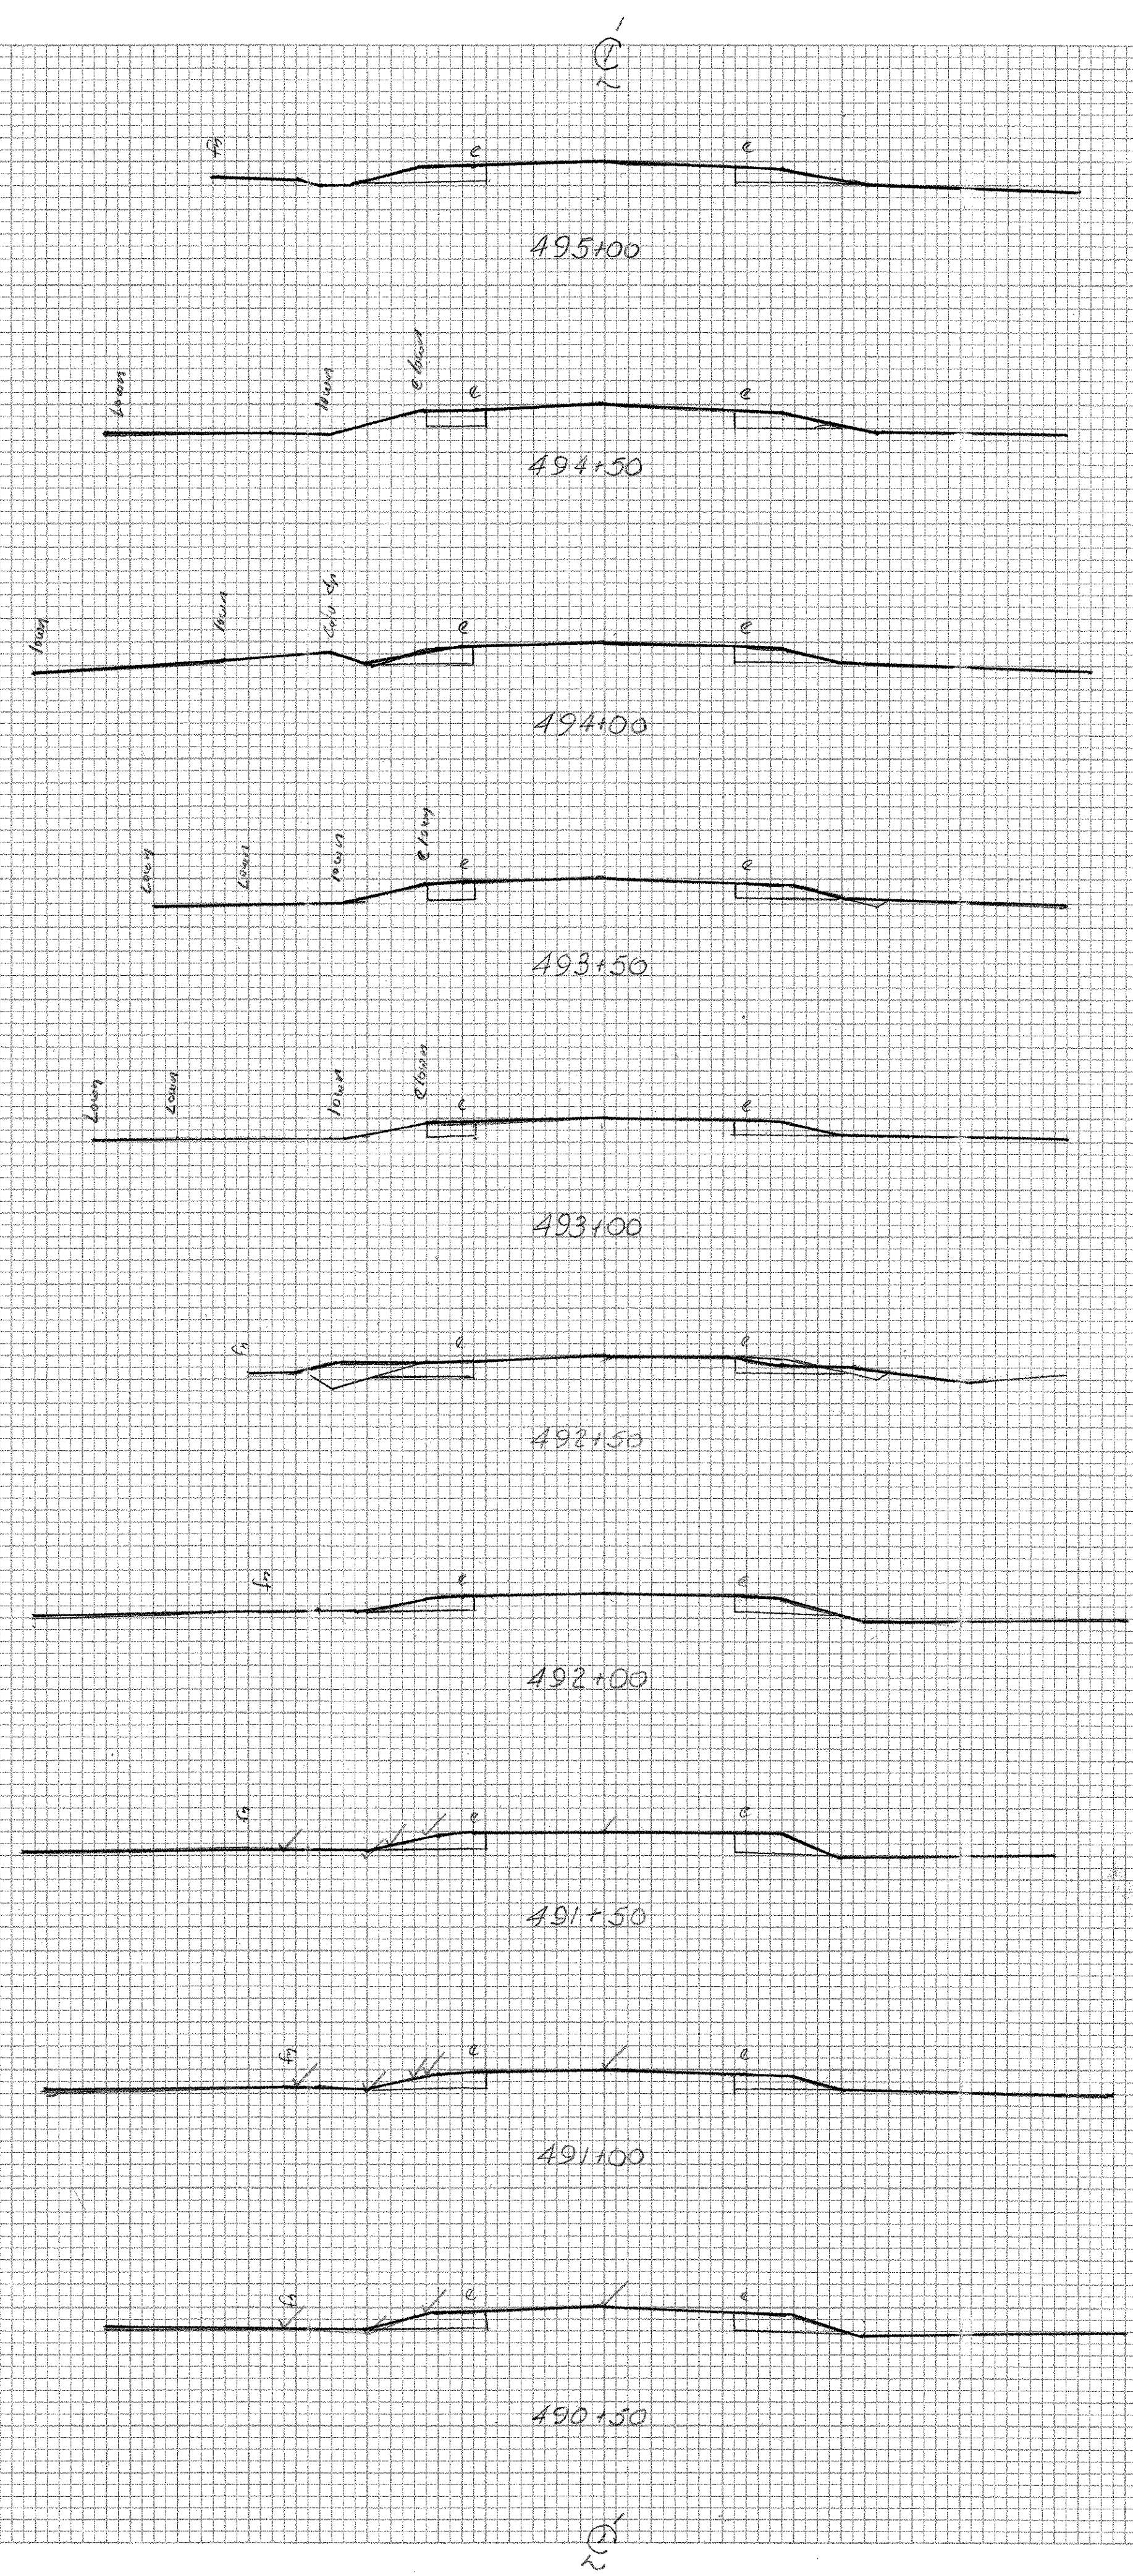

SHOREHAM BRIDPORT-ADDISON
FOIT-1(2)

490+50 - 500+00