



CHANNEL	
1	498.8
14	494.3
7	491.3
5	491.0
0	491.0
-4	491.0
-11	498.0
-18	494.5
0	493.8

490

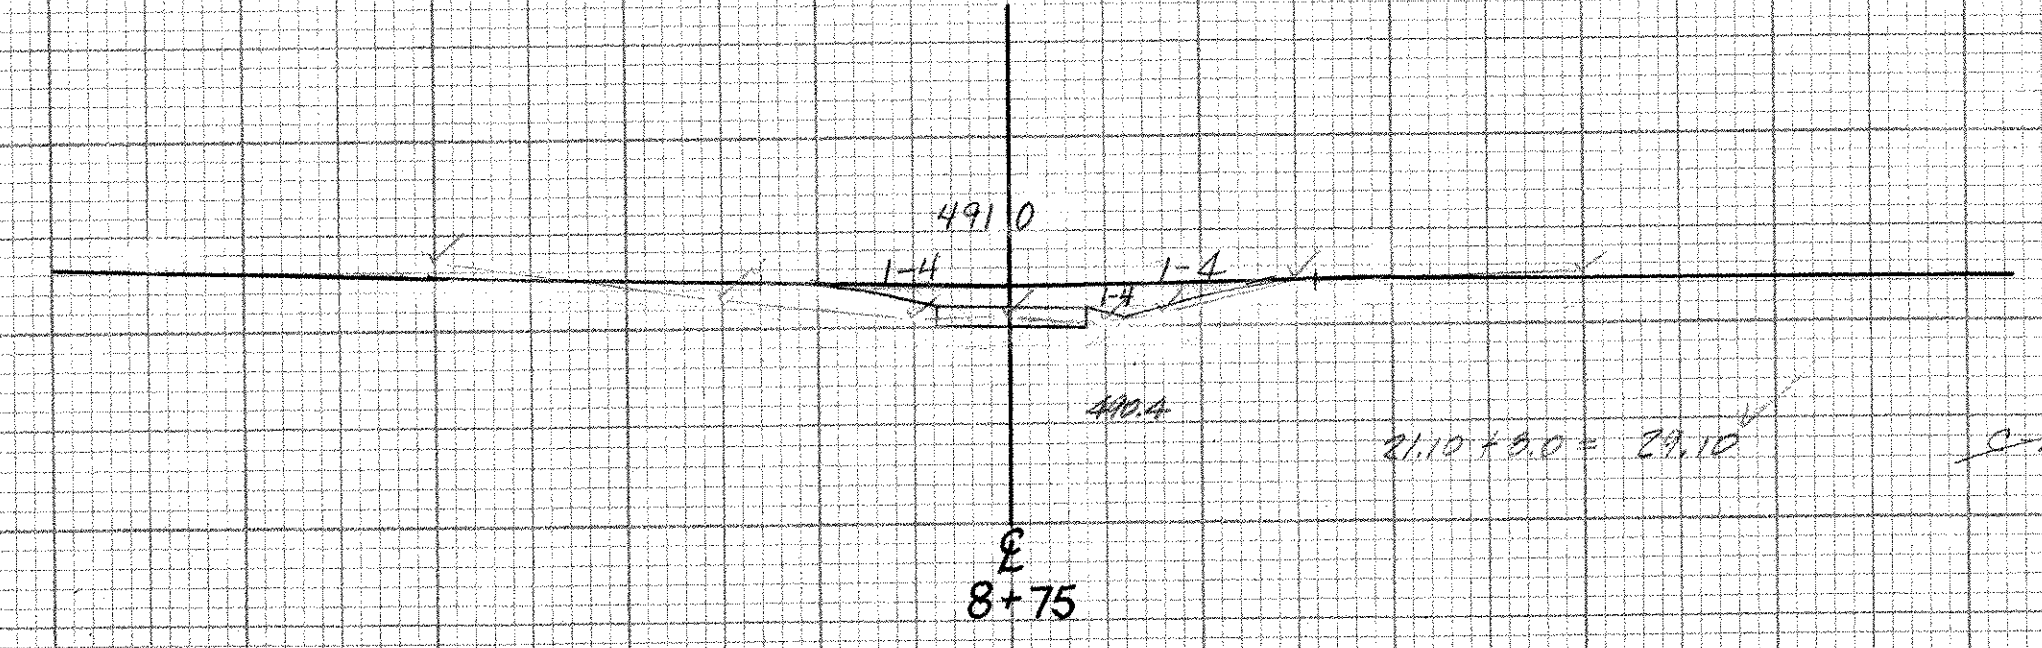


CHANNEL	
0	492.0
15	492.1
6	492.4
4	491.0
-4	491.0
-10	492.0
0	492.0

490

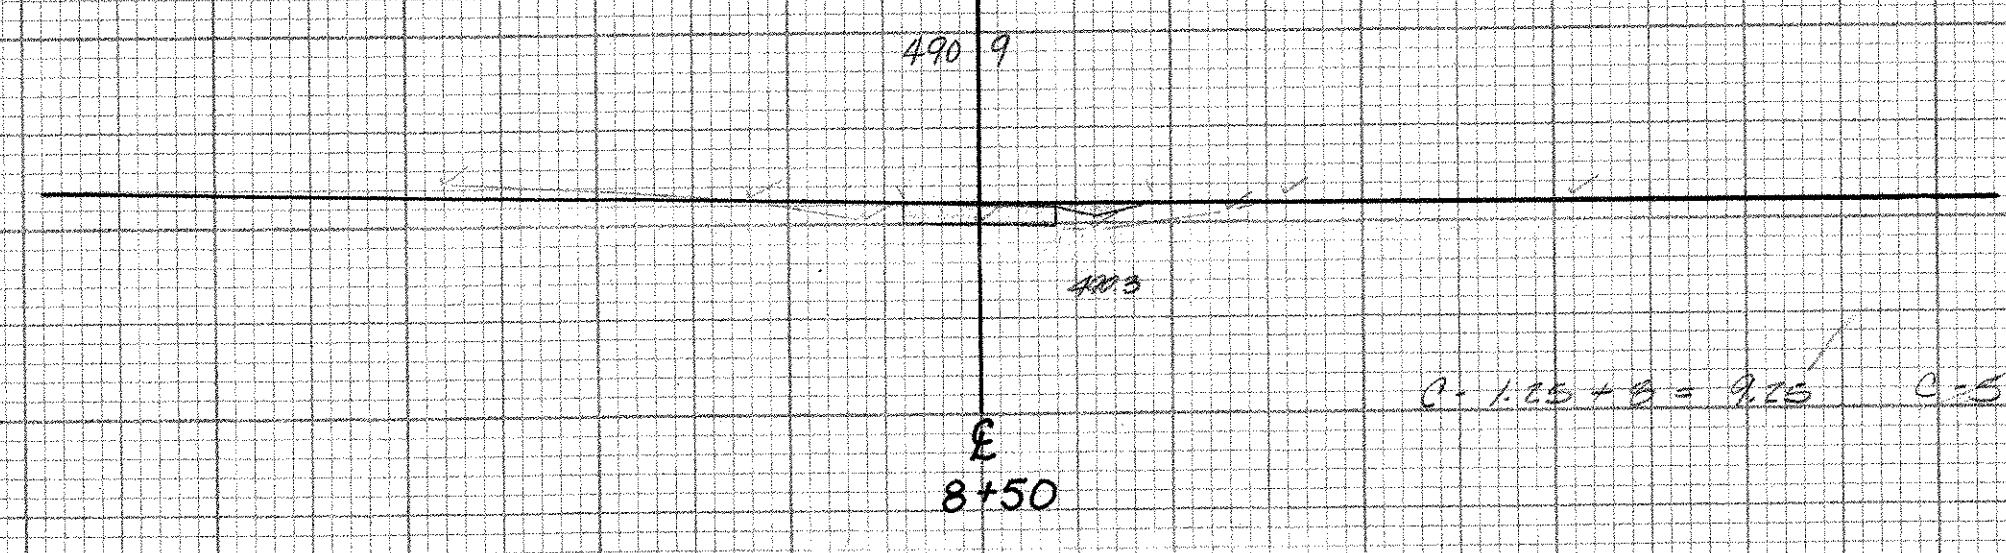


CHANNEL	
4	491.0
6	492.5
9	491.0
4	491.0

490

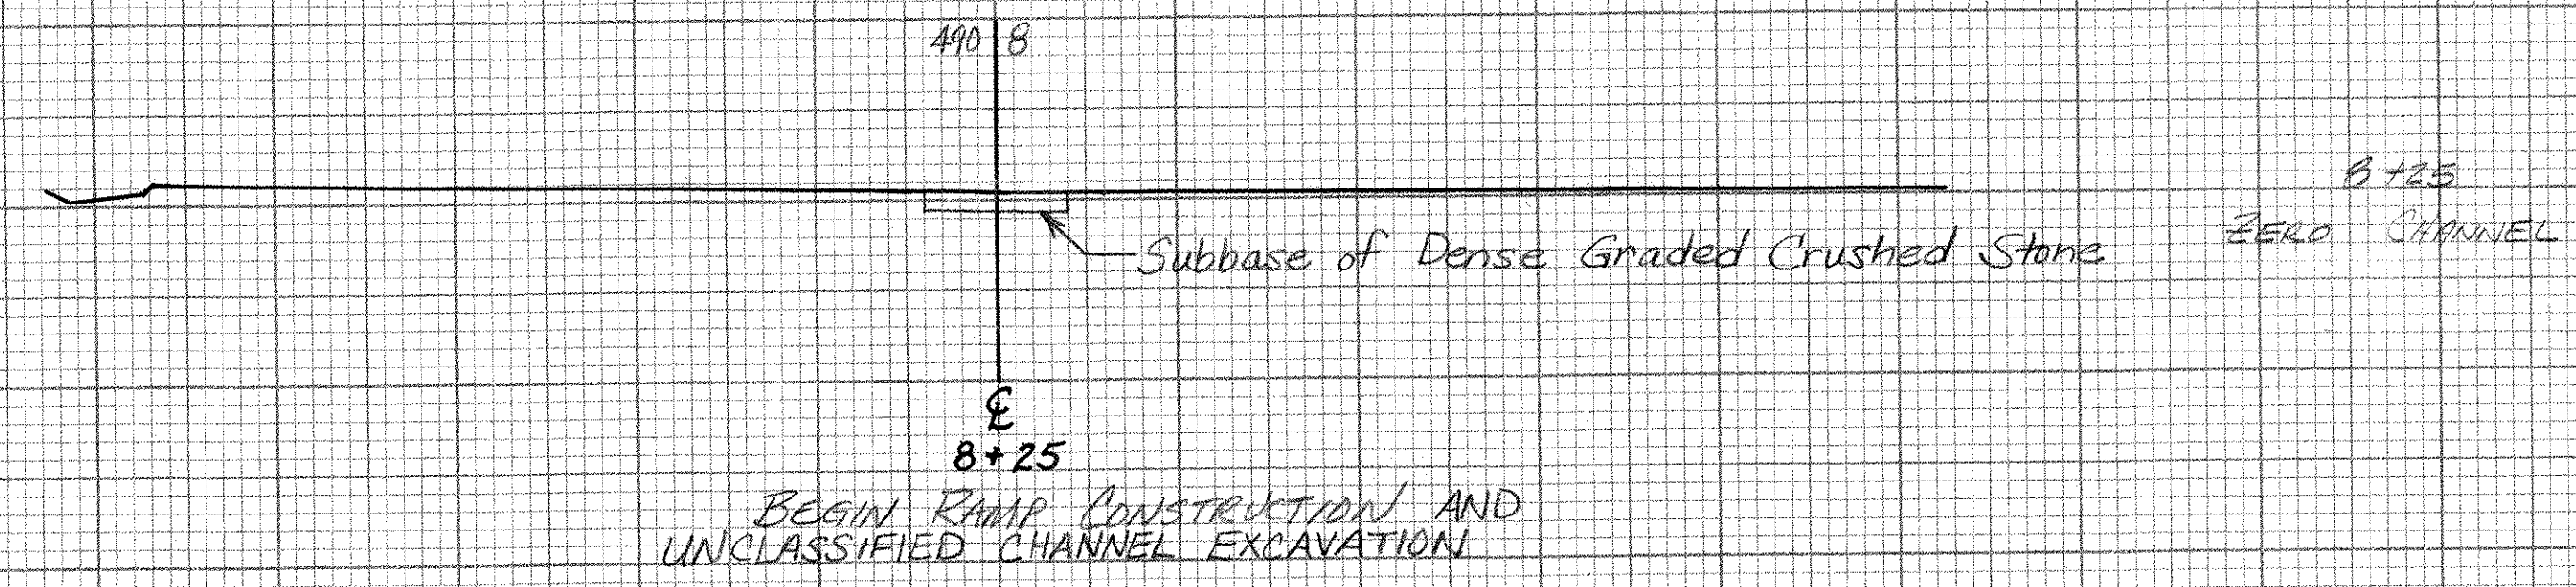

490

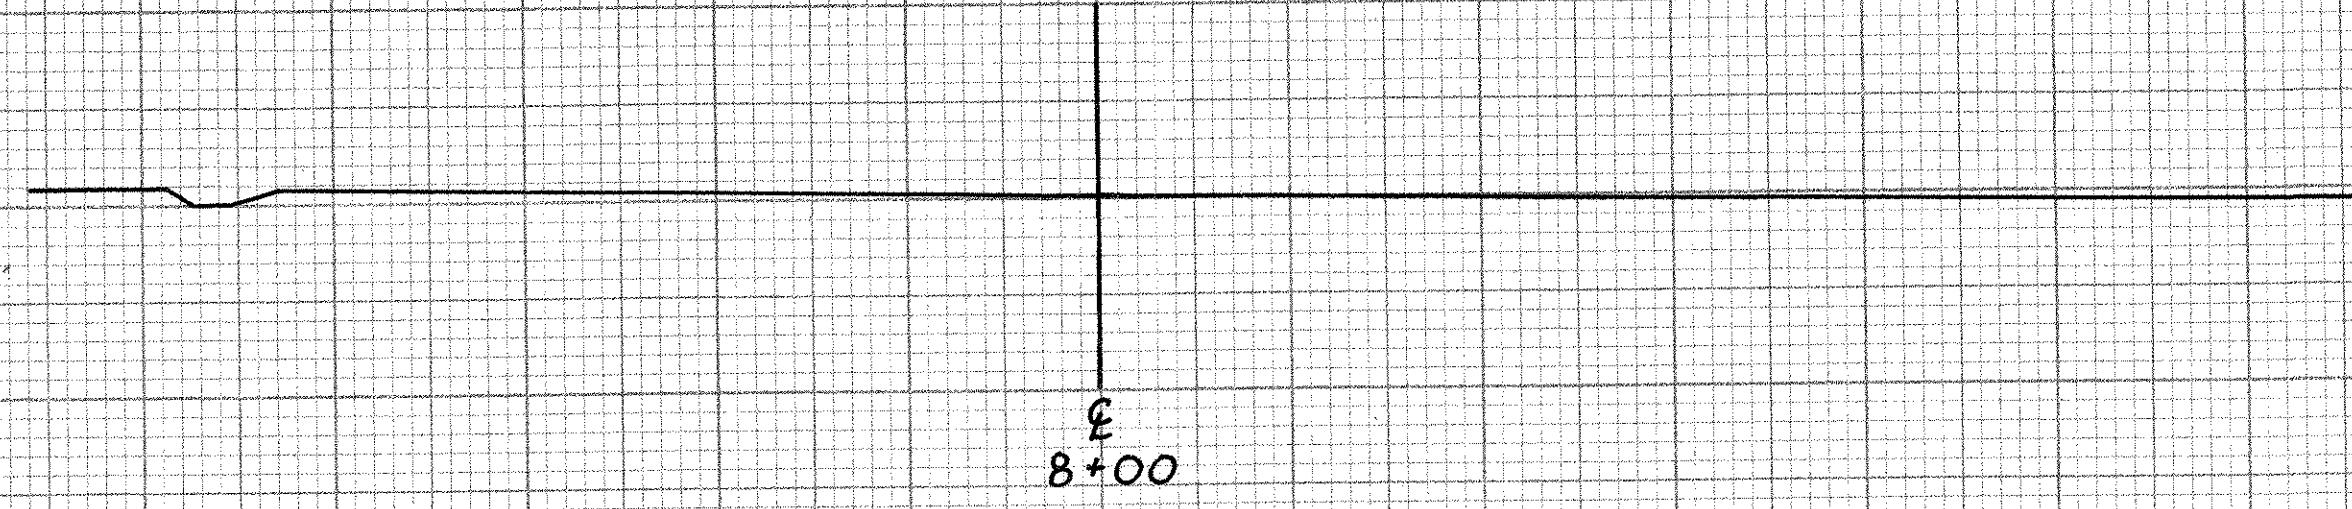

490

Channel Section of Cattle Pass @ Addison MM 3.09

FROM STA	8+00	TO STA	9+00
PROJECT NAME	SHOREHAM-BAIDPORT-ADDISON		
NO.	FOIT-1(2)	PLOTTED	05/18/88
SURVEYED BY	FANTONI	10/87	0081
SHEET	406 OF 420 SHEETS	SHEET	406 OF 417

SCALE 10 FEET