



(Pay As Common Excavation)

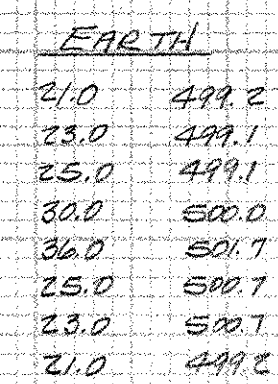


500


507+00

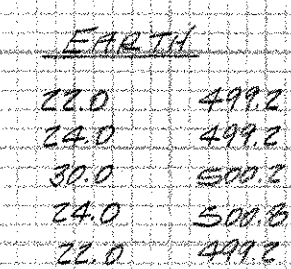

500

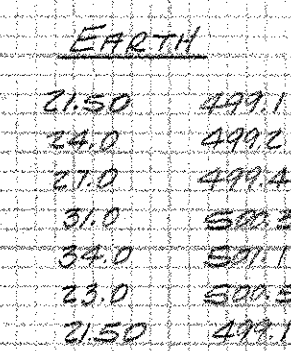


500

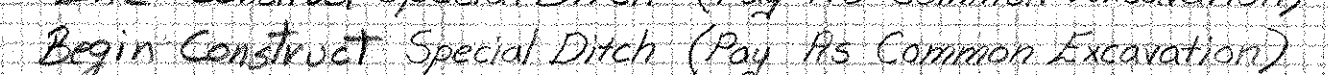

500

Existing 24" ACCGMP ~ Retain & Remove Headwall Inlet
Extend Inlet "1 New 24" x 4' CSP (.064) & 24" CSPE3 (.064)
Extend Outlet "1 New 24" x 4' CSP (.064) and Construct Outlet Ditch.

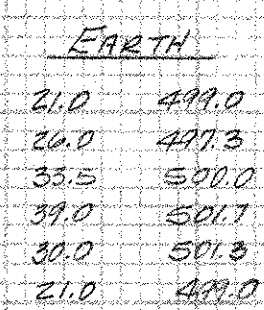

500

ADDISON MM 3.21 ~ MM 3.31

FROM STA.	505+50	TO STA.	507+00
PROJECT NAME	SHOREHAM-ADDISON MAIN9		
NO.	F017-1(2)	PLOTTED 01/09/85	
SURVEYED BY	FANTONI	DEC 1984	
SHEET 411 OF	420 SHEETS	SHEET 411 OF 477	

SCALE 10 FEET