

FINAL SURVEY NOTE BOOK No. \_\_\_\_\_

DATE \_\_\_\_\_ BY \_\_\_\_\_

SURVEYED \_\_\_\_\_ PLOTTED \_\_\_\_\_











AREA CHECKED \_\_\_\_\_

ORIGINAL SURVEY NOTE BOOK No. \_\_\_\_\_

DATE \_\_\_\_\_ BY \_\_\_\_\_

SURVEYED \_\_\_\_\_ PLOTTED \_\_\_\_\_

AREA CHECKED \_\_\_\_\_

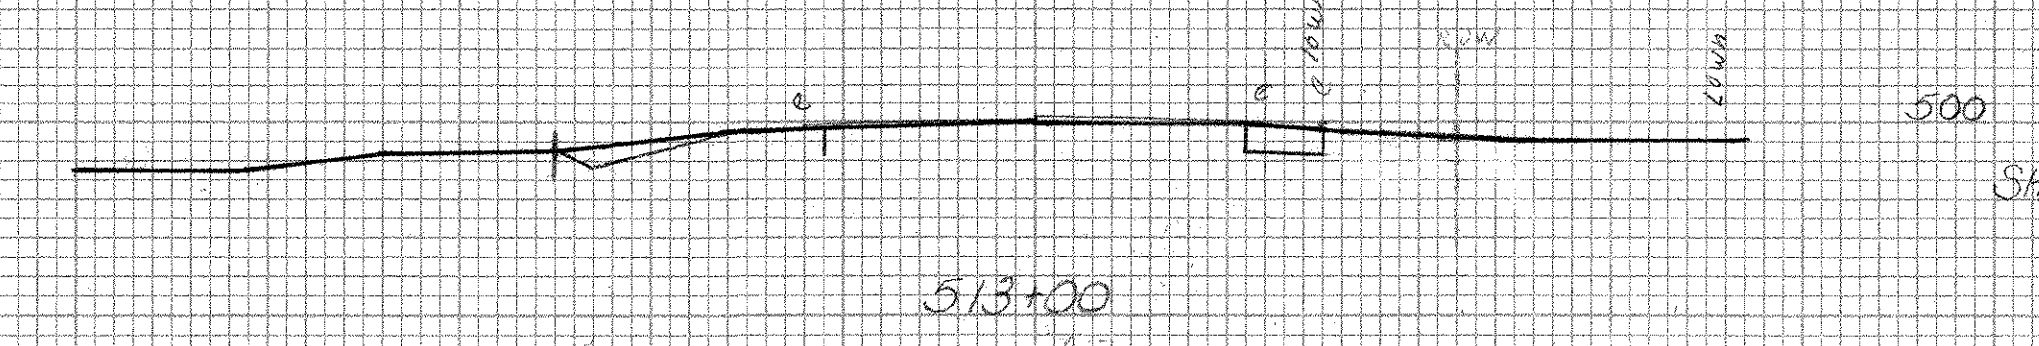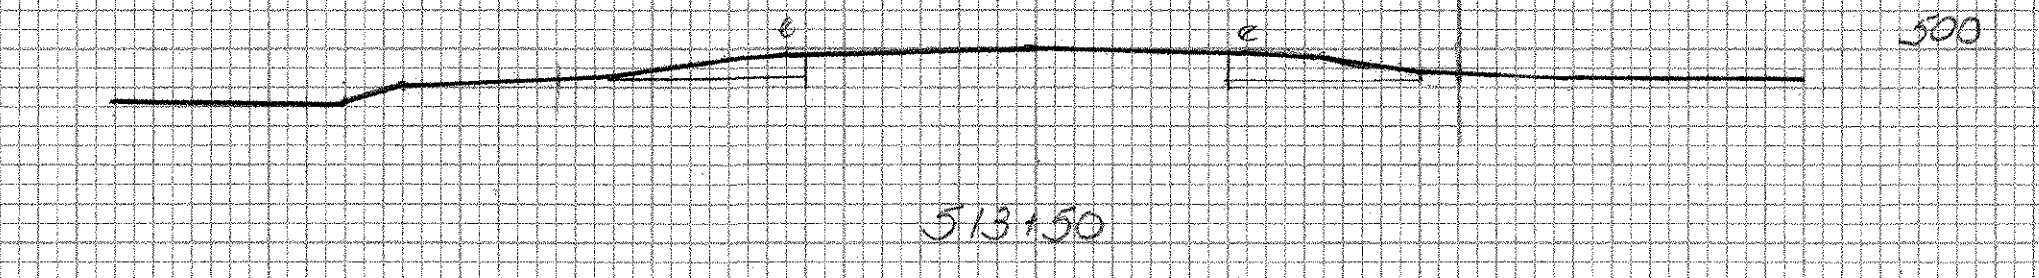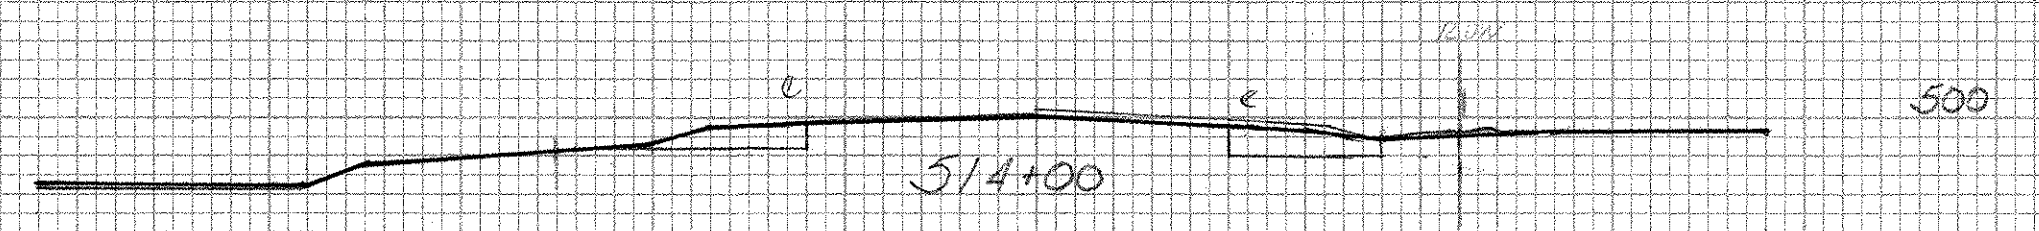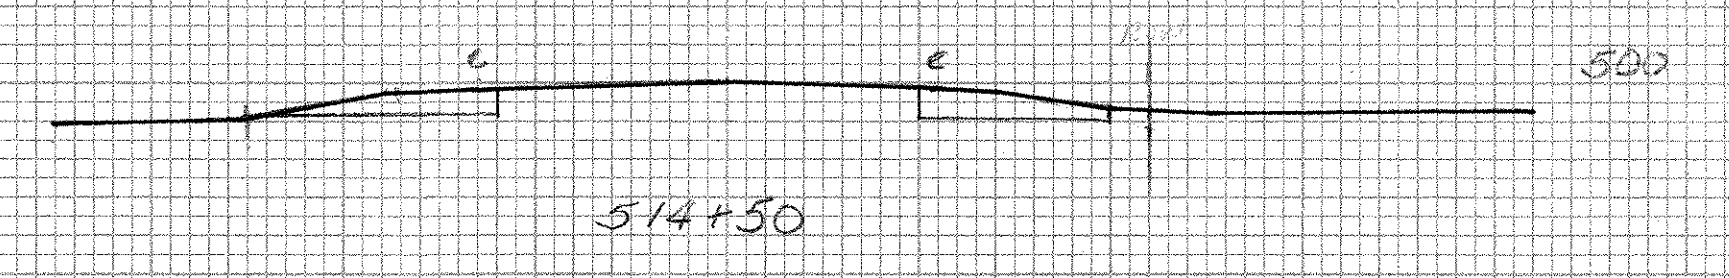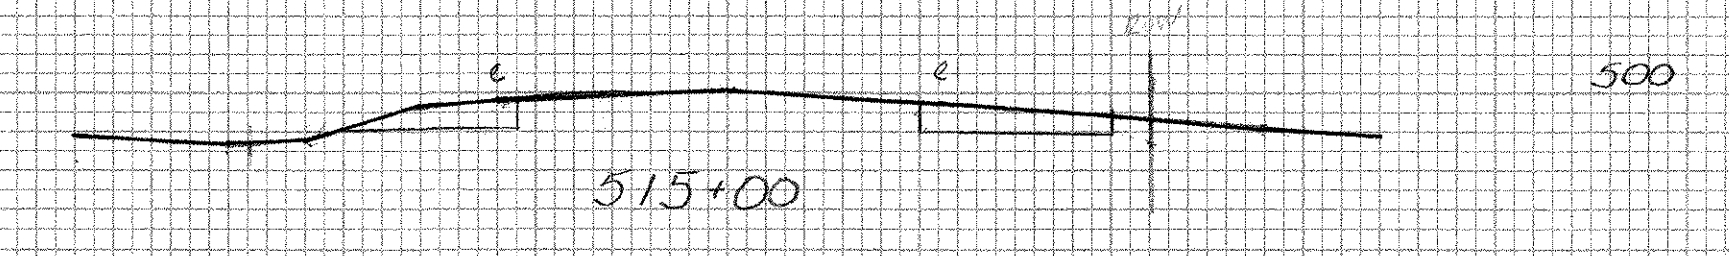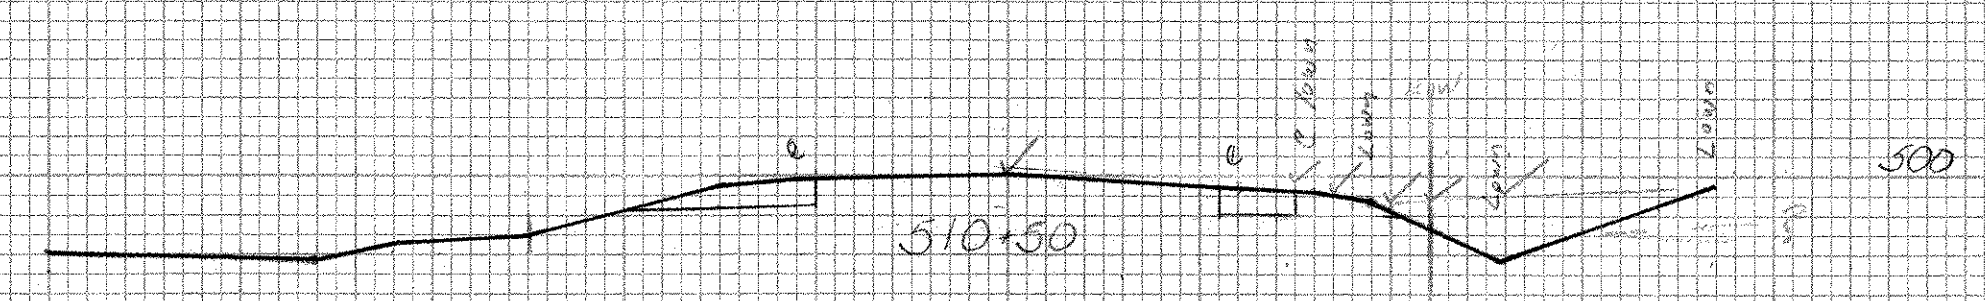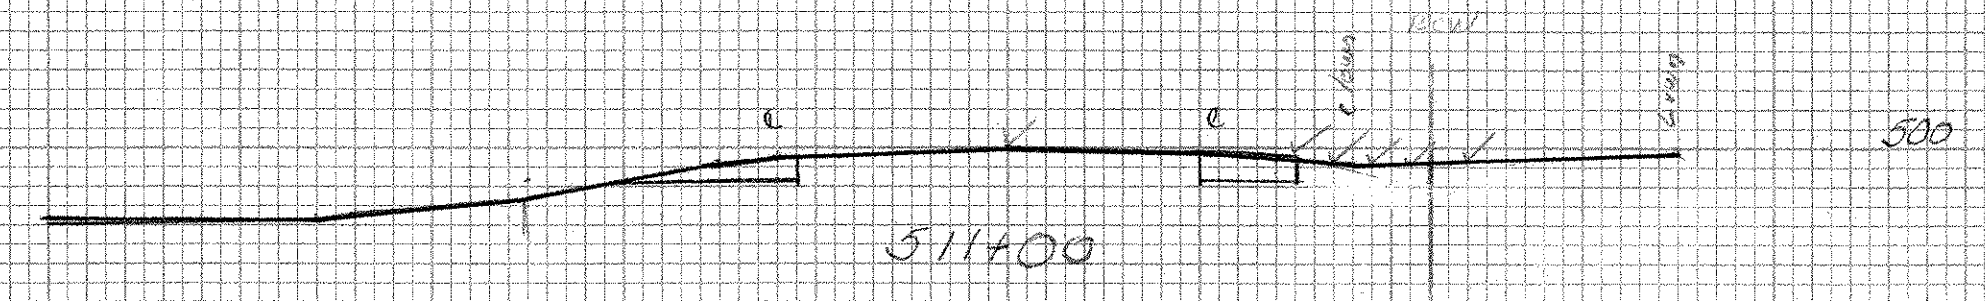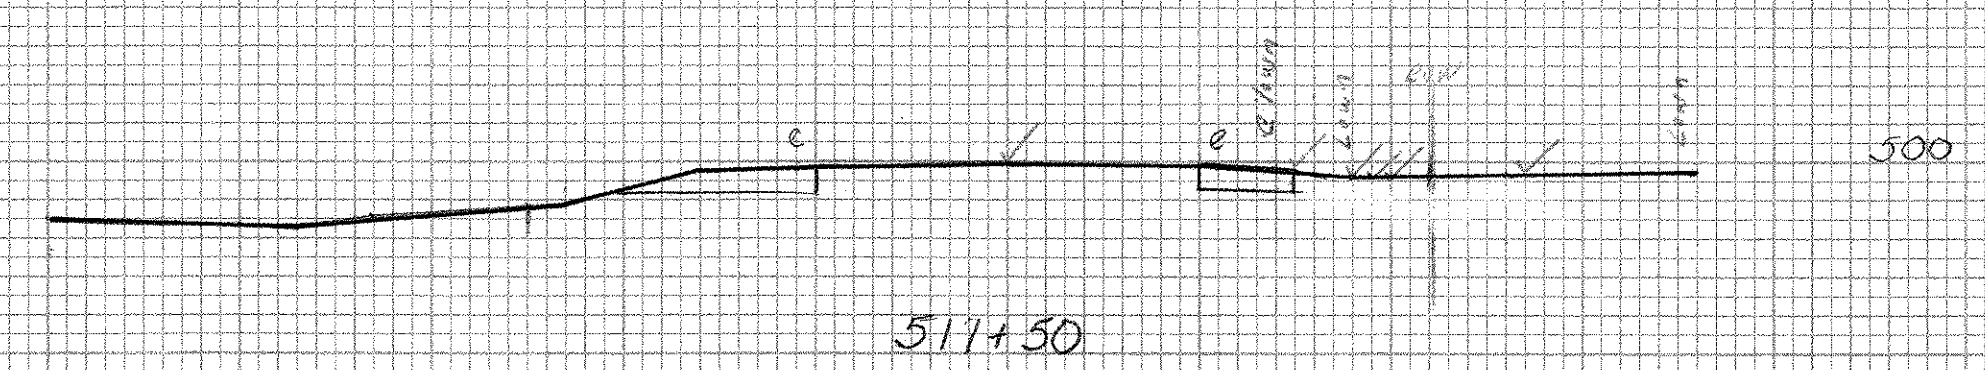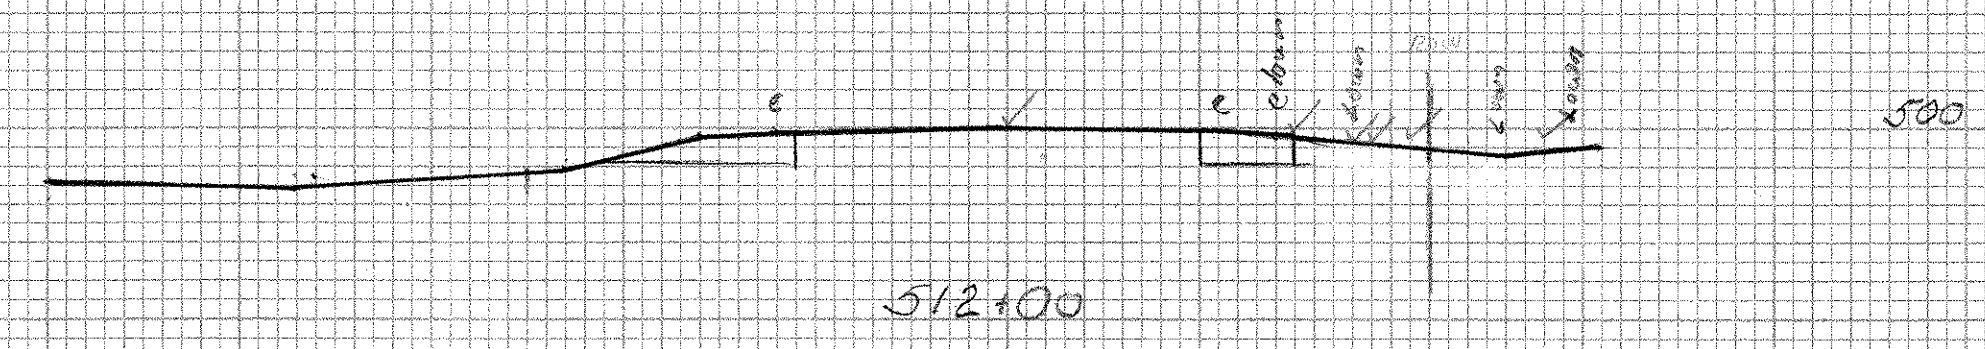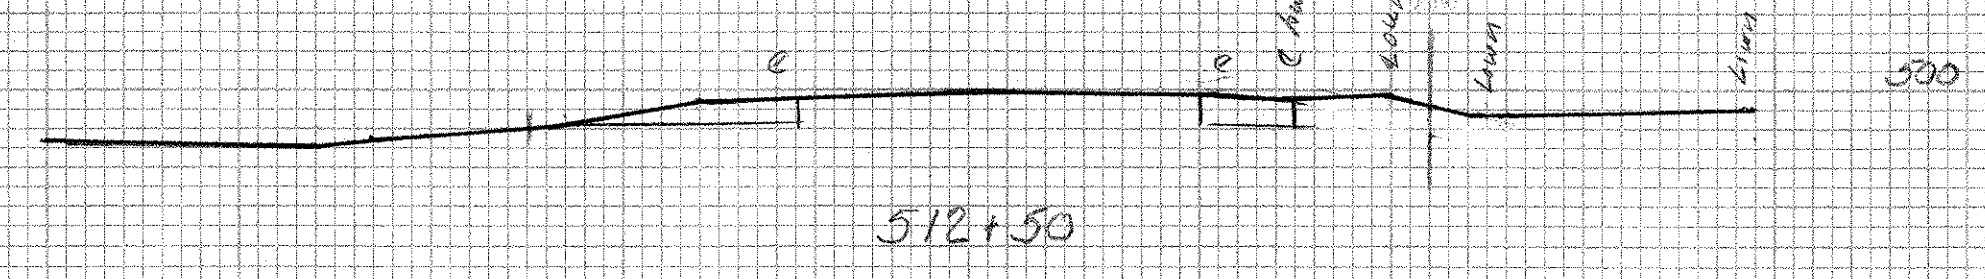

SHOREHAM BRIDGPORT ADDITION  
FO17-1(2)

Original Sections

Plotted by BRUSSE

510+50 ~ 515+00  
SHEET 412 A OF 477