
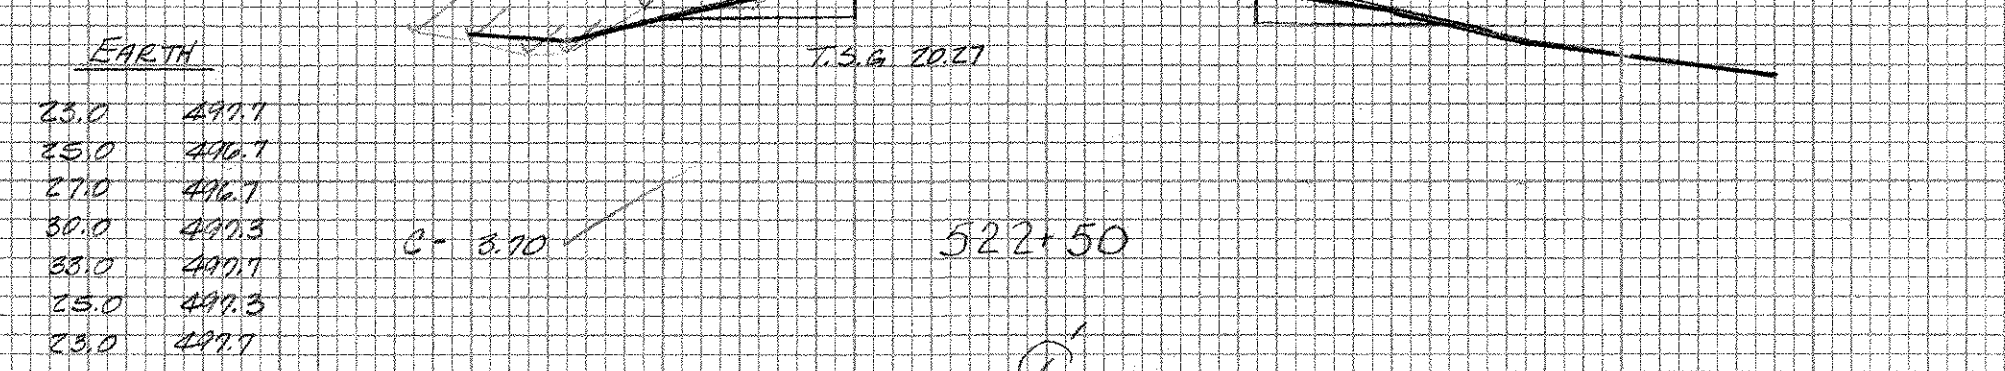
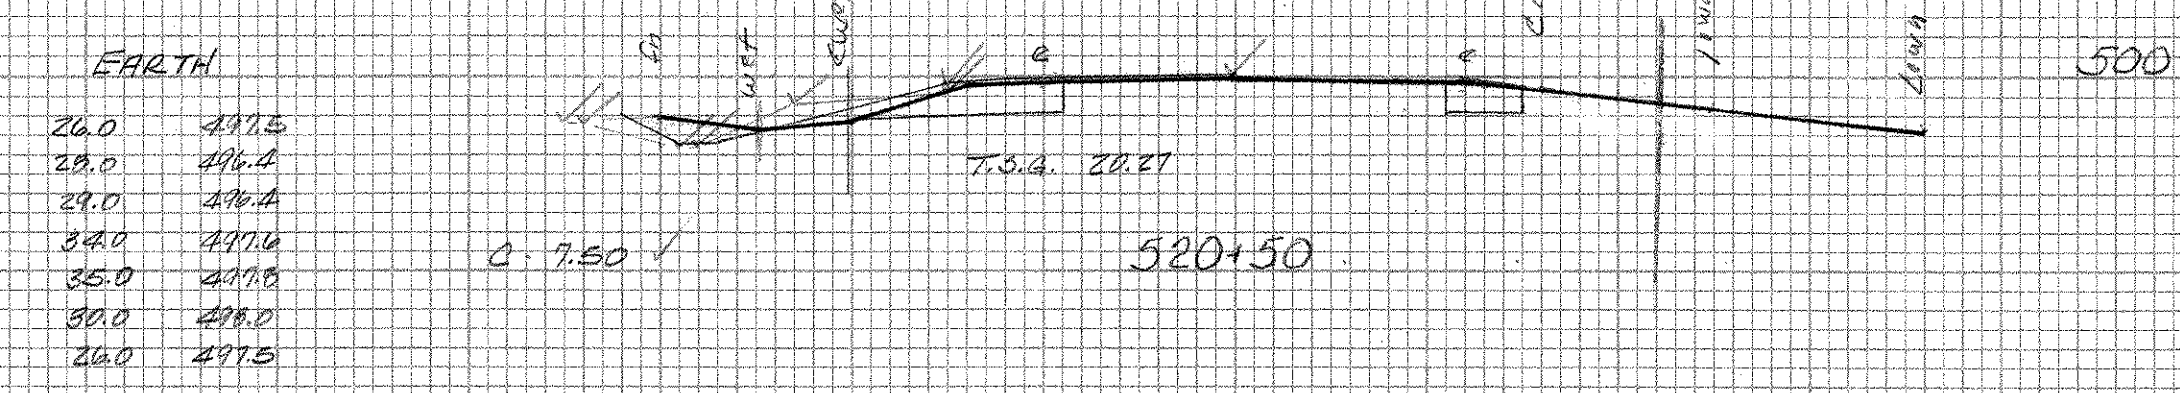
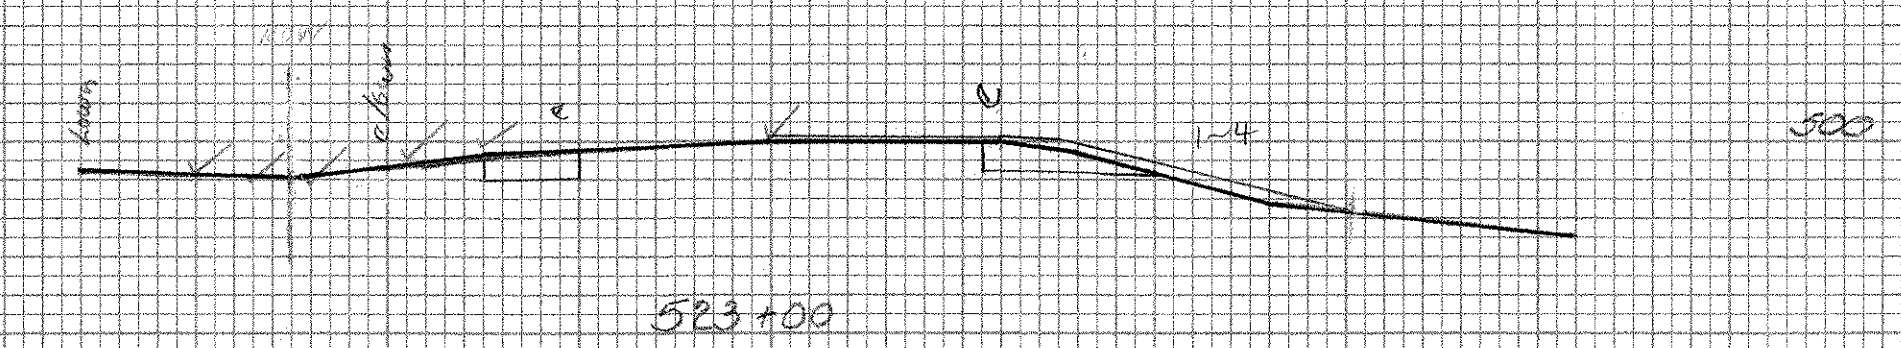
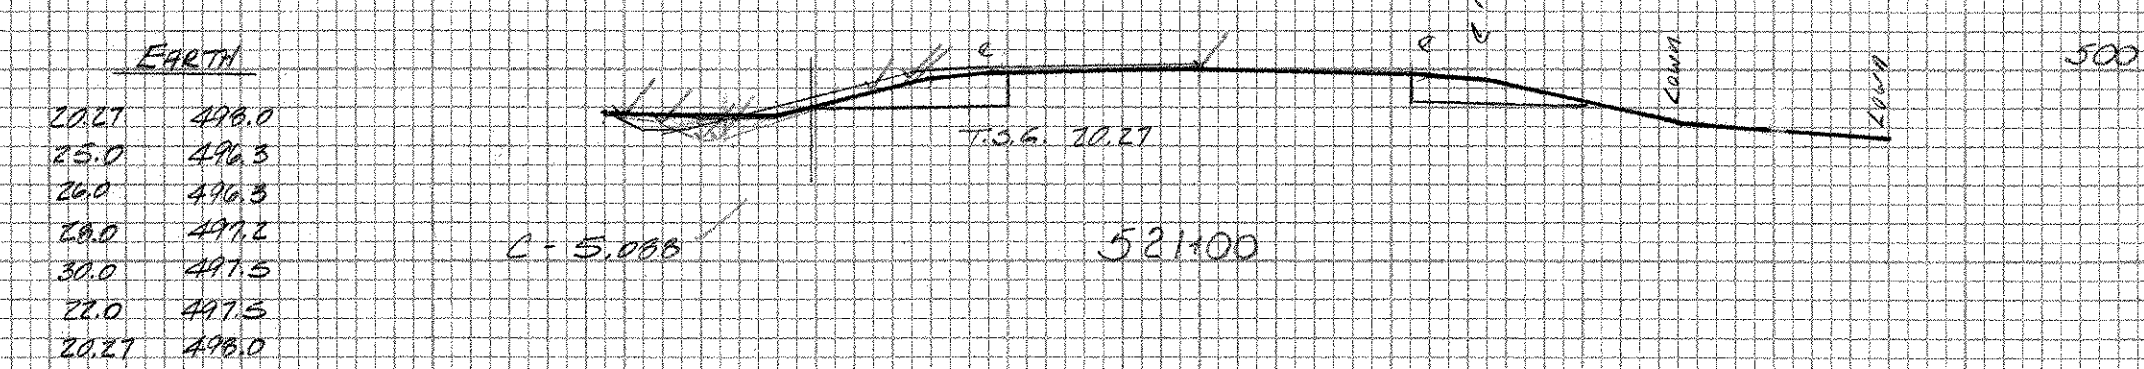
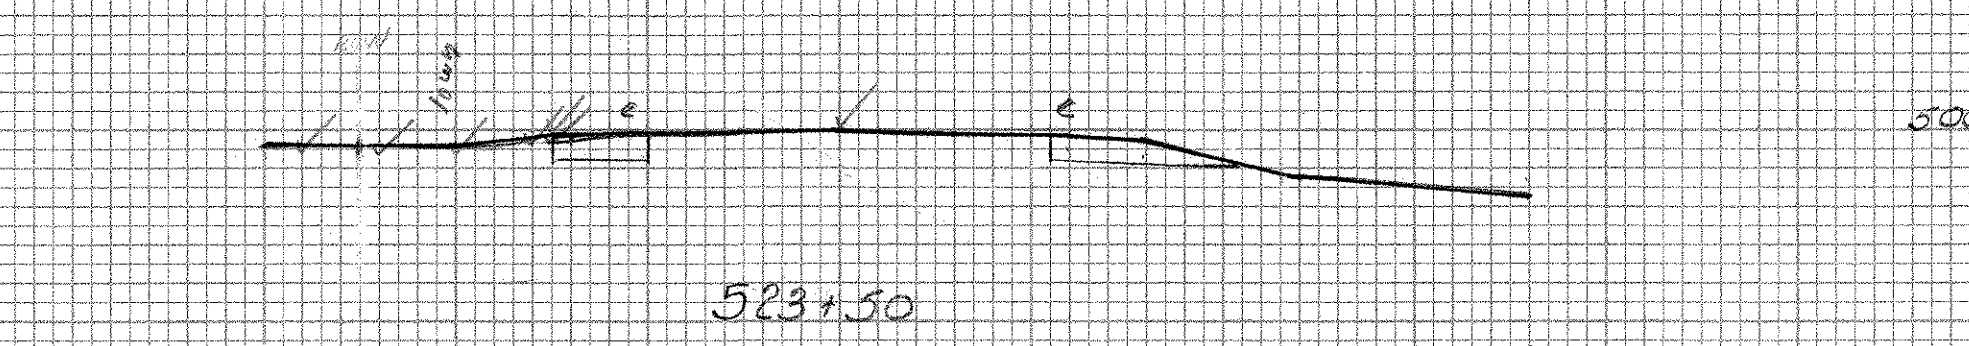
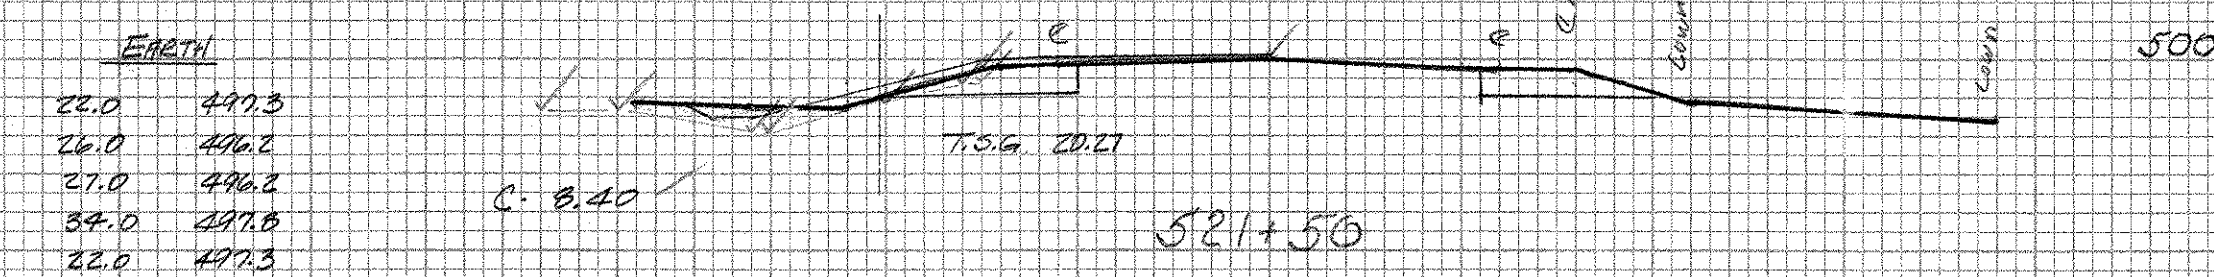
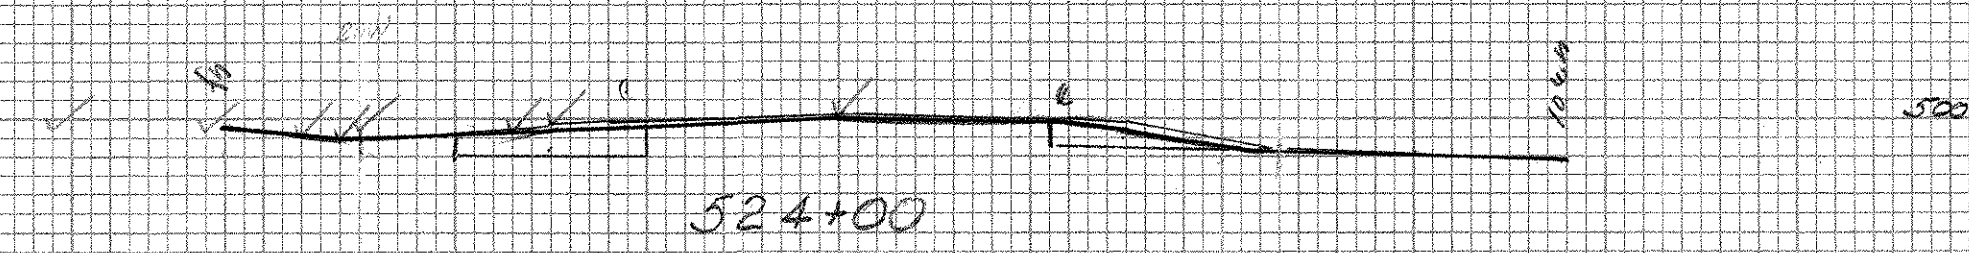


DATE	
BY	
BURVEYED	
PLOTTED	
NOTED	
AREAS CHECKED	
FINAL SURVEY NOTE BOOK No.	

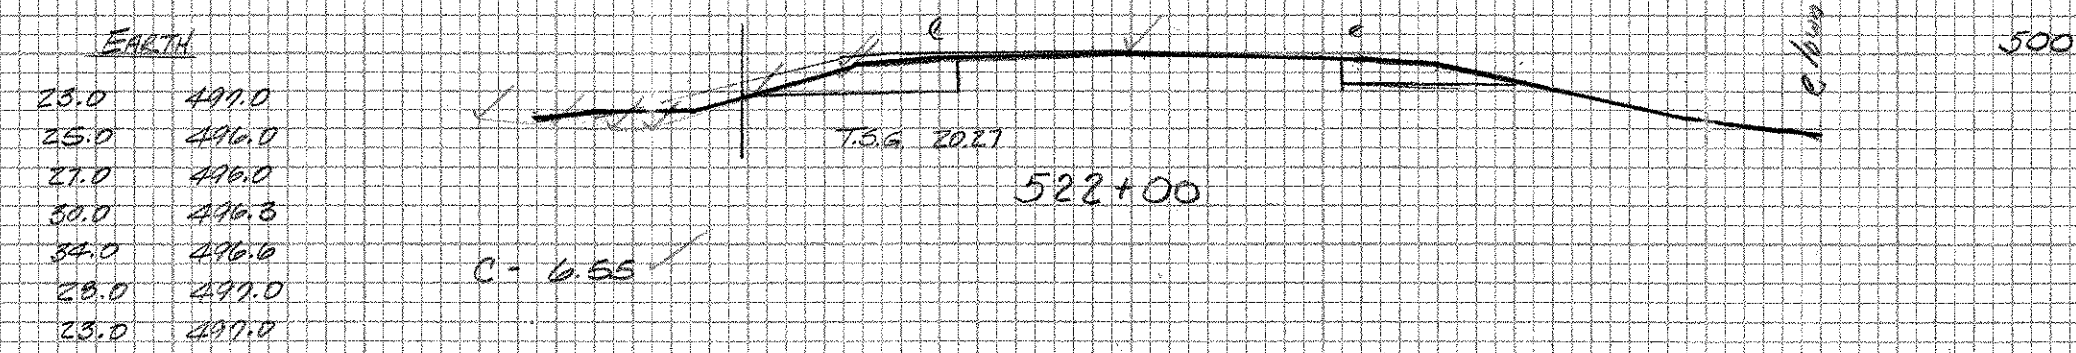

SHOREHAM BRIDGPORT ADDITION  
FOIT-1 (2)

Original Sections  
Pinned 1/24 2/25/22

520+50 ~ 524+00  
SHEET 412-C OF 477