
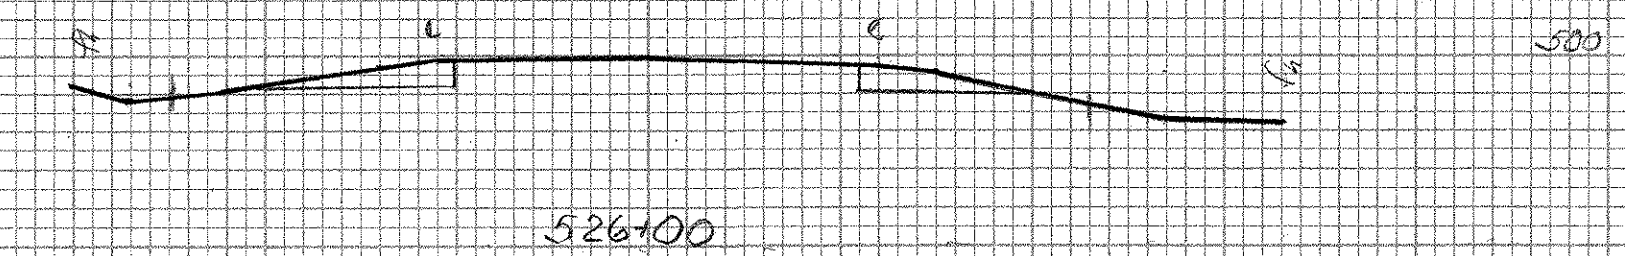
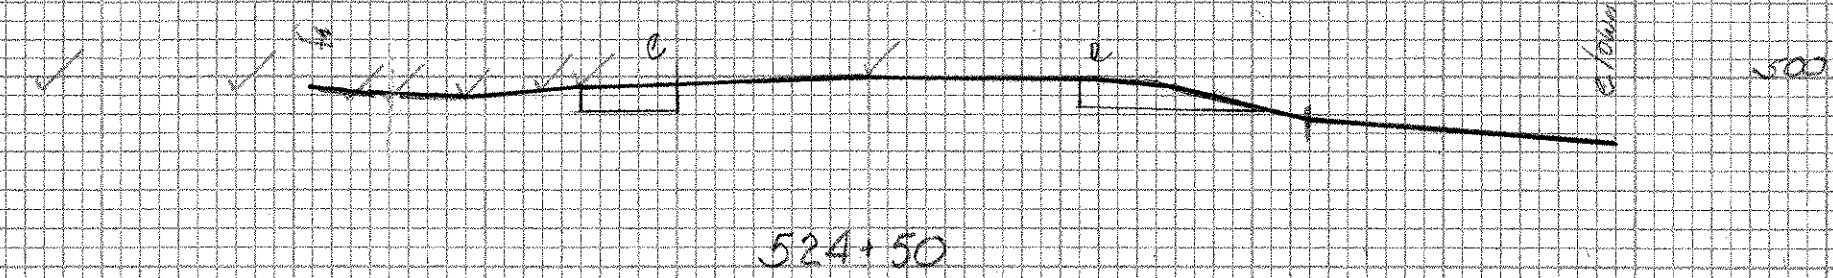
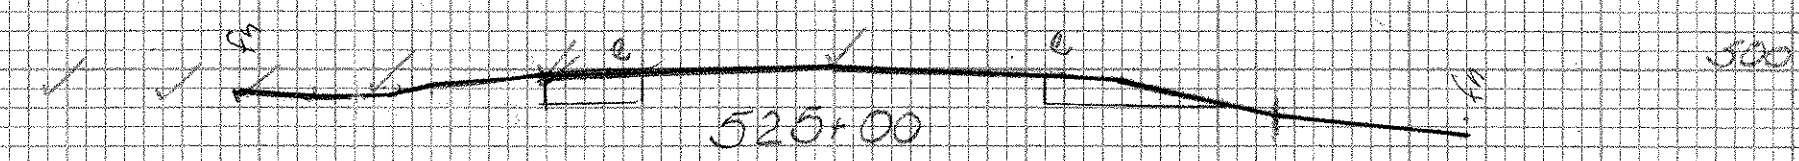
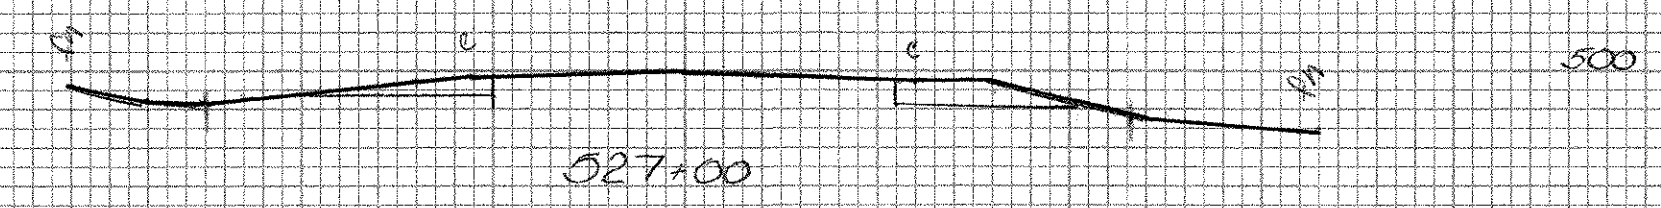
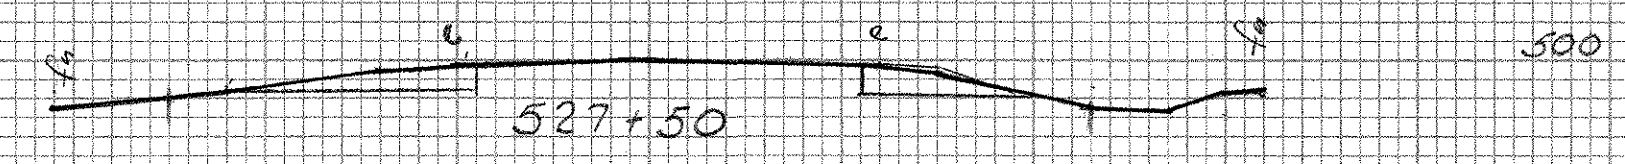
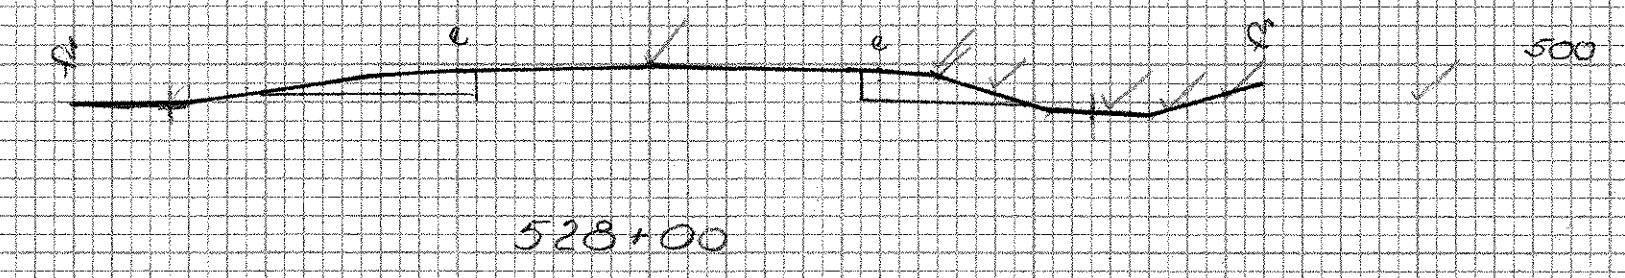


DATE	
BY	
SURVEYED	
PLOTTED	
NOTED	
AREAS CHECKED	
NO.	

DATE	
BY	
SURVEYED	
PLOTTED	
NOTED	
AREAS CHECKED	
NO.	

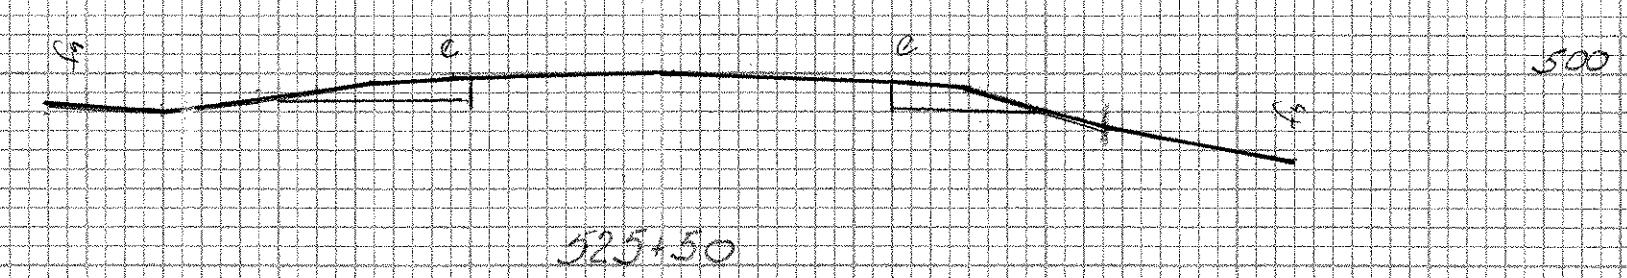

SHOREHAM-BRIDPORT ADDIS ON
FO17-1 (2)

Original Sections
PLATE 1410 BLSW

524+50 ~ 528+00

SHEET 412-D OF 477