




EARTH	
25.0	498.2
26.0	496.9
27.0	496.9
28.0	497.5
29.0	498.6

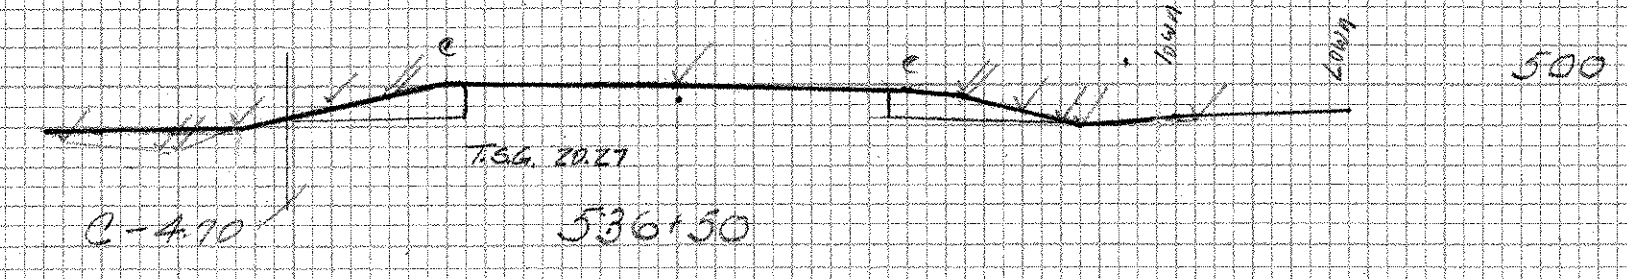


EARTH	
26.0	498.0
27.0	496.9
28.0	496.9
29.0	497.7
30.0	497.7
31.0	498.0

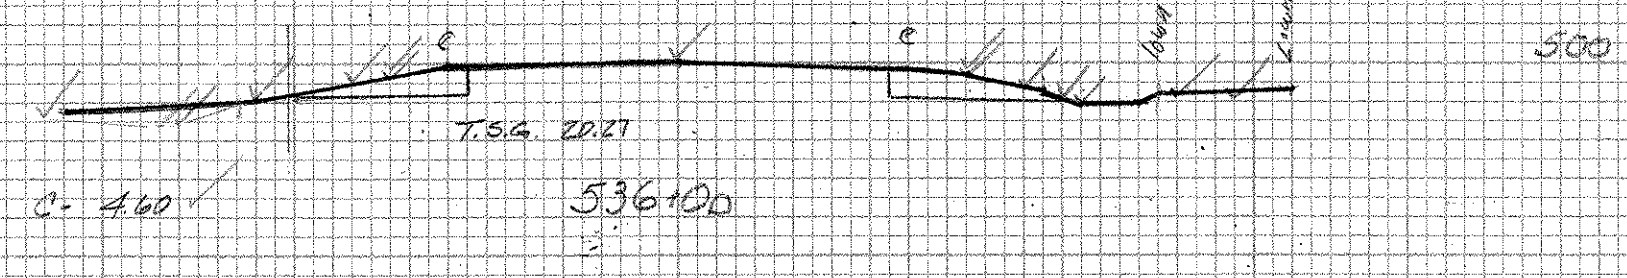


EARTH	
20.27	498.6
21.0	498.1
22.0	498.7
23.0	498.7
24.0	498.7
25.0	498.0
26.27	498.6

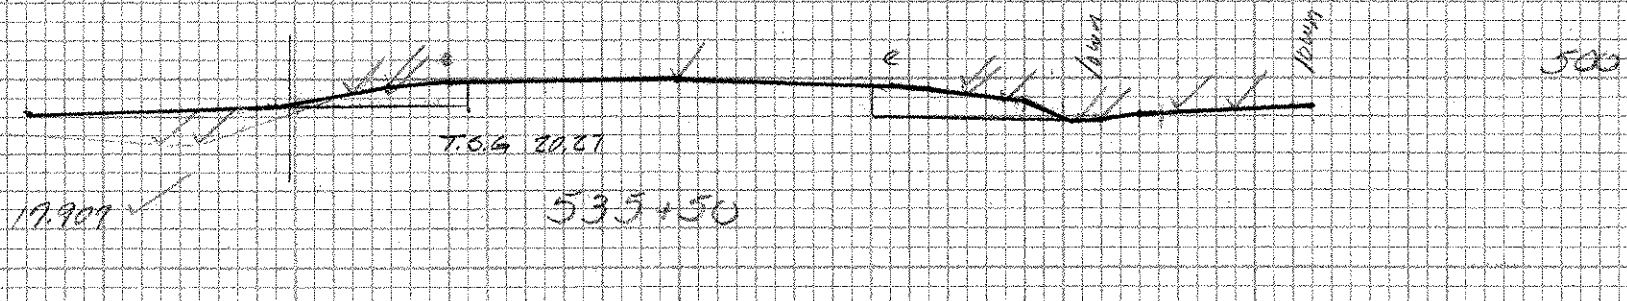


EARTH	
21.0	498.3
25.0	497.3
27.0	497.5
28.0	497.5
34.0	497.6
21.0	498.3

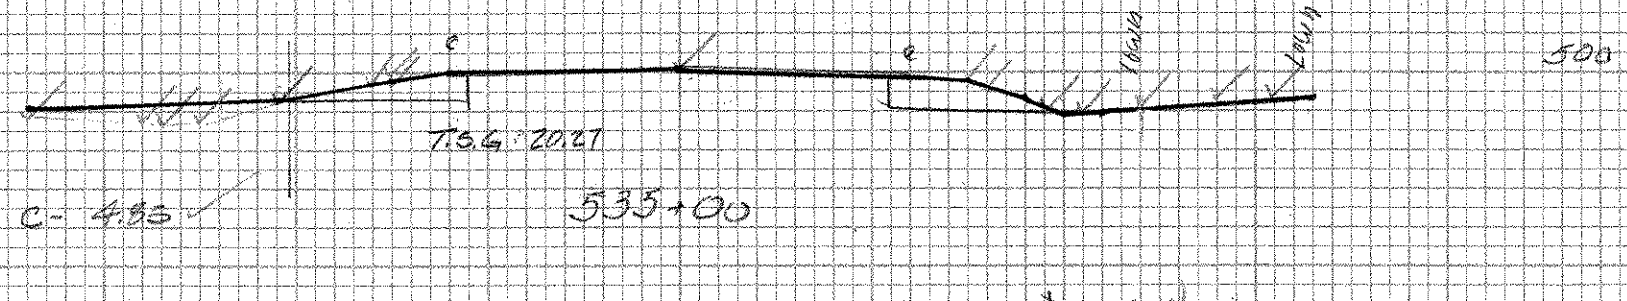


EARTH	
20.27	497.0
21.0	496.4
23.0	497.8
24.0	498.8
25.0	498.1
26.0	498.6
28.27	499.0

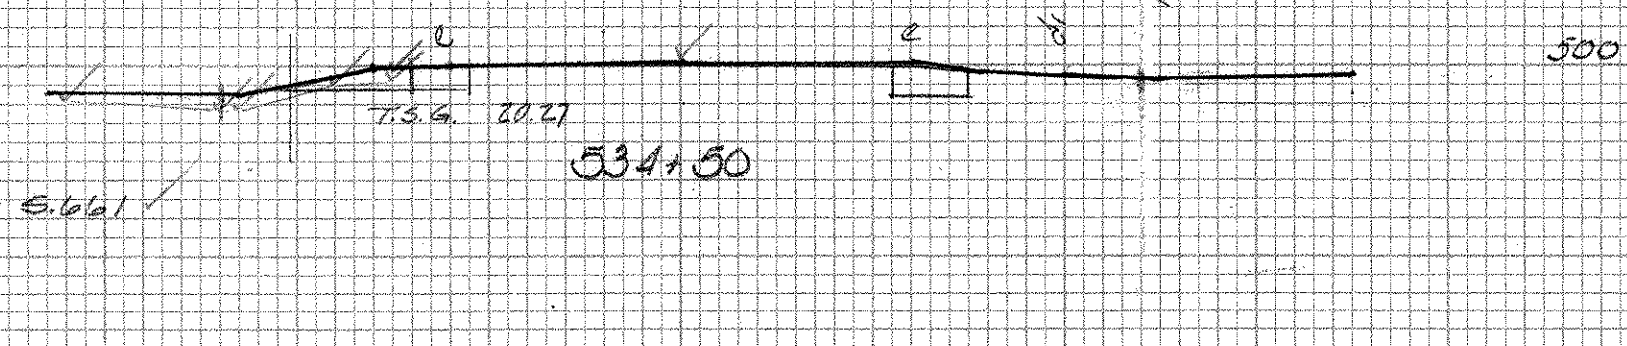


EARTH	
16.0	499.0
23.0	498.8
24.0	498.3
27.0	498.5
16.0	499.0

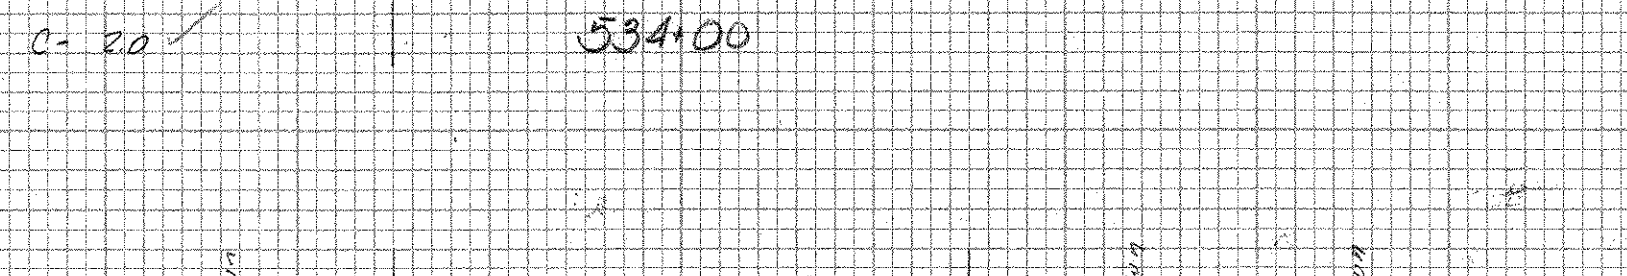


EARTH	
16.0	497.7
16.0	497.8
17.0	497.1
21.0	498.5
22.0	498.5
23.0	498.7
25.0	497.7
16.0	497.7

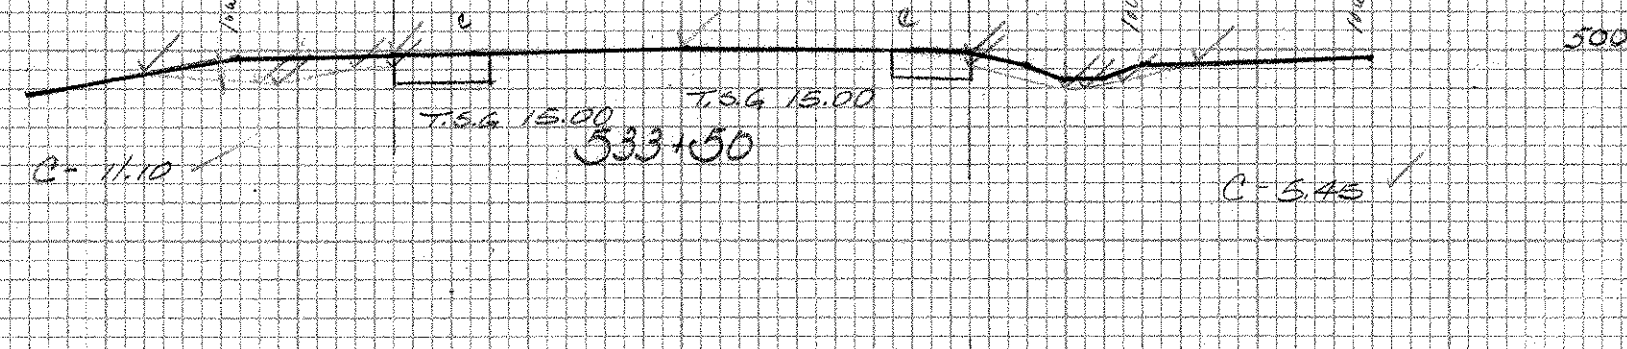


EARTH	
15.0	499.2
16.0	499.0
20.0	498.1
21.0	498.1
24.0	498.5
15.0	499.2

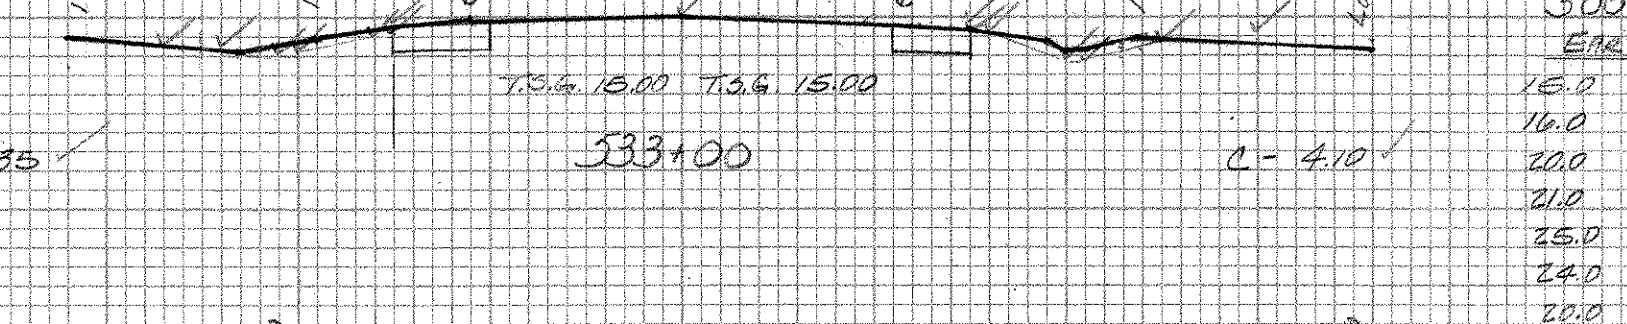


EARTH	
15.0	499.2
16.0	499.1
20.0	499.8
21.0	497.8
25.0	498.8
24.0	499.0
20.0	498.5
19.0	498.5
15.0	499.2

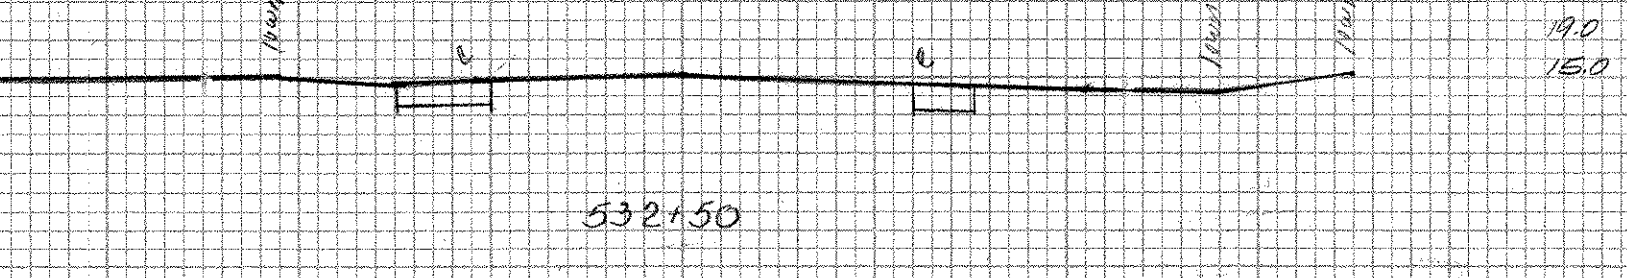


EARTH	
25.5	499.6
27.0	498.7
28.0	498.7
38.0	498.3
25.5	499.6

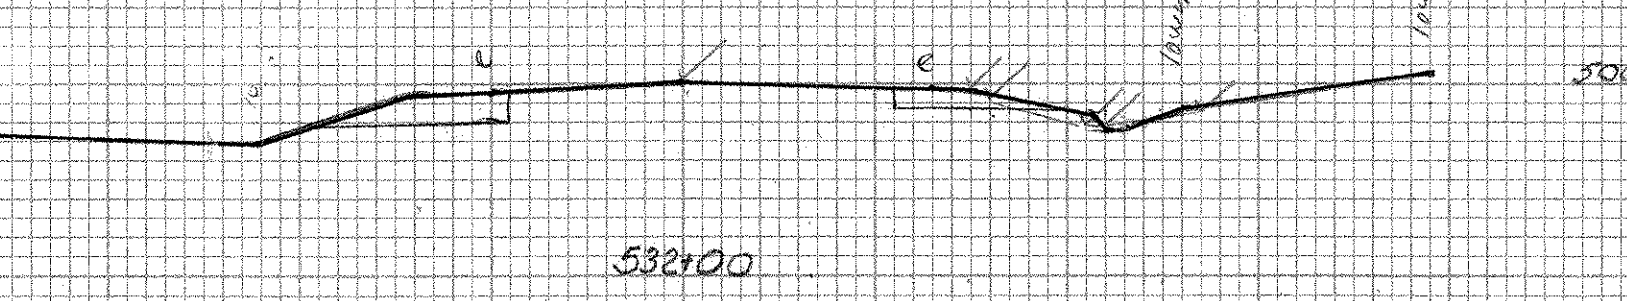


EARTH	
28.0	498.3
27.0	497.6
29.0	497.6
37.0	498.2
28.0	498.3

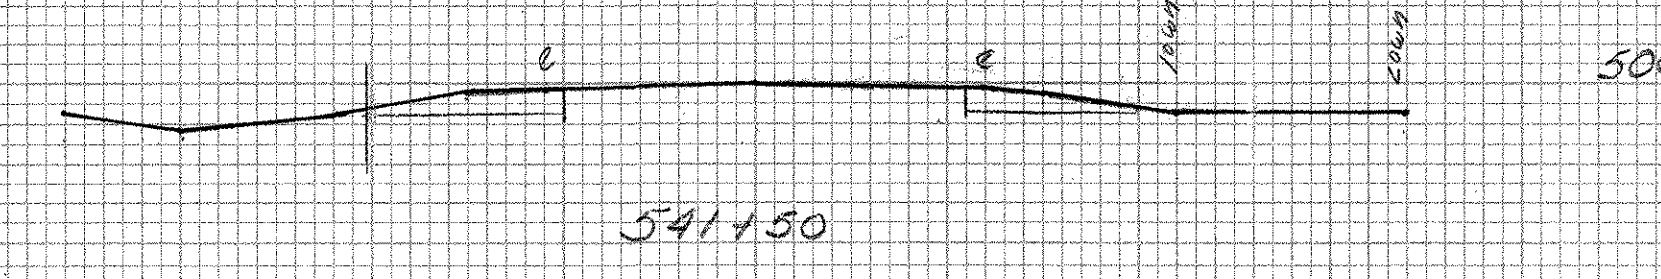


EARTH	
20.27	498.6
26.0	498.4
27.0	497.6
28.0	497.7
29.0	497.7
38.0	498.0
20.27	498.6

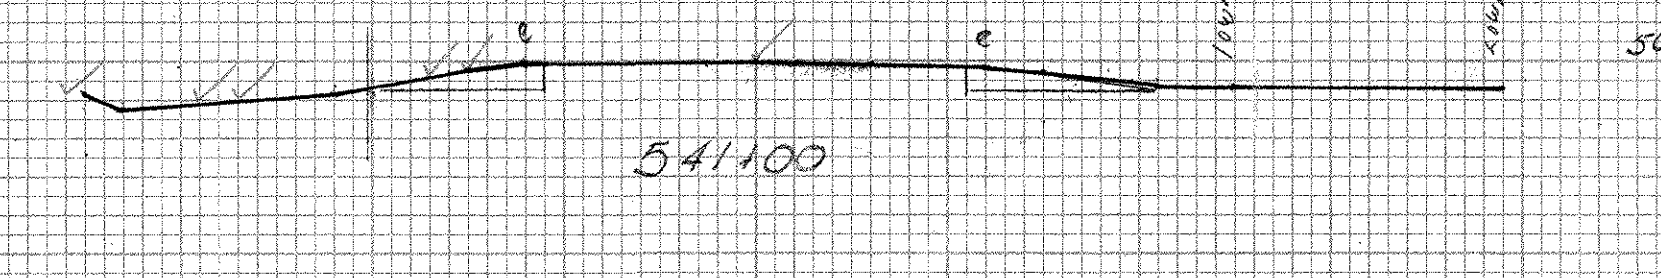


EARTH	
24.0	498.3
27.0	497.6
28.0	497.6
38.0	498.2
24.0	498.3

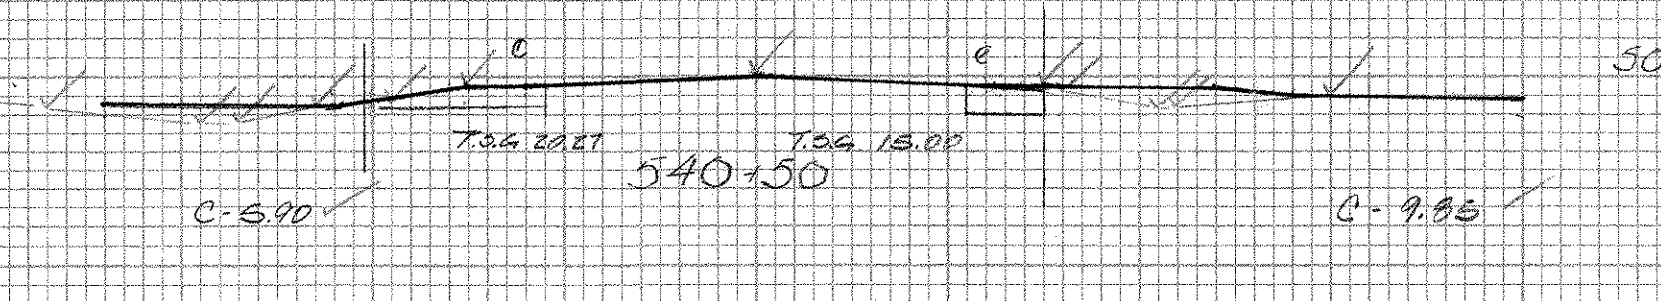


EARTH	
23.0	498.4
25.0	498.0
26.0	497.5
30.0	497.5
36.0	498.5
27.0	498.5
33.0	498.4

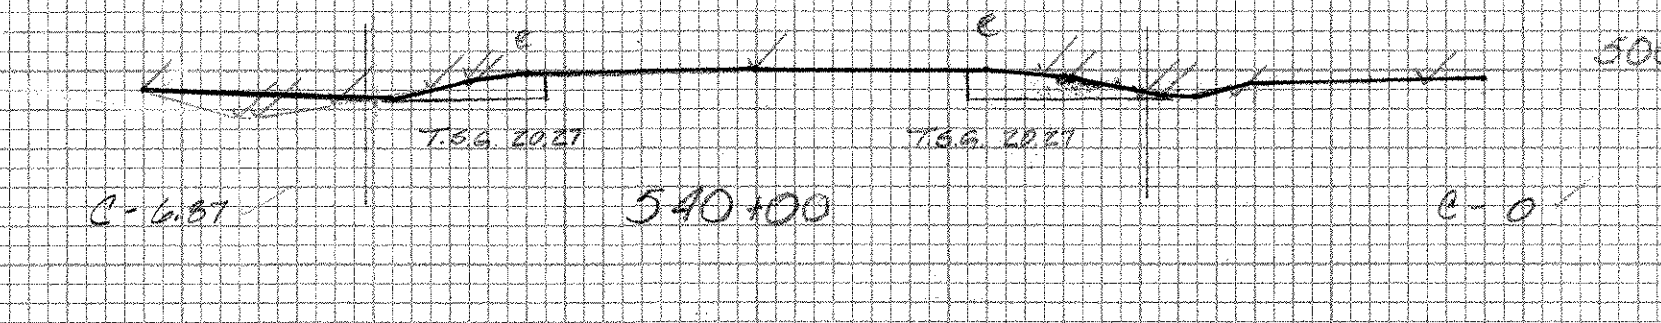


EARTH	
15.0	497.7
15.0	497.8
20.0	498.0
21.0	498.0
25.0	498.5
27.0	498.5
28.0	498.5
28.0	498.5
20.0	498.5
15.0	497.7

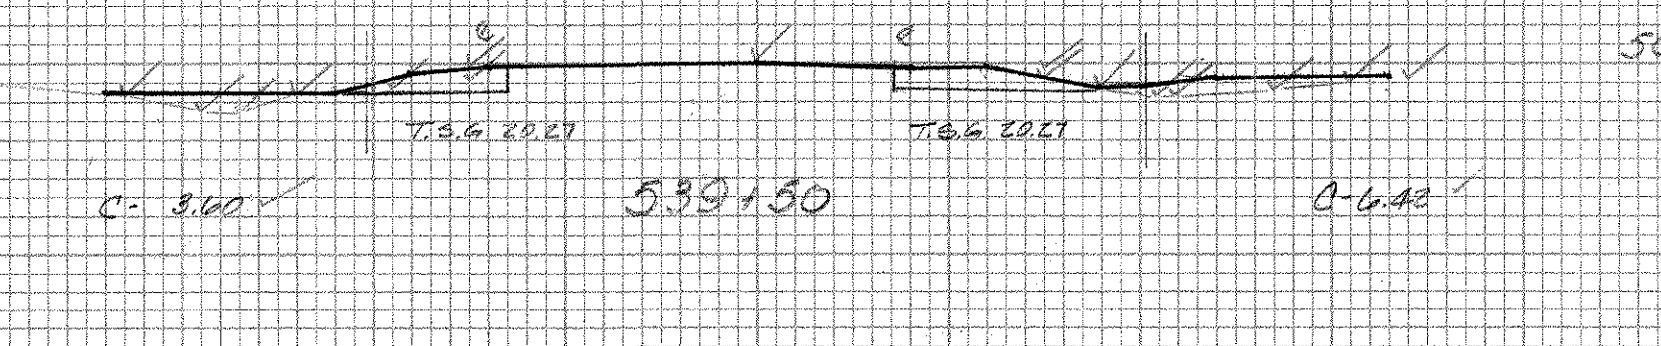




EARTH	
25.0	498.0
26.0	497.3
29.0	497.3
25.0	498.0

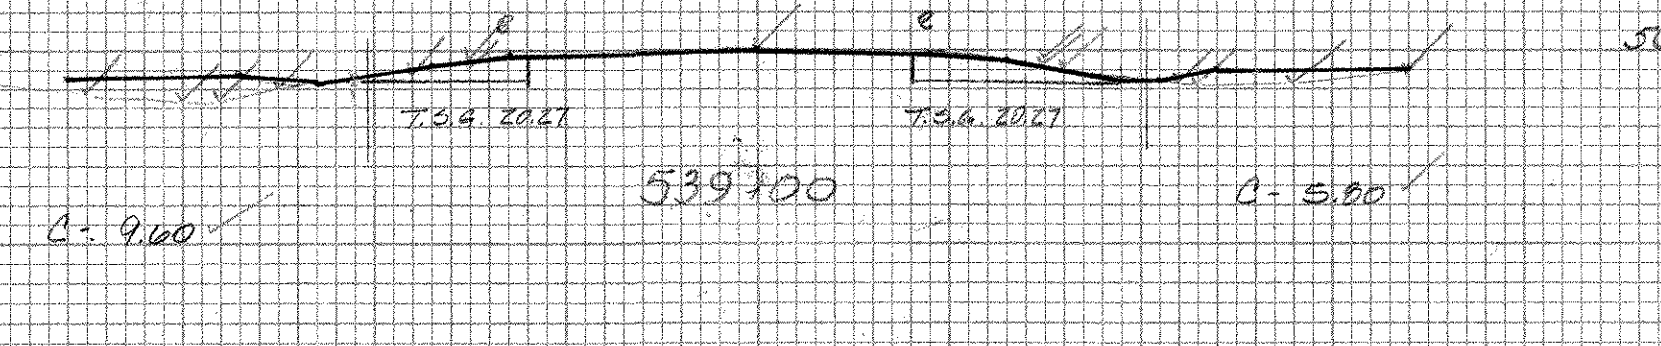

EARTH	
25.5	499.6
27.0	498.7
28.0	498.7
38.0	498.3
25.5	499.6

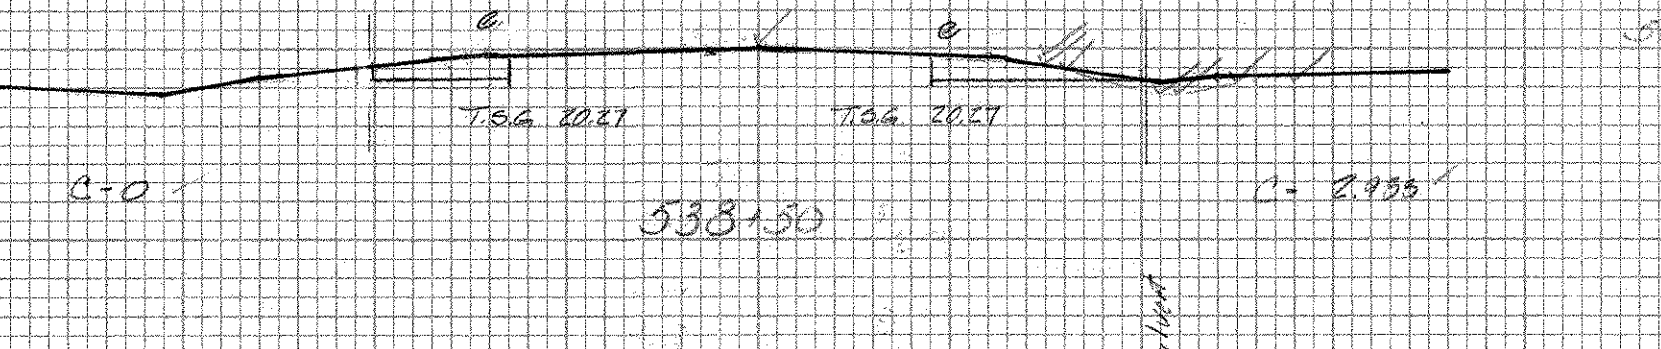

EARTH	
25.5	499.6
27.0	498.7
28.0	498.7
38.0	498.3
25.5	499.6

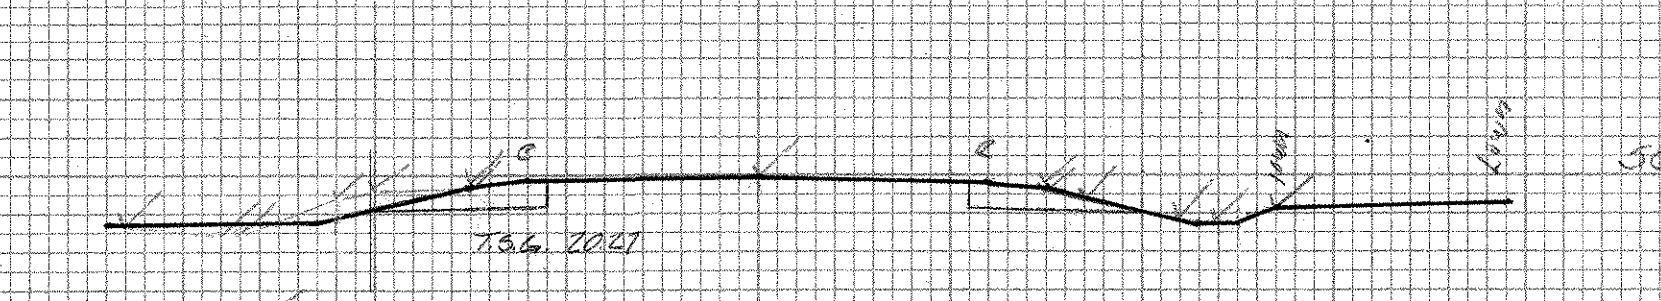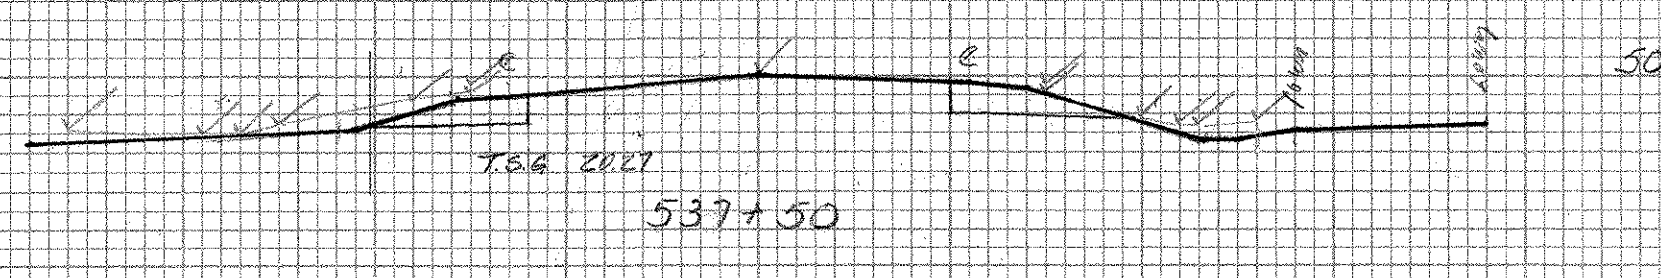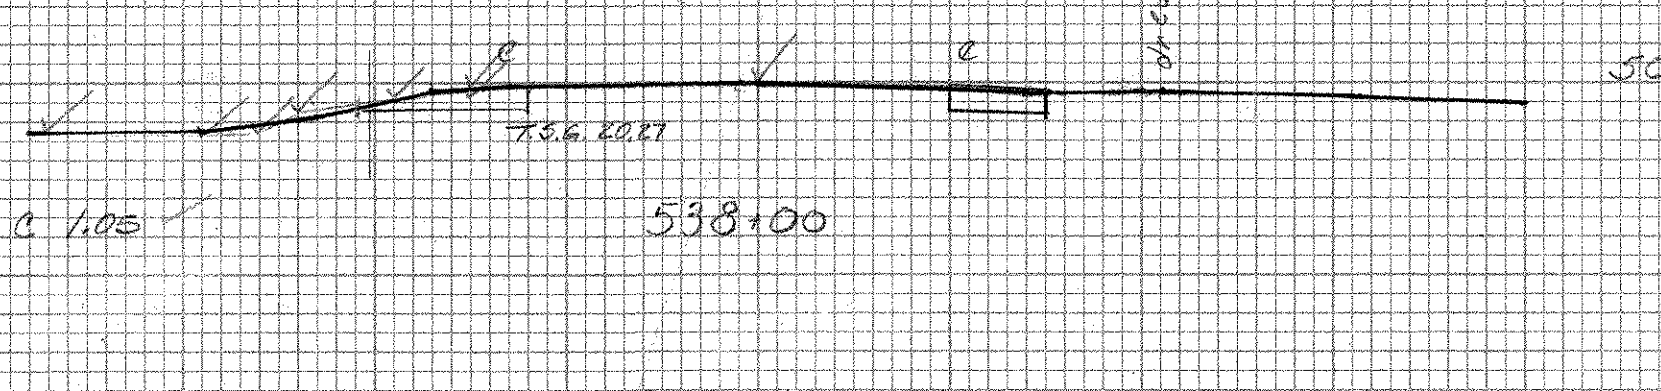

EARTH	
15.0	499.6
16.0	499.5
21.0	498.4
22.0	498.4
30.0	498.9
24.0	499.5
15.0	499.6

EARTH	
20.27	499.0
20.27	498.8
21.0	498.8
22.0	498.8
27.0	498.7
31.0	499.0
34.0	499.1
24.0	499.2
20.27	499.0

EARTH	
21.0	498.4
22.0	498.4
23.0	498.1
28.0	498.4
38.0	498.9
24.0	499.0
21.0	498.4

EARTH	
20.27	497.8
21.0	497.7
22.0	497.7
25.0	498.2
26.0	498.2
28.0	498.5
31.0	498.3
20.27	497.8
20.27	497.5

SHOREHAM-BRIDPORT-ADDIS ON
FOIT-1(2)

Original Sections

532+00 ~ 541+00