


DATE	
BY	
REVIEWED	
PLOTTED	
TEMPERATURE	
NO. OF AREAS CHECKED	
FINAL SURVEY NOTE BOOK NO.	

DATE	
BY	
REVIEWED	
PLOTTED	
TEMPERATURE	
NO. OF AREAS CHECKED	
ORIGINAL SURVEY NOTE BOOK NO.	

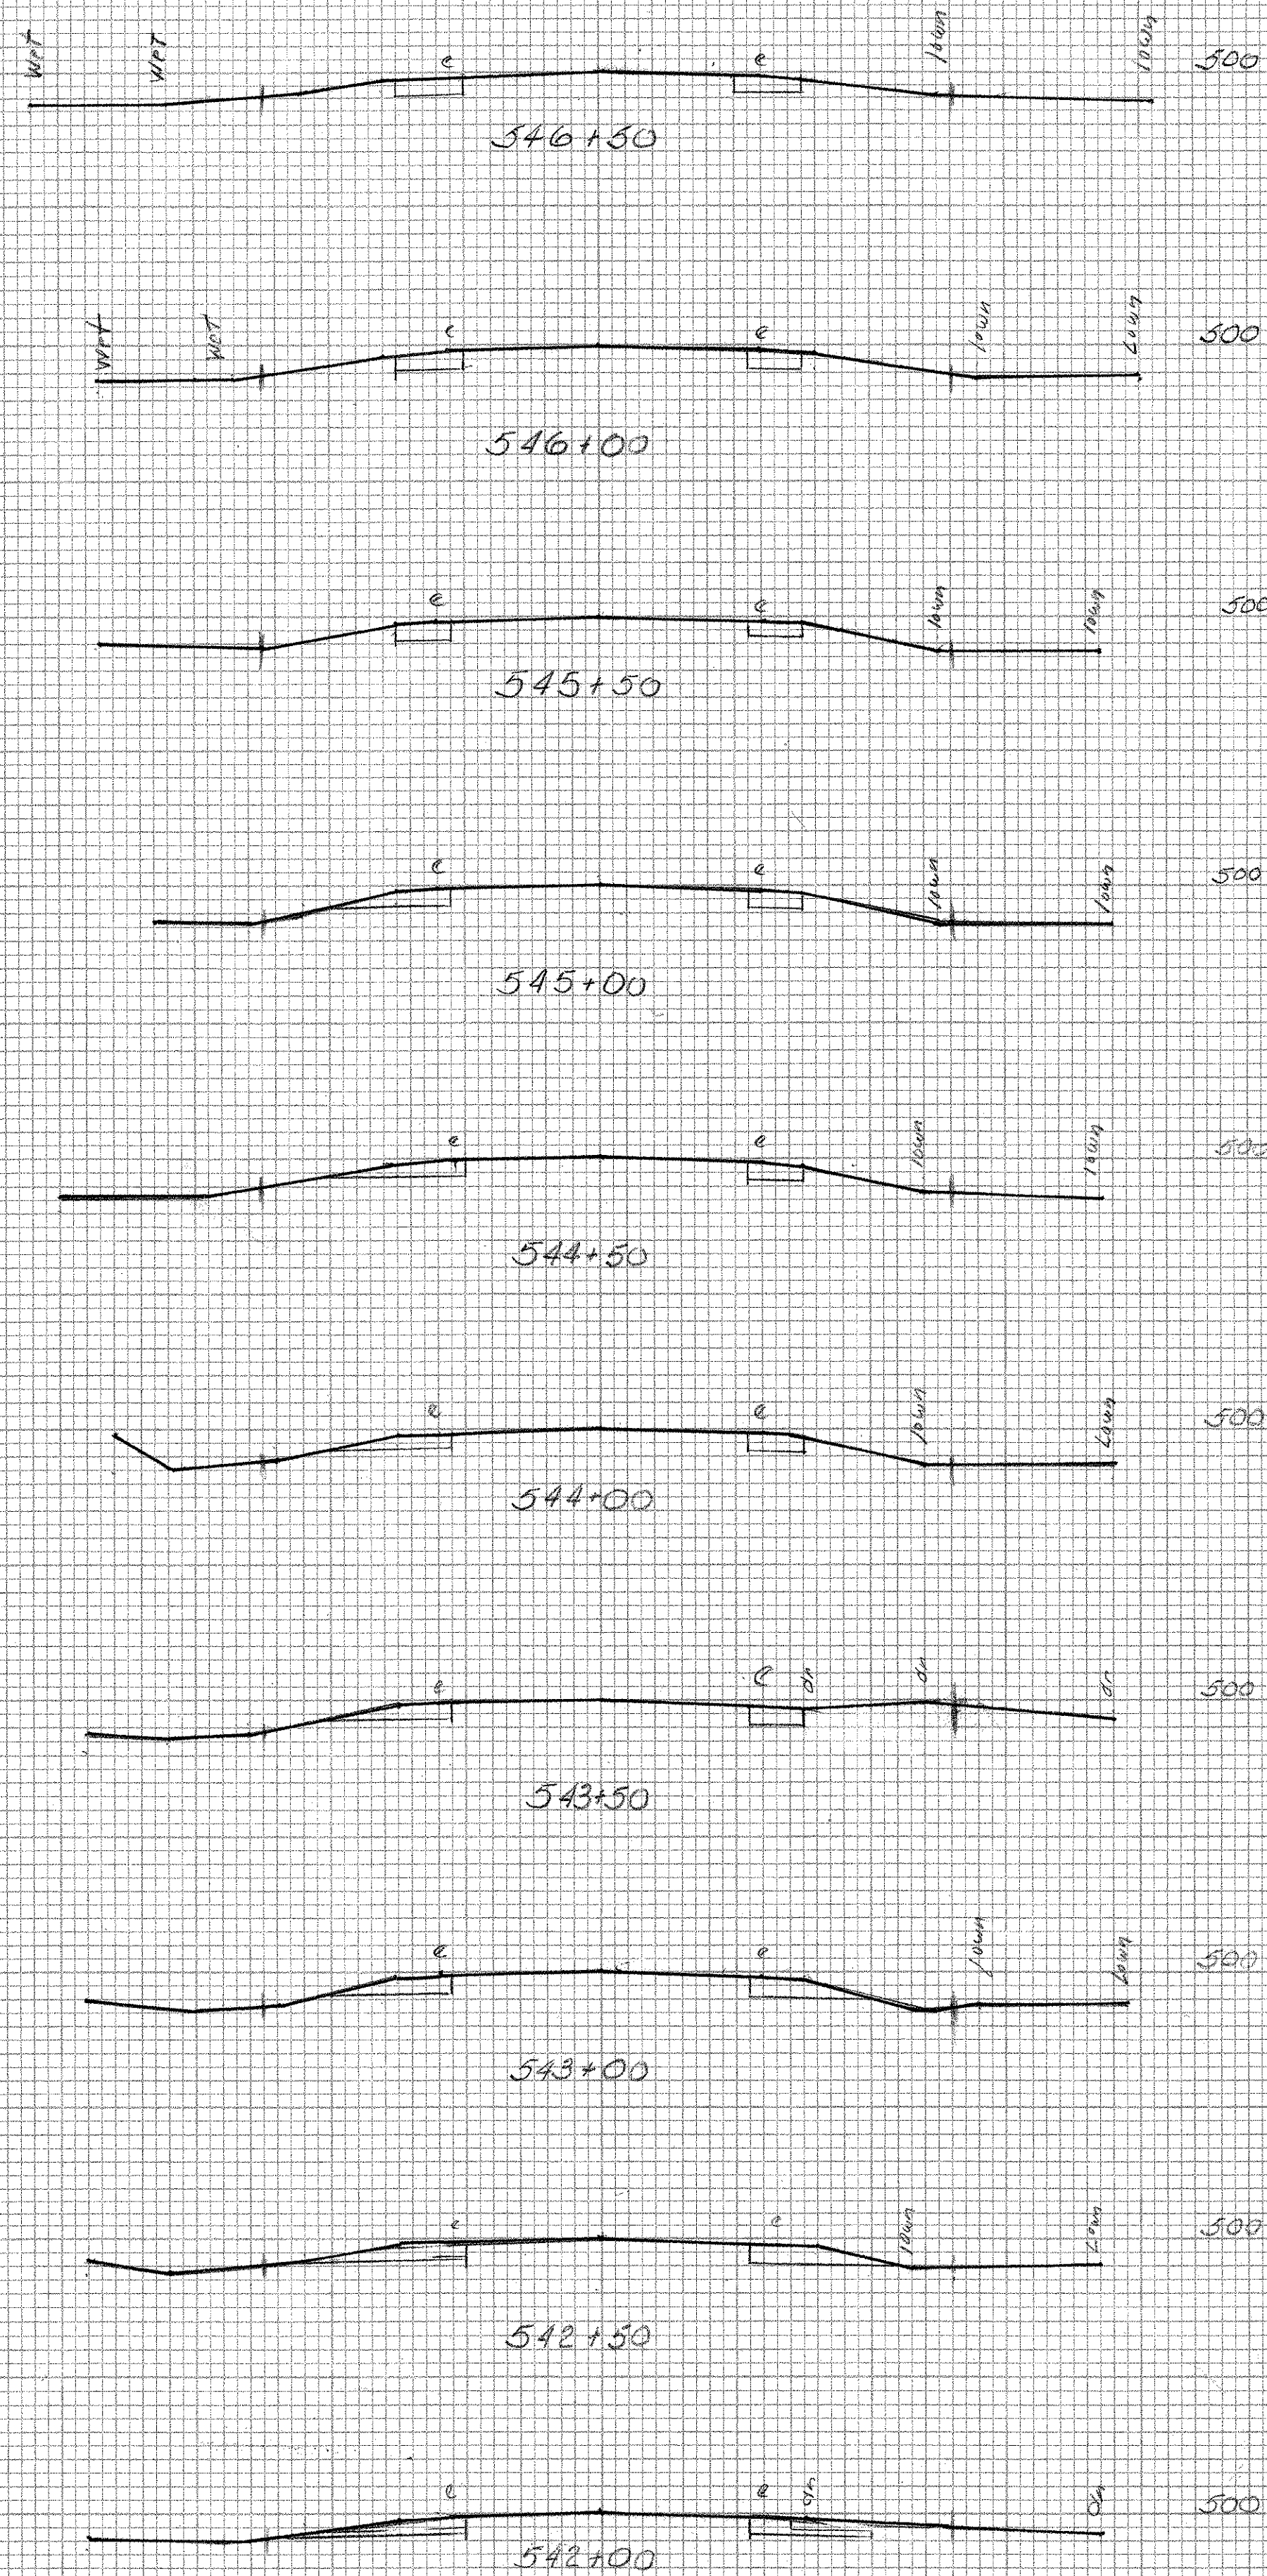

SHOREHAM-BRIDPORT-ADDIS DN
F 017-1 (2)

Original Sections

1/11/52 R/S/S/H

542+00 ~ 548+00
SHEET 412-G OF 477