



279+50

330

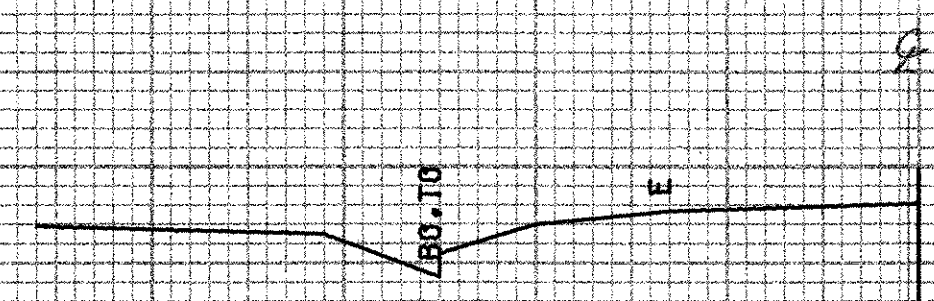


279+21

330

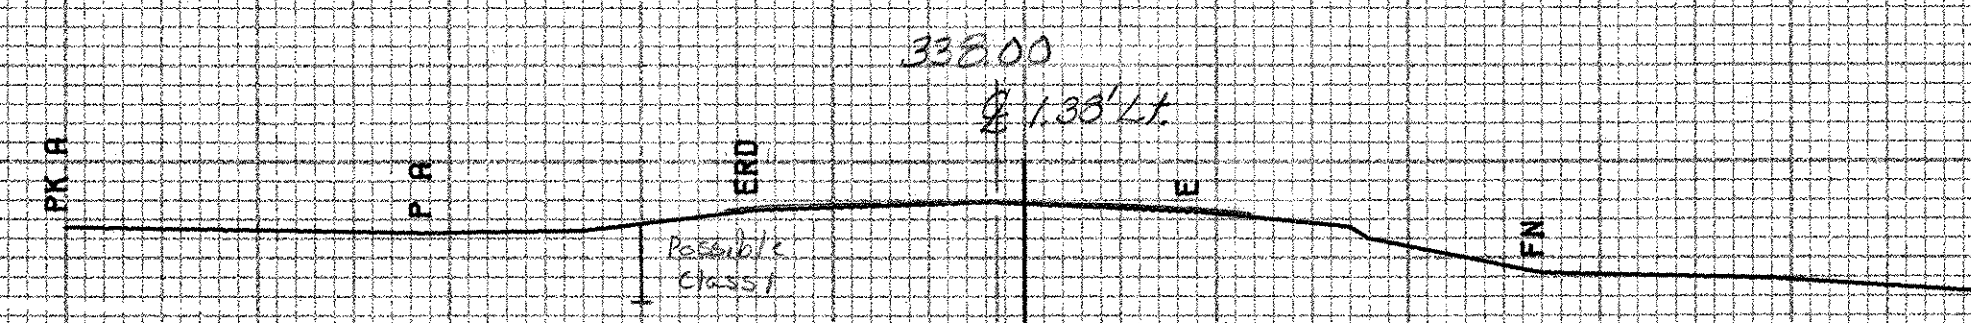

279+00
END APPROACH

330

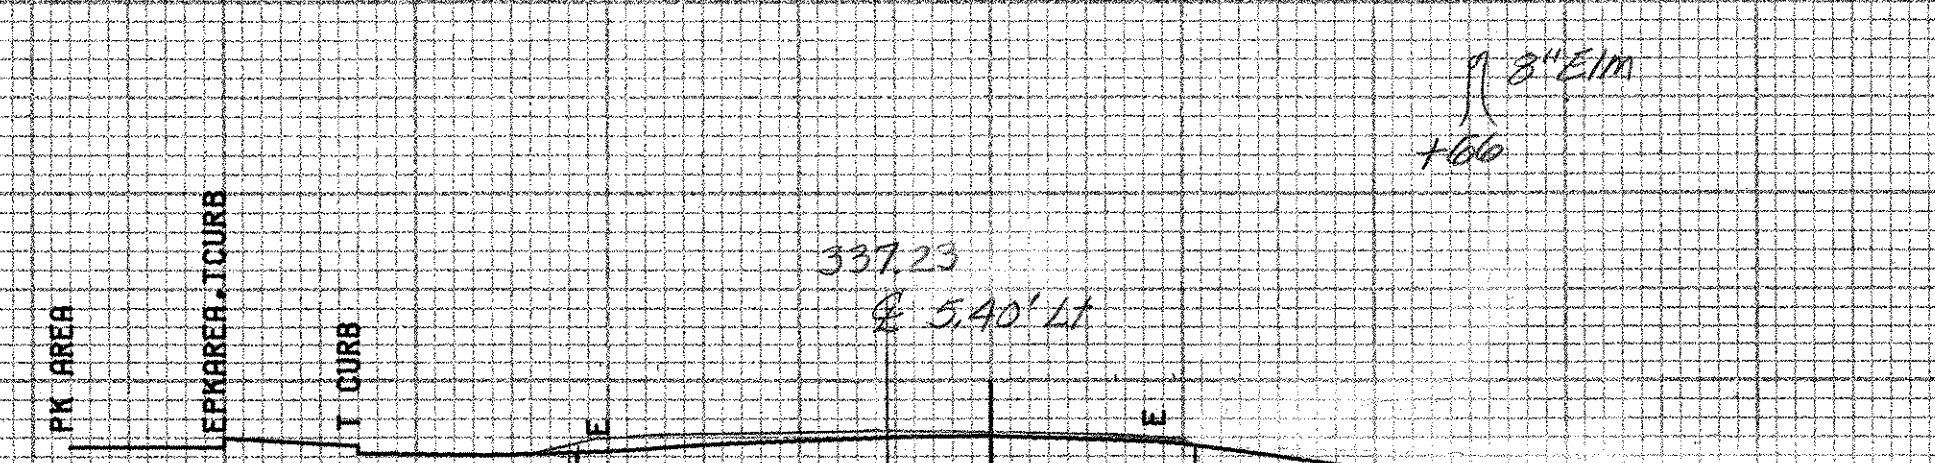

278+50
END FULL DEPTH SLEWAGE
BEGIN APPROACH

330

Vic. Rte. # 125 East

FROM STA.	278+50	TO STA.	279+50
PROJECT NAME	SHOREHAM-BRIDPORT-ADDISON EAST		
NO.	F017-1(2)	PLOTTED	04/15/85
SURVEYED BY	BUSHEY	FEB 1985	
SHEET	414	OF 430 SHEETS	SHEET 414 OF 417

SCALE 1" = 10 FEET