



NO.	DATE	BY	REVISIONS
1			
2			
3			
4			
5			

NO.	DATE	BY	REVISIONS
1			
2			
3			
4			
5			

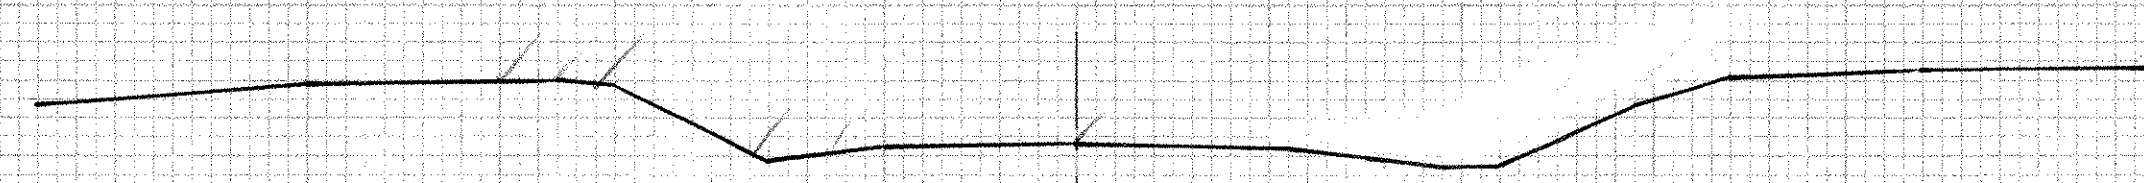


271+0

270

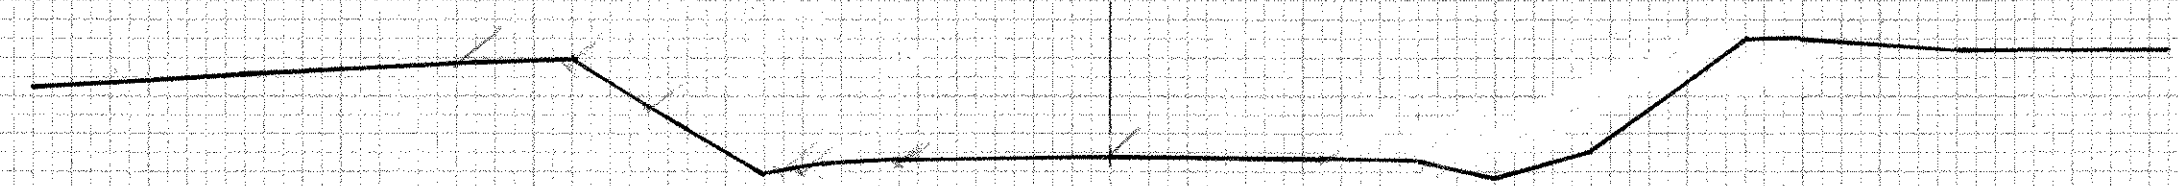


270+50

270

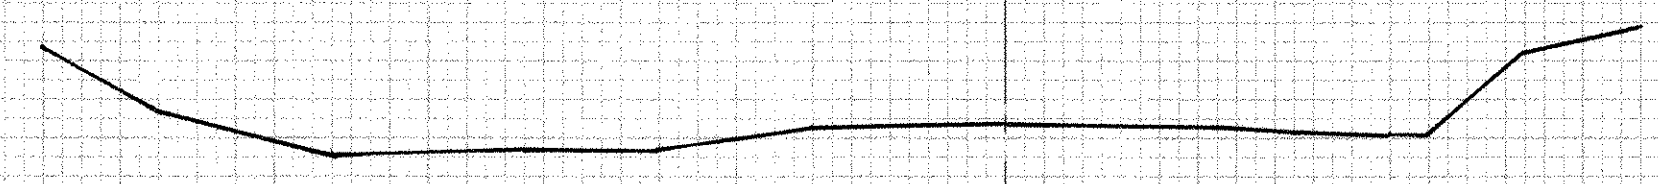

270+0

260

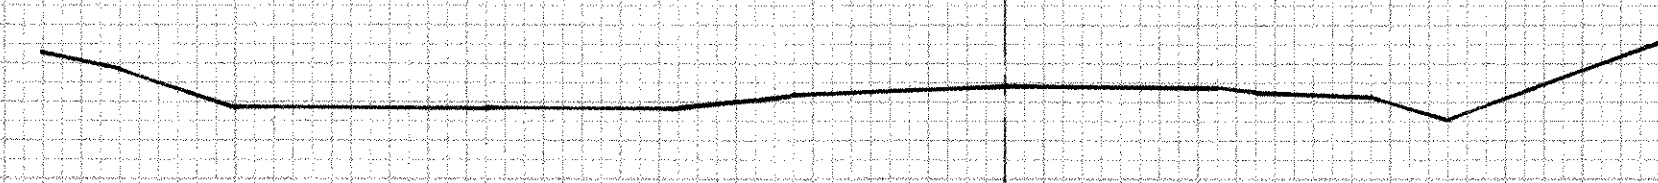

269+50

250

2

2

VT. RTE. 125 WEST  
 SHOREHAM-BRIDPORT-ADDISON  
 F017-11(2)  
 269+50 - 271+0 415-A OF 417