


DATE	BY	REVISIONS	APPROVED

DATE	BY	REVISIONS	APPROVED

EARTH

33.0	302.0
36.0	302.3
37.0	302.3
41.0	302.0
55.0	302.0

5.40

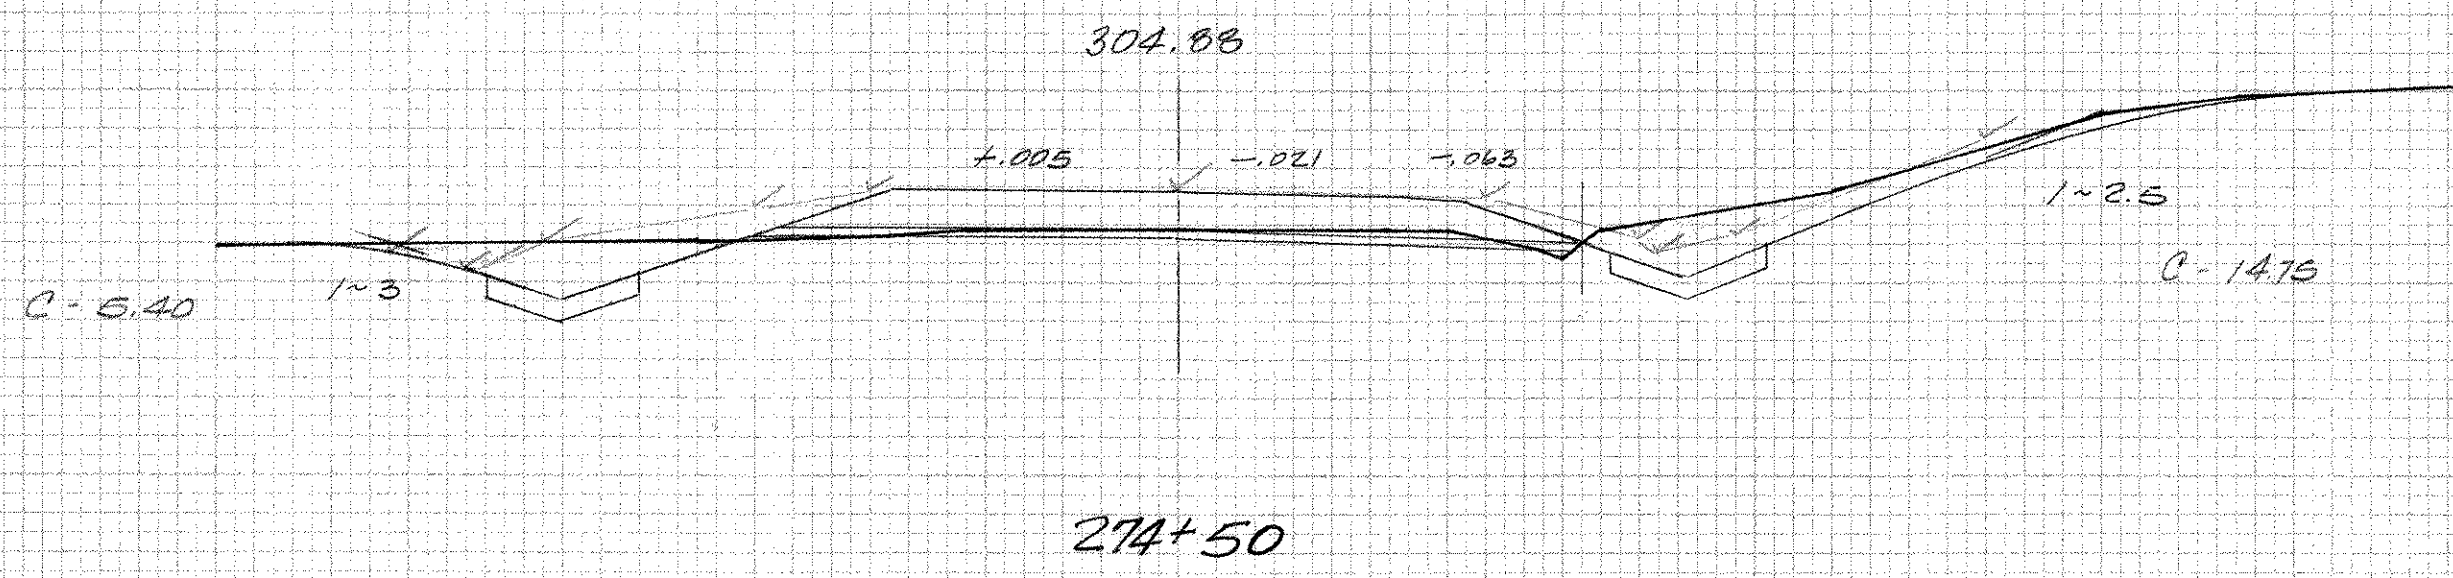

EARTH

27.0	302.5
24.0	302.2
25.0	301.7
26.0	301.7
29.0	302.5
38.0	302.7
34.0	304.8
22.0	302.6


14.75

300

EARTH

23.4	299.5
23.4	298.5
25.0	298.0
29.0	297.1
31.0	297.1
34.0	298.0
25.0	297.7
23.4	299.5

13.92

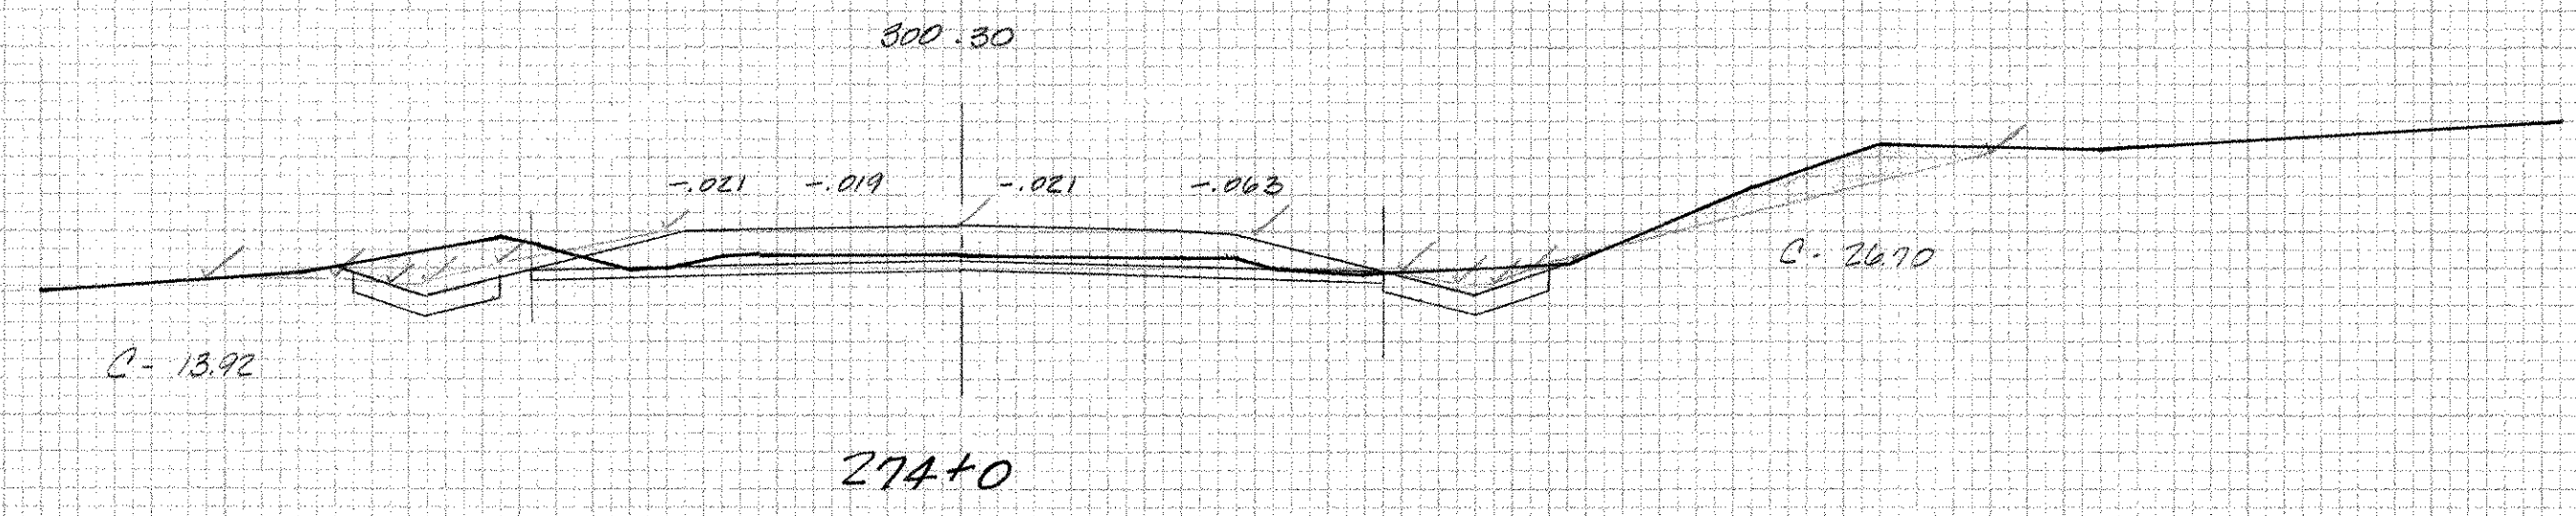

EARTH

25.0	297.9
24.0	297.9
27.0	297.2
29.0	297.2
31.0	297.9
26.0	304.2
29.0	302.8
33.0	295.2
23.0	297.9


26.70

300

EARTH

24.0	296.5
24.0	294.1
27.0	292.7
28.0	292.7
34.0	294.9
41.0	297.1
27.0	297.6
25.0	296.9
24.0	296.3

45.40

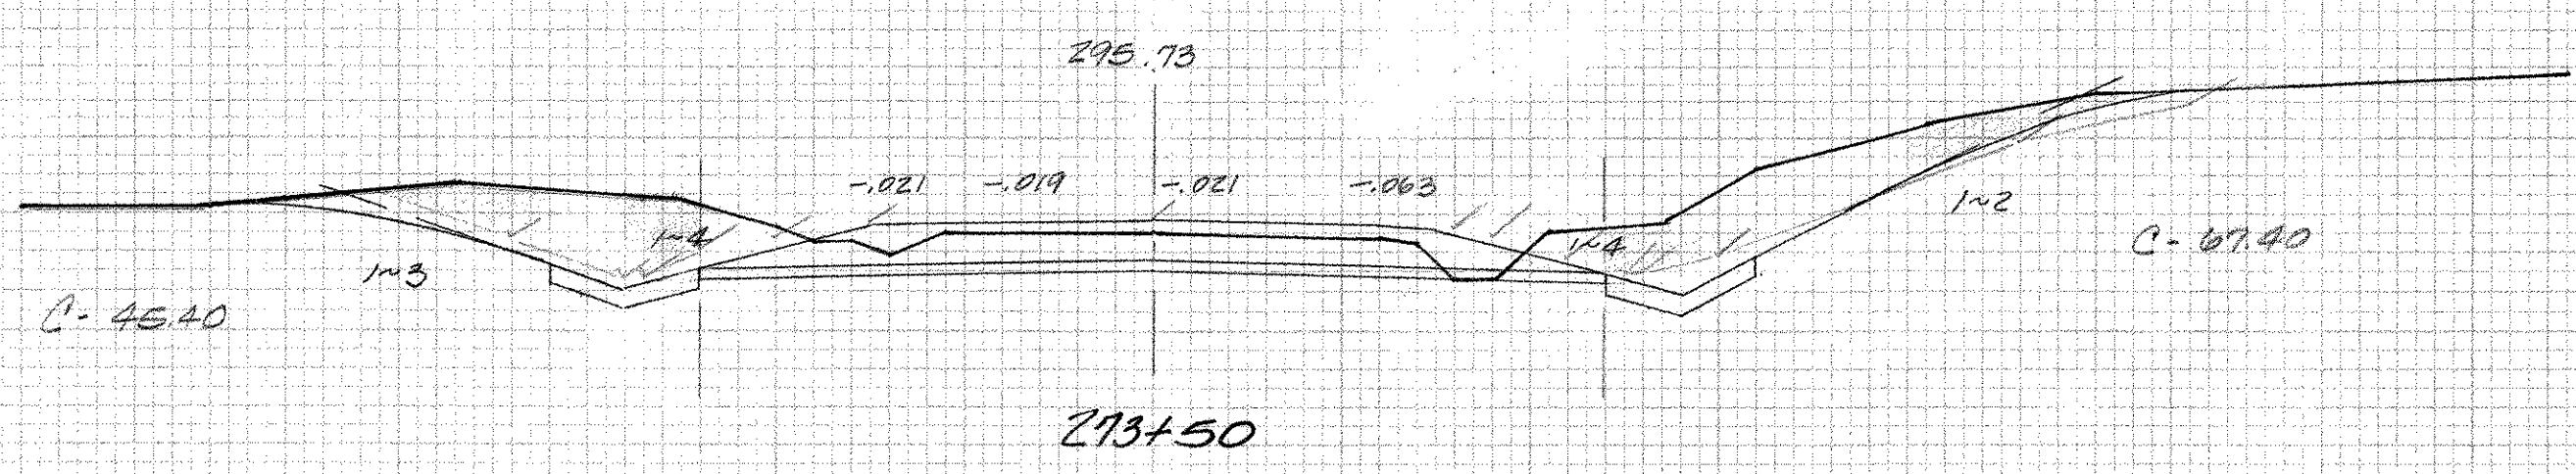

EARTH

24.0	295.2
24.0	293.0
26.0	293.0
32.0	293.8
35.0	297.0
48.0	301.0
24.0	302.6
33.0	302.6
41.0	300.7
32.0	298.2
27.0	295.6
24.0	295.2

67.40

300

VT Rte. 125 WEST  
 SHOREHAM-BRIDPORT-ADDISON  
 FO17-1(2)  
 273+50 - 274+50 47 of 420