



NO.	DATE	BY	REVISIONS
1			
2			
3			
4			
5			

NO.	DATE	BY	REVISIONS
1			
2			
3			
4			
5			

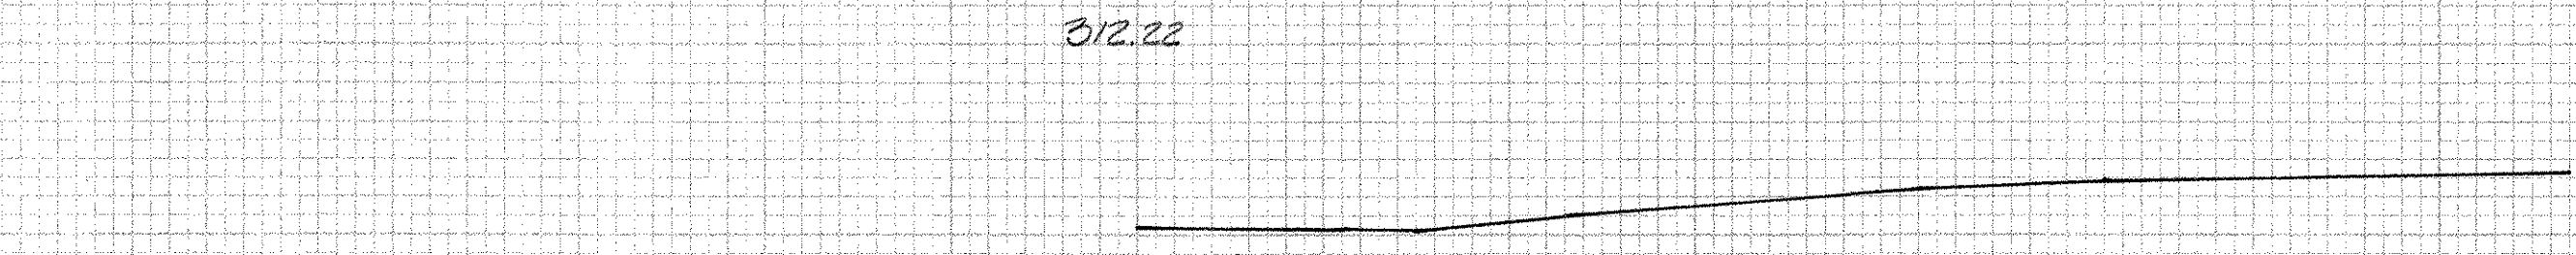

~~375+32~~
275+32


310

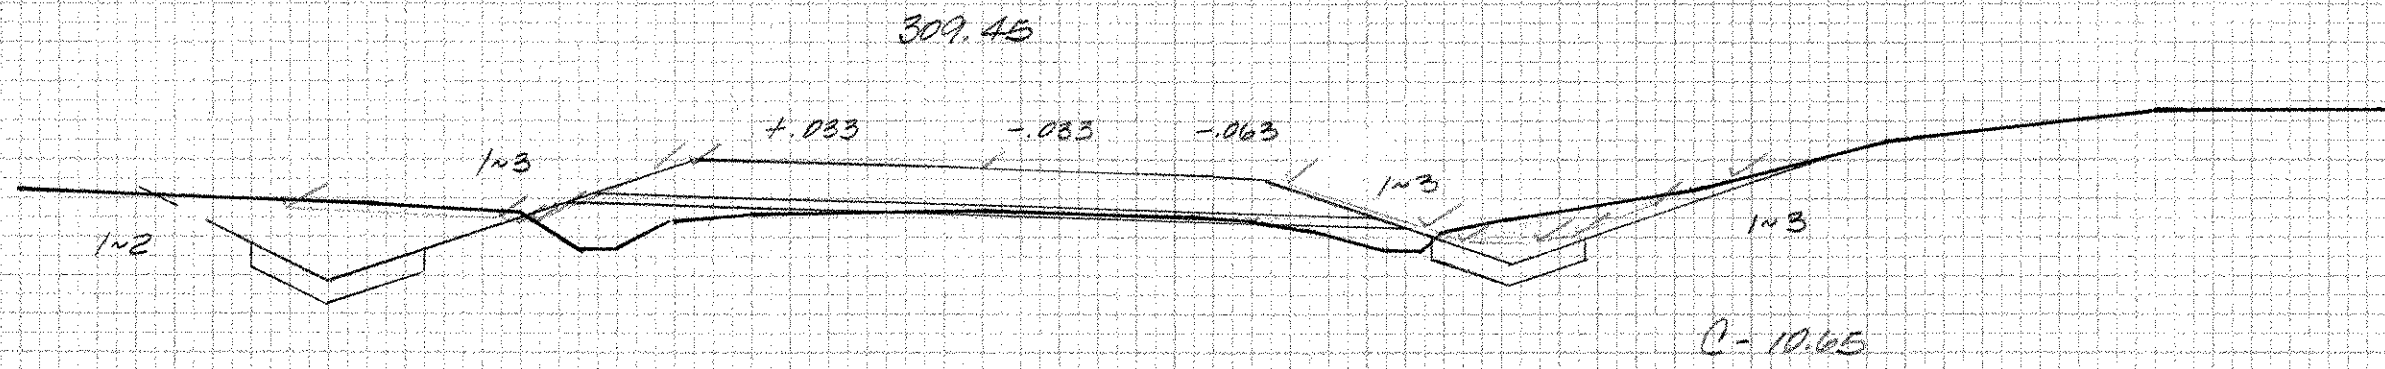

~~375+0~~
275+0

EARTH	
24.0	306.0
25.0	305.9
27.0	305.9
31.0	306.2
35.0	307.0
37.0	308.4
27.0	307.0
24.0	306.0
10.65	

310

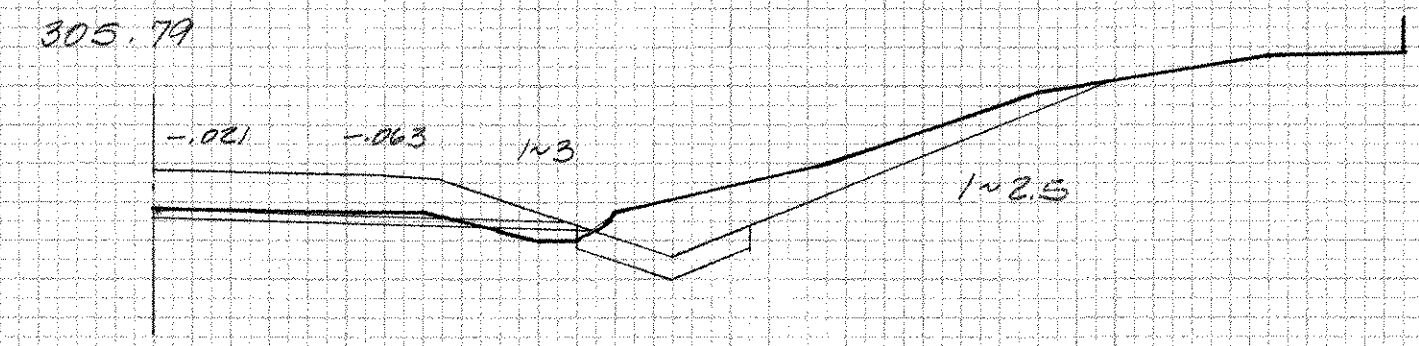

~~374+60~~
274+60

310

Q