


NO.	DATE	BY


NO.	DATE	BY

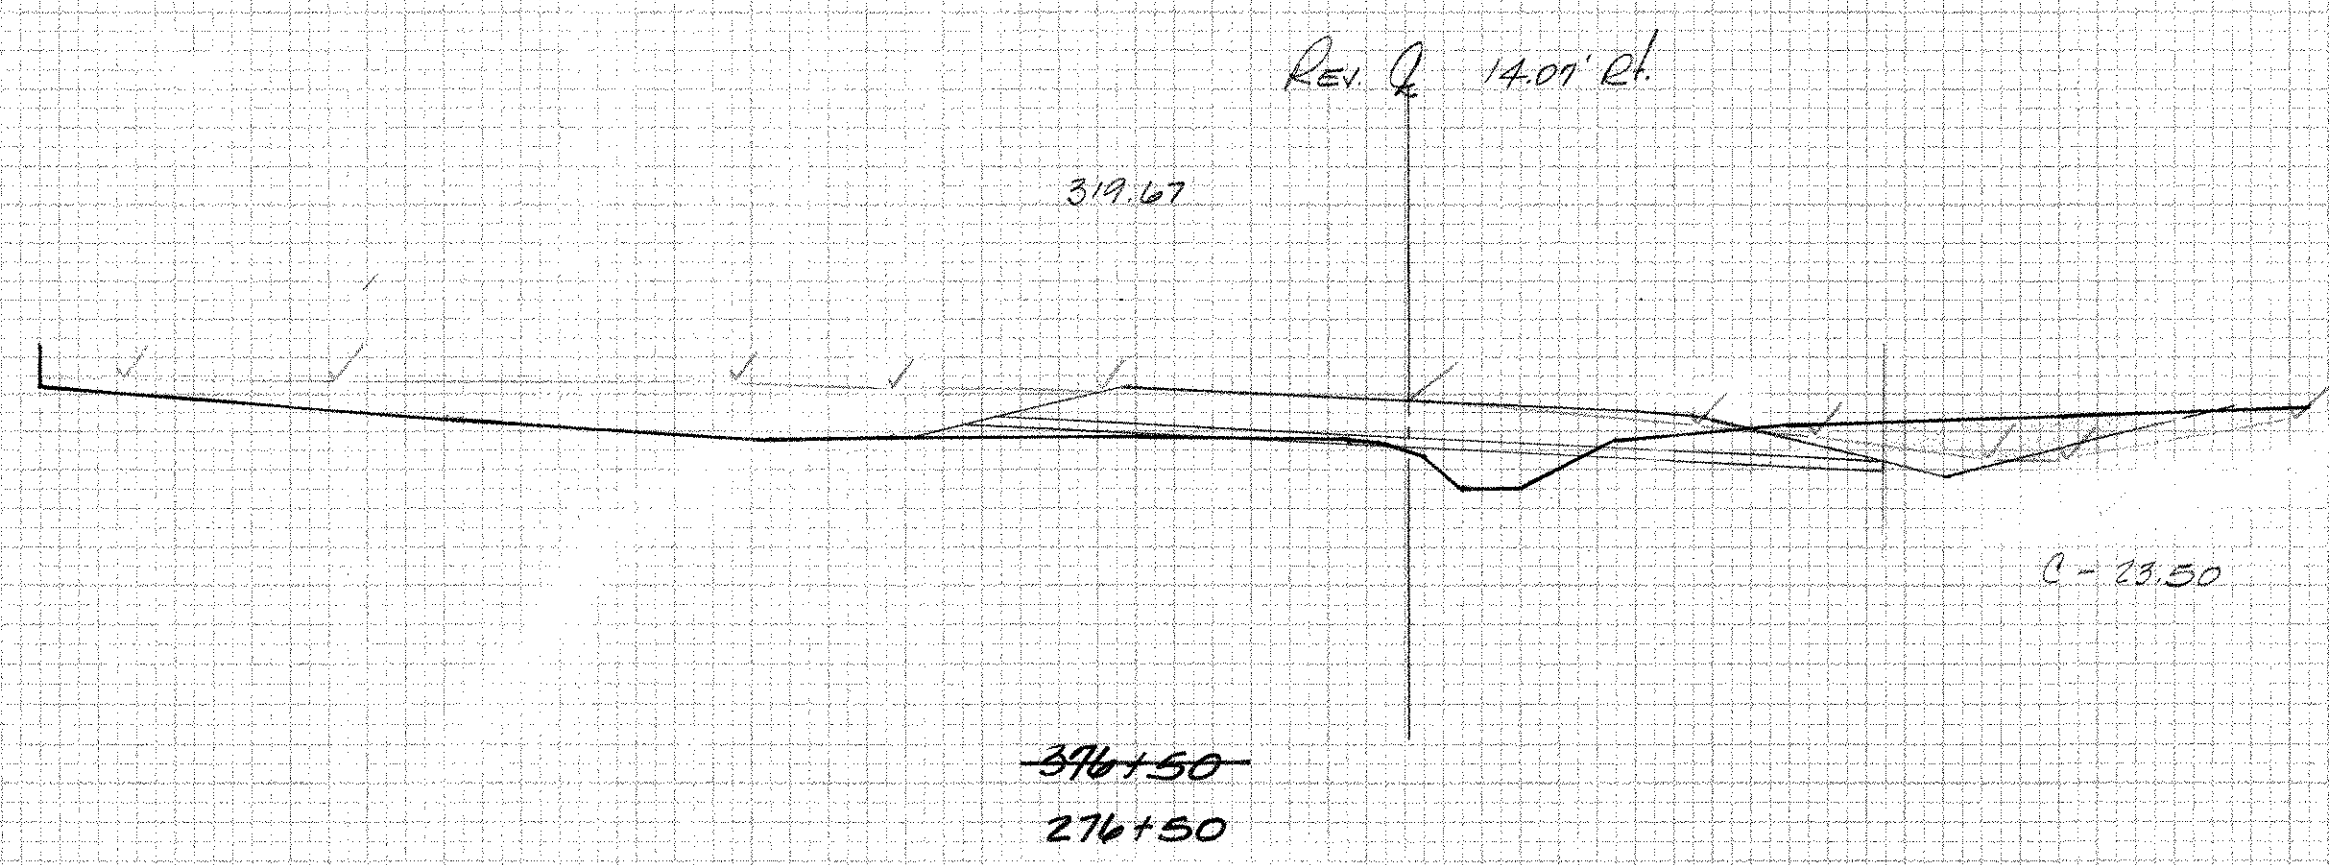

EARTH

28.9	318.5
28.9	317.2
34.1	316.5
35.0	316.4
46.0	314.0
28.9	312.5
28.50	


310

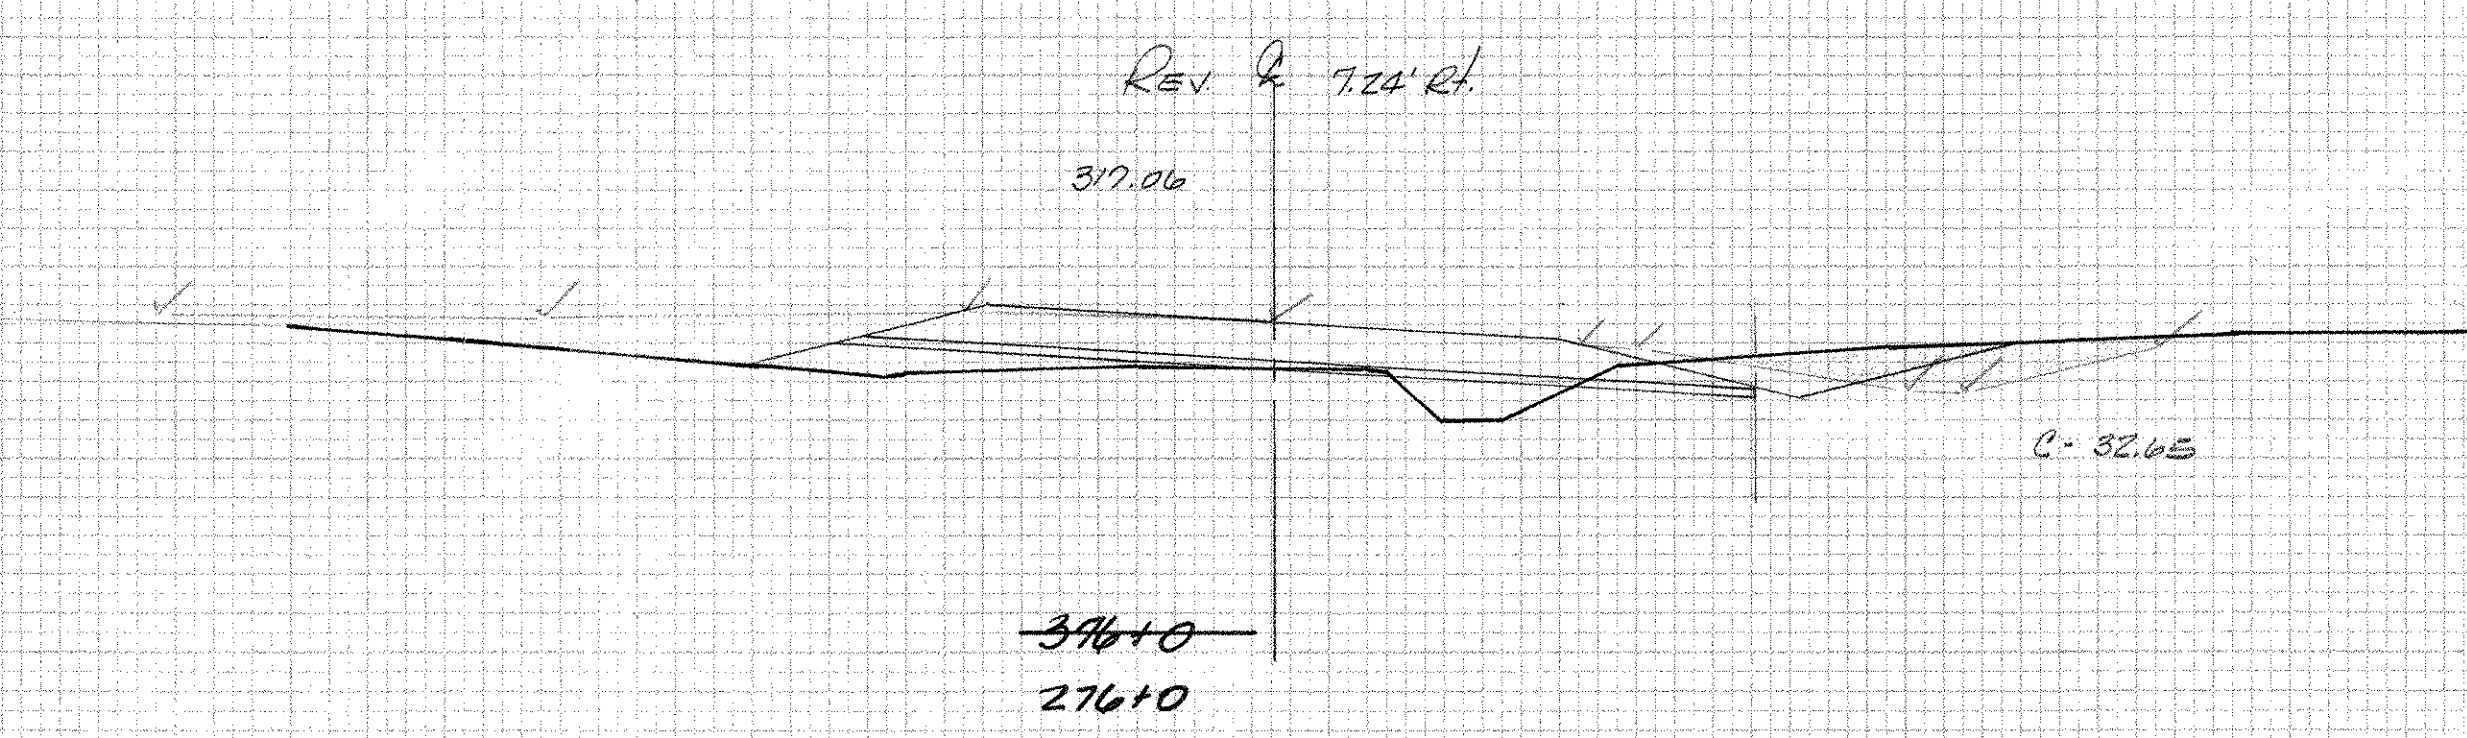

EARTH

21.0	315.2
21.0	314.8
33.0	313.6
33.0	313.6
44.0	312.2
21.0	310.9
21.0	310.2
32.65	

310

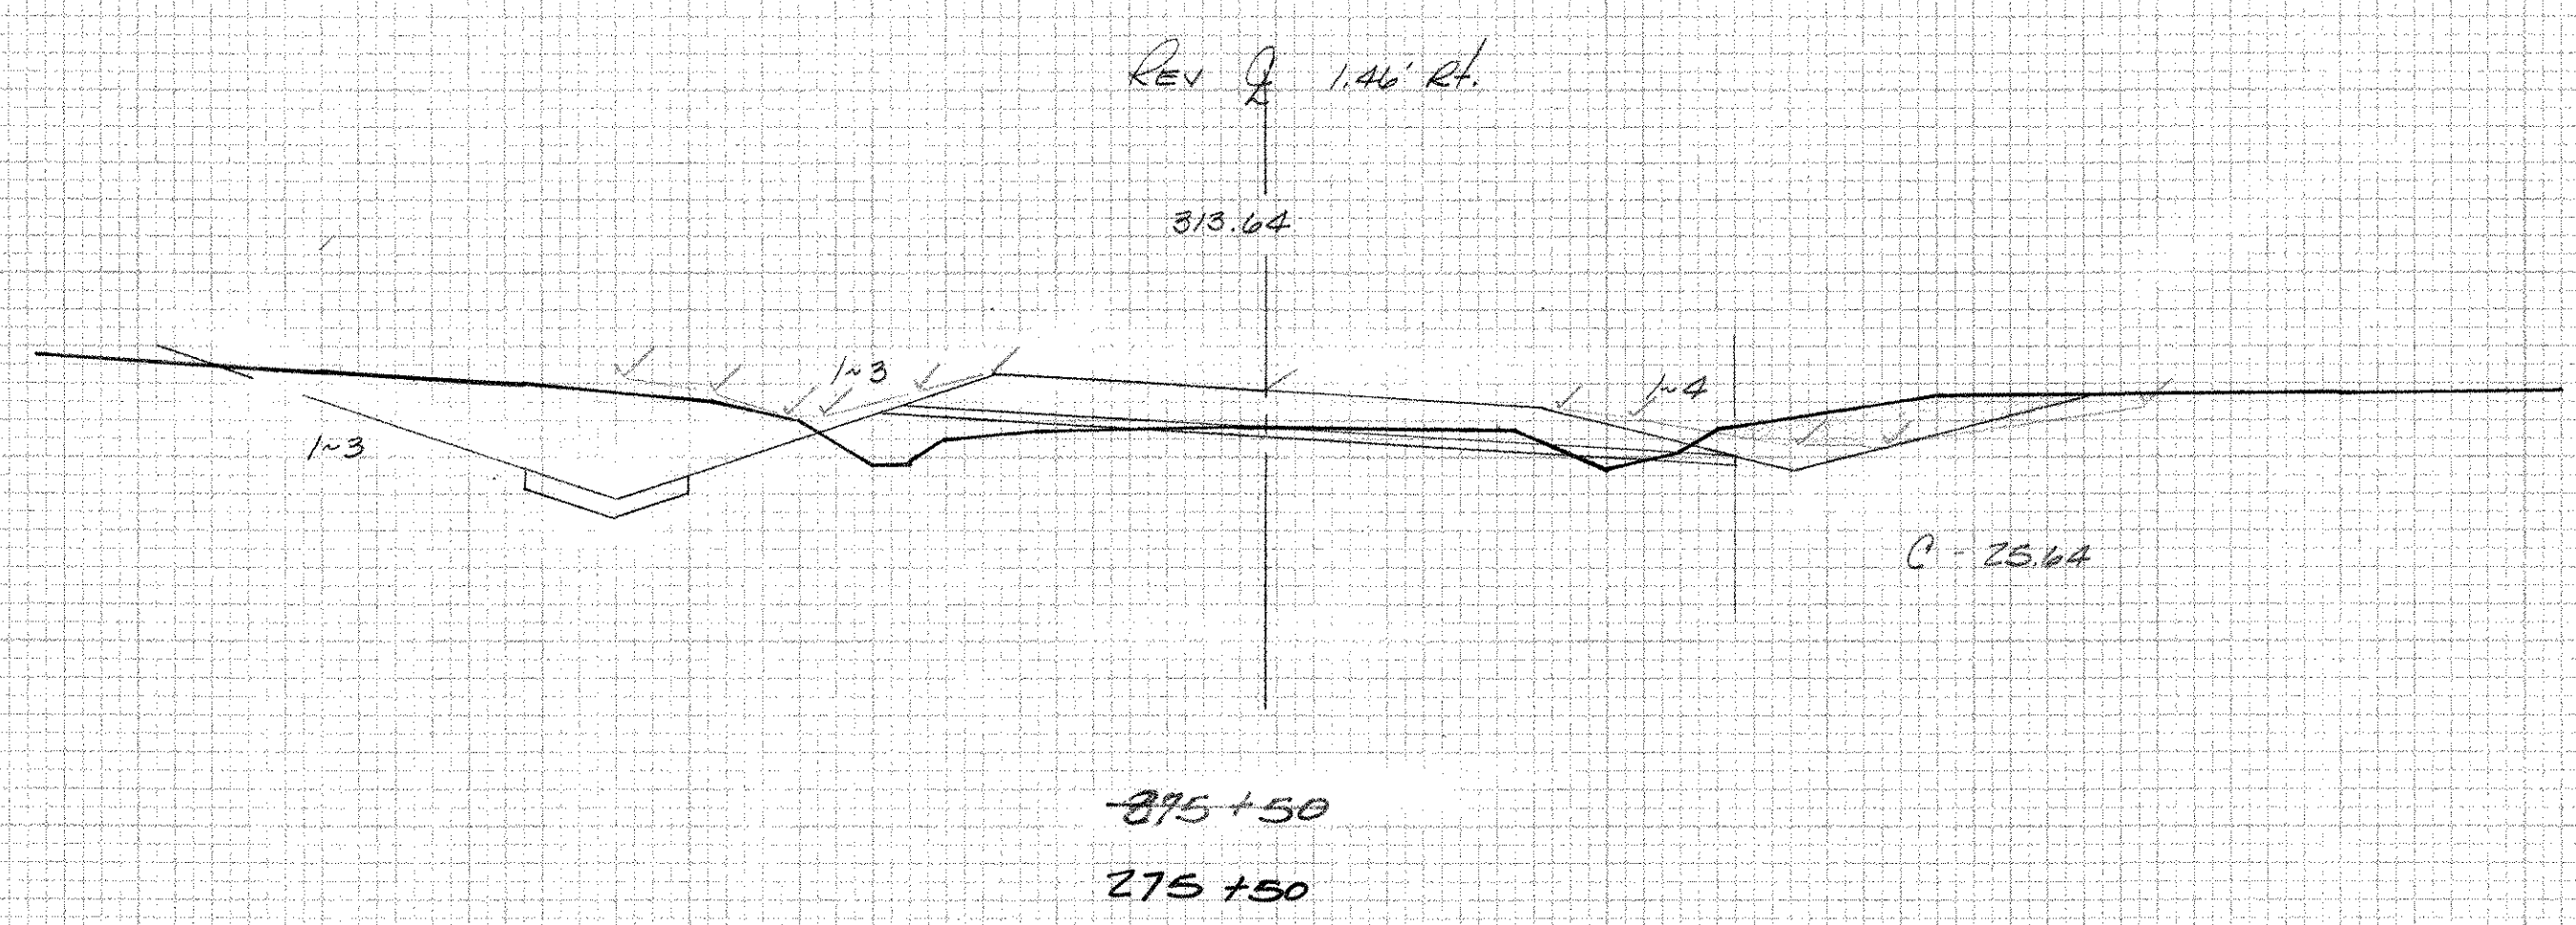

EARTH

27.0	311.7
27.0	311.2
31.6	310.5
25.6	310.5
27.0	310.0
46.0	308.4
39.0	308.5
27.0	311.7
25.64	

310