

INDEX OF SHEETS

1	TITLE SHEET
2	TYPICAL SHEET
3-5	QUANTITY SHEETS
6	ITEM DETAIL AND DRAINAGE SHEET
7	GRADE AND EARTHWORK SHEET
8	BLANK
9-12	R.O.W. DETAIL SHEETS
13-15	PLAN AND PROFILE SHEETS
16	COLD PLANING DETAIL SHEET
17	SIGHT LINE INFORMATION
18	MAILBOX DETAIL
19-20	BLANK
21	EXISTING SIGN SHEET
22-23	NEW SIGN SHEETS
24-30	TRAFFIC SIGN SUMMARY SHEETS
31-35	TRAFFIC DETAILS AND MARKING NOTES
36	BLANK
37-41	CROSS SECTIONS-VT22A
42-43	CROSS SECTIONS-VT17 EAST
44-47	CROSS SECTIONS-VT17 WEST


STANDARDS

B-5	TYPICAL SLOPE ROUNDING	12-06-71
C-1	CAST IN PLACE CONCRETE CURB, TYPE A	10-25-85 R
C-2	UNDERDRAIN & CARRIER PIPE CONSTRUCTION DETAIL	10-30-85 R
D-3	PLACING OF EROSION MATTING	04-02-84
D-4	CSF END SECTION	10-30-85 R
D-6	REINF. CONCRETE DROP INLET W/GRATE (DITCHES)	04-04-73
D-8	REINFORCED CONCRETE DROP INLET	12-06-71
D-9	REINFORCED CONCRETE DROP INLET TOPS	12-06-71
D-10	REINFORCED CONCRETE DROP INLET TOPS	12-06-71
D-13	REINFORCED CONCRETE CATCH BASIN W/GRATE	08-10-81 R
D-15	CAST IRON GRATE W/FRAME, TYPE D	10-30-85 R
D-16	CAST IRON GRATE W/FRAME, TYPE B & RCPS	10-30-85 R
D-20	HIGHWAY CROSSING SLEEVES FOR UNDERGROUND UTIL.	10-30-85 R
E-100	CONSTRUCTION APPROACH SIGNS	05-24-89 R
E-101	CONSTRUCTION SIGN DETAILS	10-30-87
E-102	CONSTRUCTION SIGN DETAILS	01-23-89 R
E-106	TRAFFIC CONTROL - MISCELLANEOUS DETAILS	01-23-89 R
E-107	DELINEATION, BARRICADES AND DETOURS FOR CONSTRUCTION AREAS	04-29-88 R
E-107A	BREAKAWAY BARRICADE DETAILS	09-10-87
E-109	TRAFFIC CONTROL DEVICES FOR TEMPORARY TERMINATION OF FREEWAY FACILITIES	04-29-88 R
E-110	MAJOR MAINTENANCE OPERATION LANE CLOSURE	03-01-88 R
E-121	STANDARD SIGN PLACEMENT - CONVENTIONAL ROAD	01-23-89
E-123	GUIDE SIGN PLACEMENT - MISCELLANEOUS DETAILS	01-23-89 R
E-130	TYPE "B" GUIDE SIGN, ATTACHMENT DETAILS	03-01-88 R
E-135	INTERSTATE ROUTE MARKER - SIGN DETAIL	01-23-89 R
E-136	U.S. AND STATE ROUTE MARKER SIGN DETAILS	04-29-88 R
E-140	REGULATORY SIGN DETAILS	04-25-88 R
E-141	REGULATORY SIGN DETAILS	10-30-87
E-142	REGULATORY SIGN DETAILS	10-30-87
E-143	REGULATORY SIGN DETAILS	10-30-87
E-150	WARNING SIGN DETAILS	10-30-87
E-160	FLANGED CHANNEL STEEL SIGN POST DETAIL	03-01-88 R
E-162	TUBULAR ALUMINUM SIGN POST	03-01-88 R
E-163	TUBULAR STEEL SIGN POST	09-10-87
E-170	TRAFFIC CONTROL SIGNALS	06-21-89
E-171A	TRAFFIC CONTROL SIGNALS	06-21-89
E-171B	TRAFFIC CONTROL SIGNALS	06-21-89
E-173	PULL BOXES AND JUNCTION BOXES	05-26-89 R
E-180	STREET LIGHTING DETAILS	03-01-88 R
E-191	PAVEMENT MARKING DETAILS	01-23-89 R
G-4	WOOD MARKER POST	10-31-85 R
J-1	BOUNDARY MARKERS	06-27-80
T-1	TEMPORARY EROSION CONTROL DETAILS	12-07-74 R
T-2	TEMPORARY EROSION CONTROL DETAILS	07-05-72

STATE OF VERMONT AGENCY OF TRANSPORTATION



PROPOSED IMPROVEMENT TOWN OF ADDISON COUNTY OF ADDISON VT RTE 22-A (F.A.P.)

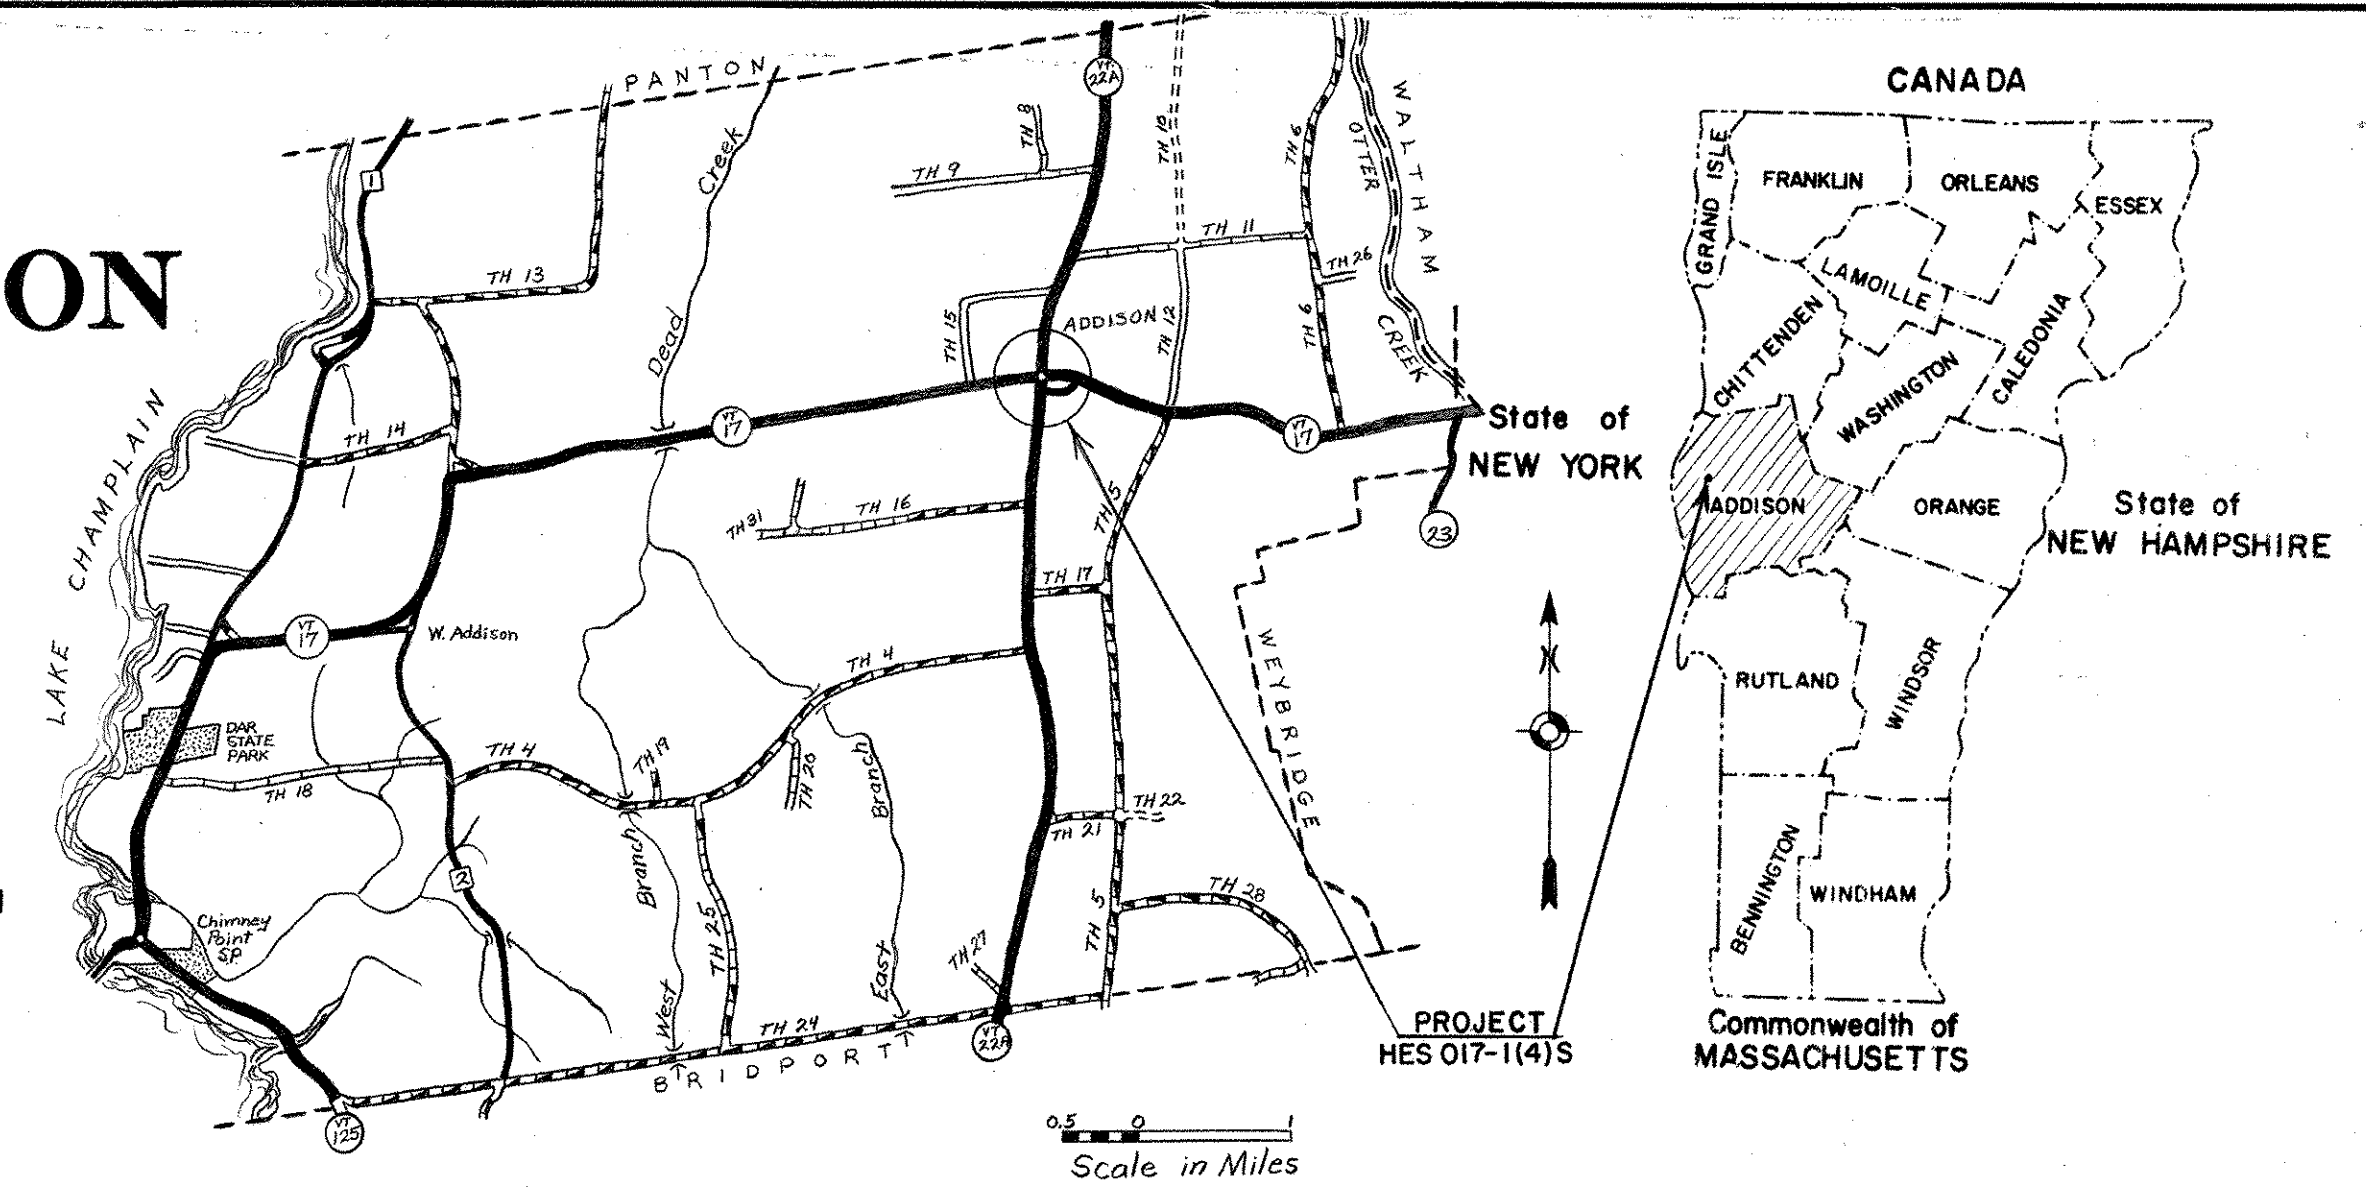

BEGINNING AT A POINT ON VT. RTE. 22A IN THE TOWN OF ADDISON 4.123 MI. NORTHERLY OF THE BRIDPORT-ADDISON TOWN LINE, AND EXTENDING 0.095 MI. NORTHERLY TO M.M. 4.218

LENGTH OF ROADWAY = 500.00 FT. = 0.095 MI.
LENGTH OF PROJECT = 500.00 FT. = 0.095 MI.

PROJECT DESCRIPTION

WORK TO BE PERFORMED UNDER THIS PROJECT CONSISTS OF COLD PLANING, LEVELING, RESURFACING WITH BITUMINOUS CONCRETE OVERLAY, PAVEMENT WIDENING TO INCLUDE PAVED SHOULDERS & CLOSED DRAINAGE. INSTALLATION OF SAFETY ENHANCEMENT FEATURES INCLUDING NEW SIGNS, FLASHING LIGHTS, ADVISORY SPEED SIGNS, CURBING.

TRAFFIC DATA


1989 ADT = 3450
1989 DHV = 480
D = 61%
T = 11%
V = 35 M.P.H.
(POSTED SPEED = 35 M.P.H.)

CONVENTIONAL SIGNS

COUNTY LINE	---
TOWN LINE	- - - -
LIMITS OF ACCESS	○ ○ ○ ○
POINT OF ACCESS	X
FENCE LINE	- x - x -
STONE WALL	~ ~ ~ ~
TRAVELED WAY	— — — —
GUARD RAIL	— o — o —
RAILROAD	— + — + —
SURVEY LINE	— + — + —
CULVERT	— + — + —
POWER POLE	○
TELEPHONE POLE	○
TREES	○
CONTROL OF ACCESS	///
PROPERTY LINE	— + — + —
R.O.W TAKING LINE	— + — + —
SLOPE RIGHTS	○ SR △
TOP OF CUT	△
TOE OF SLOPE	○

DATUM

VERTICAL	N.G.V.D. 1929
HORIZONTAL	N/A

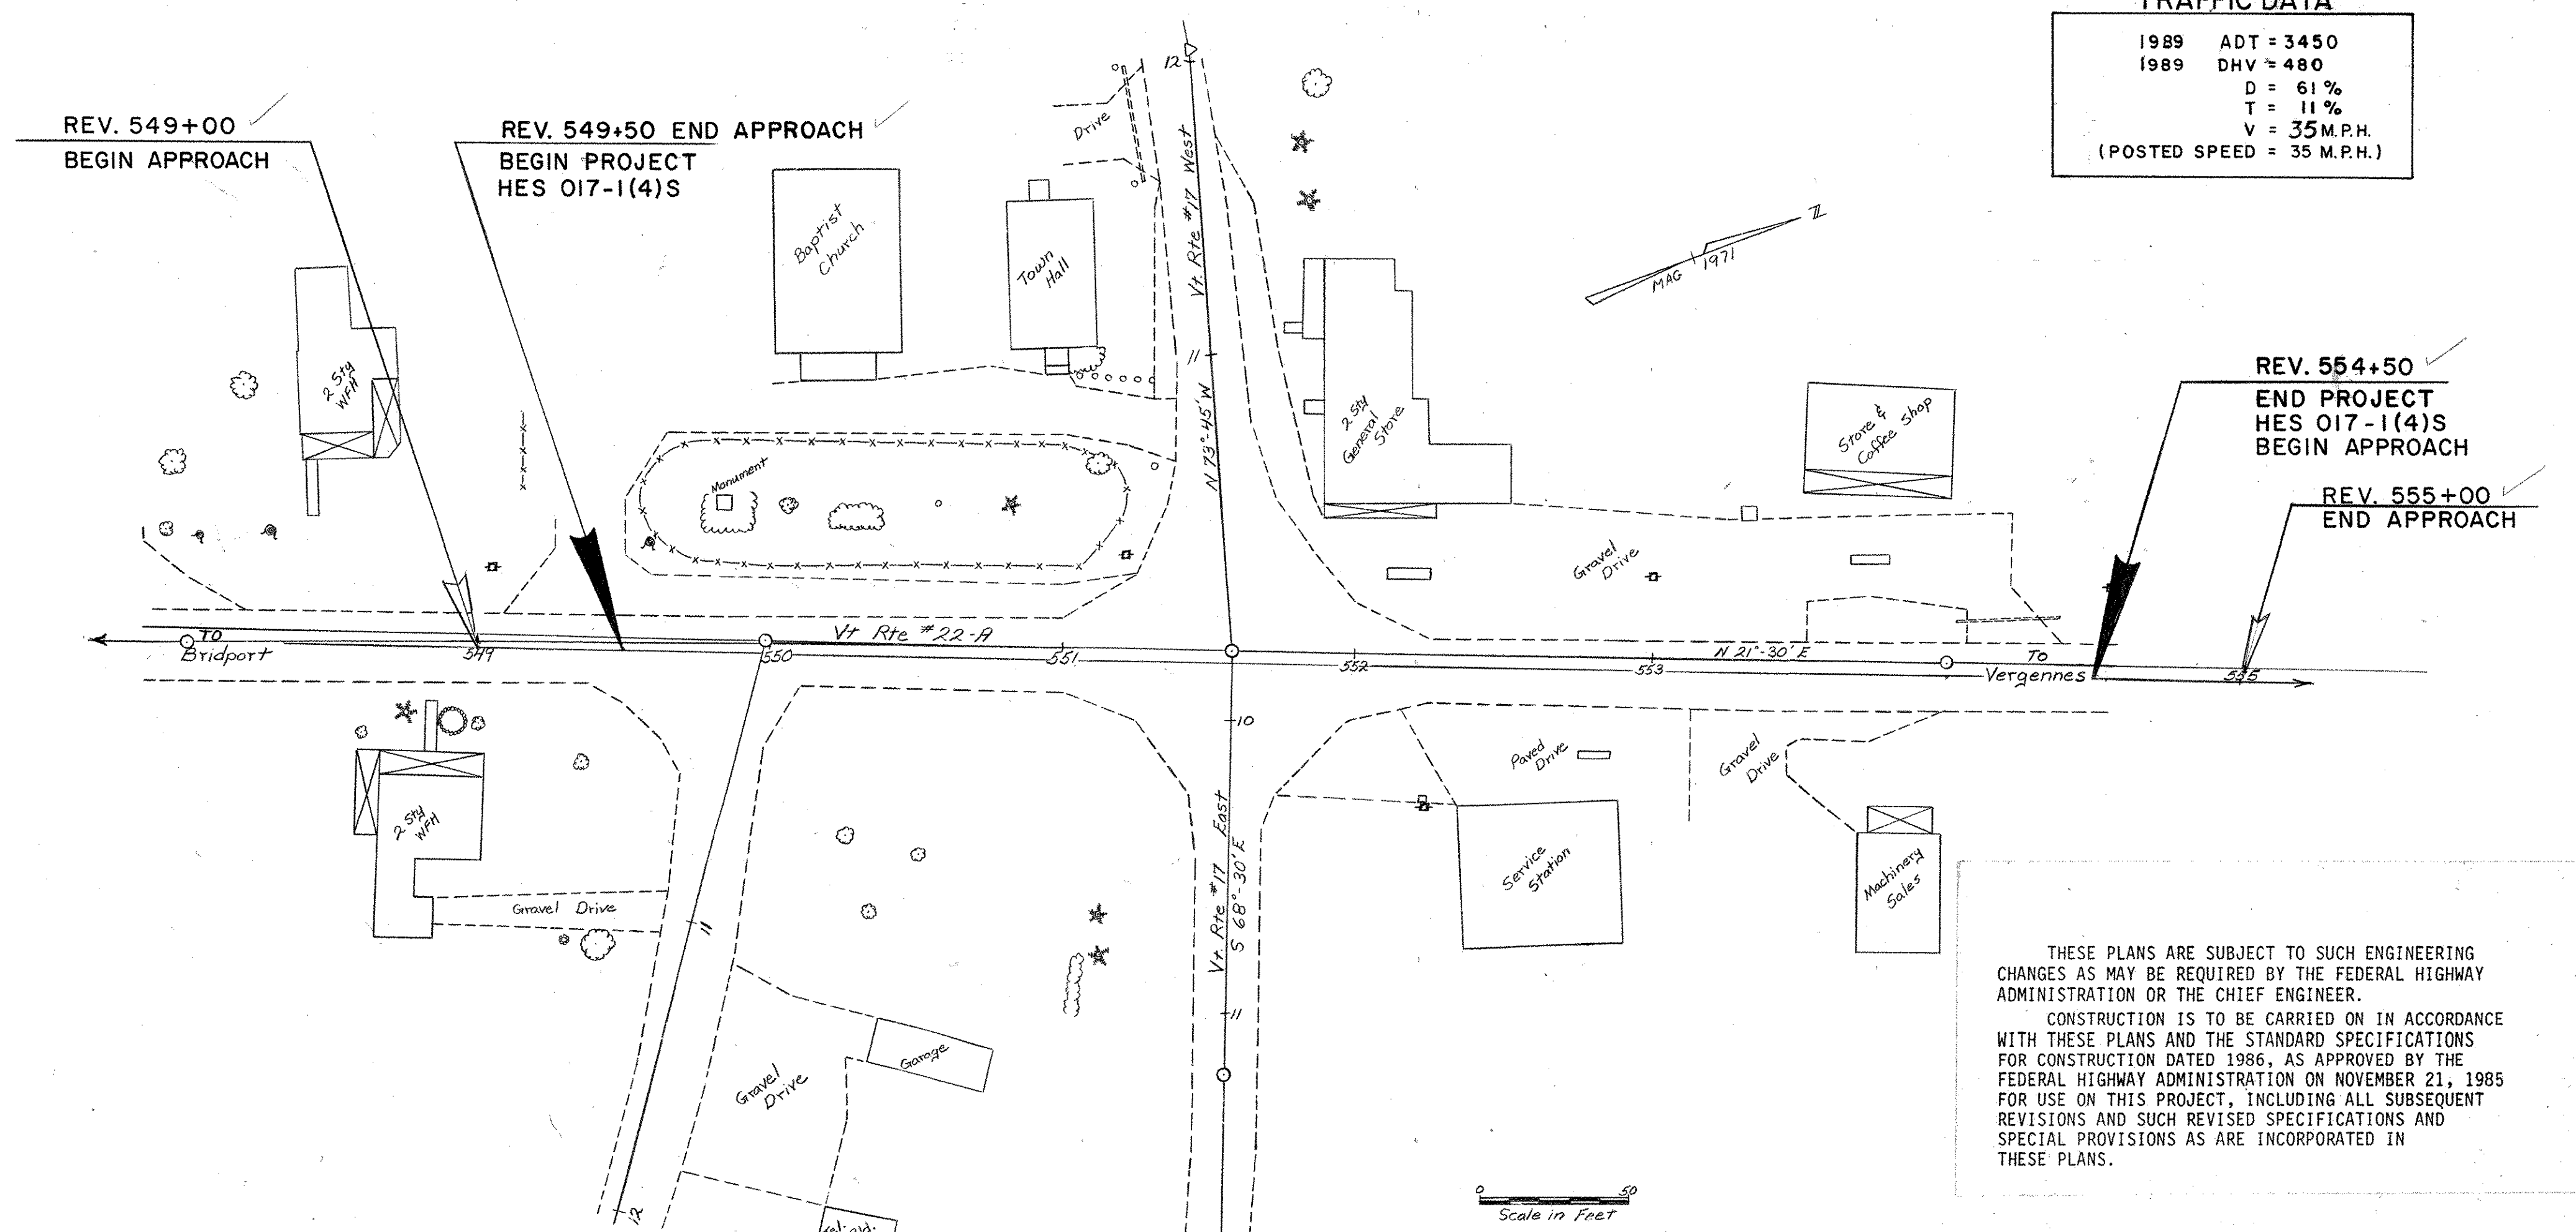

PROJECT PROCESSED UNDER
SECONDARY ROAD PLAN

SUBMITTED BY ORDER OF THE STATE TRANSPORTATION BOARD	
APPROVED <i>David B. Kelley</i>	DATE 6/15/89
CHIEF ENGINEER	
DEPARTMENT OF TRANSPORTATION FEDERAL HIGHWAY ADMINISTRATION	
APPROVED _____	DATE _____
DIVISION ADMINISTRATOR	
ADDISON	
PROJECT HES No 017-1(4)S	
SHEET 431 OF 477	
SHEET 1 OF 47 SHEETS	

THESE PLANS ARE SUBJECT TO SUCH ENGINEERING CHANGES AS MAY BE REQUIRED BY THE FEDERAL HIGHWAY ADMINISTRATION OR THE CHIEF ENGINEER. CONSTRUCTION IS TO BE CARRIED ON IN ACCORDANCE WITH THESE PLANS AND THE STANDARD SPECIFICATIONS FOR CONSTRUCTION DATED 1986, AS APPROVED BY THE FEDERAL HIGHWAY ADMINISTRATION ON NOVEMBER 21, 1985 FOR USE ON THIS PROJECT, INCLUDING ALL SUBSEQUENT REVISIONS AND SUCH REVISED SPECIFICATIONS AND SPECIAL PROVISIONS AS ARE INCORPORATED IN THESE PLANS.