

**STATE OF VERMONT
AGENCY OF TRANSPORTATION
RIGHT OF WAY PLANS
DETAIL SHEET**


TABLE OF PROJECT PROPERTY ACQUISITION

PARCEL NO.	GRANTOR	SHEET NO.	BEGINNING STATION	ENDING STATION	TAKING	REM.	RIGHTS	TITLE TAKEN	DATE	TOWN OR CITY RECORDED	BK.	PG.	REMARKS	REVISION NO.	SHEET	DESCRIPTION OF REVISION	DATE	MADE BY	APPROVED BY
1	THE COMMUNITY BAPTIST CHURCH IN ADDISON	4	REV. 551+14 LT. REV. 549+34 LT.	REV. 551+33 LT. REV. 549+70 LT.	0.01A±		SLOPE (T) 90 S.F.±	WDOE		ADDISON			390 S.F.±	1	3,4	PARCEL NO. 3 BURPEE SPENCER FARM EQUIP. HAS BEEN DELETED PER CO. 7658	3-24-89	A.S.J.	<i>Sub</i>
2	CONTINENTAL TELEPHONE CO. OF VERMONT INC.	4,5	VT. 17 12+00 RT. VT. 17 12+52 RT.	VT. 17 13+00 RT.			DITCH (P) CULVERT & DR. (P)	WDOE		ADDISON				2	3,4	PARCEL NO 5 CROSS DELETED FROM PROJECT PER CO. 7659 <i>MyLars to Design 6-2-89</i>	3-27-89	A.S.J.	<i>JCP</i>
3	DELETED												COMBINED WITH PARCEL NO. 4						
4	BURPEE, WILLIAM W. & DELNA P.	4	REV. 552+20 RT. REV. 552+29 RT. REV. 552+54 RT. REV. 552+73 RT. REV. 553+28 RT. REV. 554+60 RT.	REV. 554+55 RT. REV. 552+33 RT. REV. 553+06 RT.			SLOPE (T) 0.03 A± EASE. TO INSTALL & MAINT. (P) DRIVE (T) EASE. TO INSTALL & MAINT. (P) DRIVE (T) INSTALL & MAINTAIN (P)	WDOE		ADDISON			1304 S.F.± CURB 40' PAVED MP 4181 CURB 40' PAVED MP 4195 SIGN						
5	DELETED									ADDISON			FORMELY CROSS, REGINALD & RUTH						
6	CENTRAL VERMONT PUBLIC SERVICE CORP.												UTILITY						
7	TRI-TOWN WATER DISTRICT												UTILITY						

THIS SHEET TO BE USED
FOR ROW INFORMATION ONLY


ROW PLANS

DR. RT.- DRAINAGE RIGHT
DIT. RT.- DITCHING RIGHT
CH. RT.- CHANNEL RT.
DRIVE RT.- DRIVE RIGHT
CUL. RT.- CULVERT RIGHT
ⓓ- DEMOLITION OR REMOVAL
W- WATER SOURCES

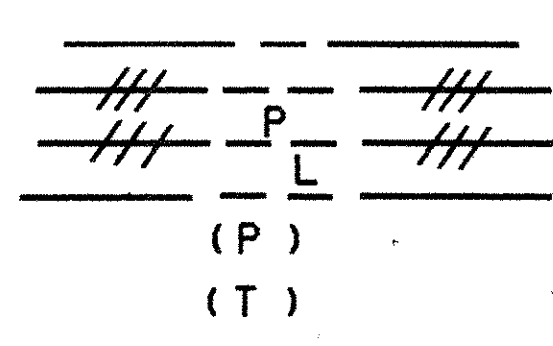

PRESENT R.O.W.
TAKING WITHOUT ACCESS
TAKING WITHOUT ACCESS ALONG PROPERTY LINE
TAKING WITH ACCESS
PERMANENT EASEMENT
TEMPORARY EASEMENT

LEGEND

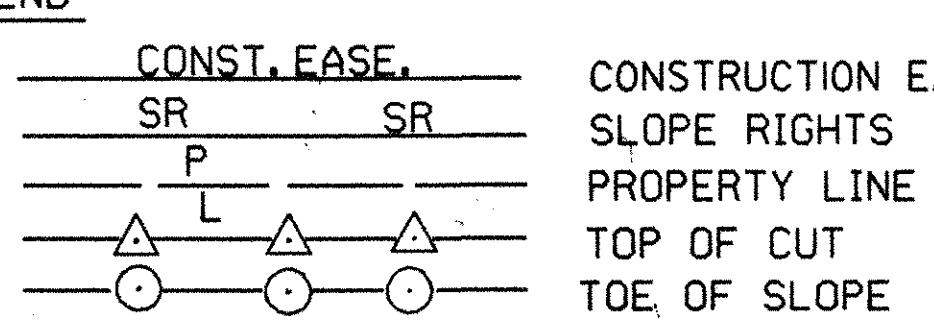

CONSTRUCTION EASEMENT
SLOPE RIGHTS
PROPERTY LINE
TOP OF CUT
TOE OF SLOPE

APPROVED: LAWRENCE BLISS, L.S. DATE: 7-27-88
AGENT D, PLANS & TITLES

R. O. W. PLANS

ADDISON
HES 017-1(4)S
SHEET 439 OF 477
SHEET 9 OF 47