



PLAN	SURVEYED	DATE
	PLOTTED	BY
NOTE BOOK NO.	CHECKED	DATE
	RT. OF WAY CHECKED	BY

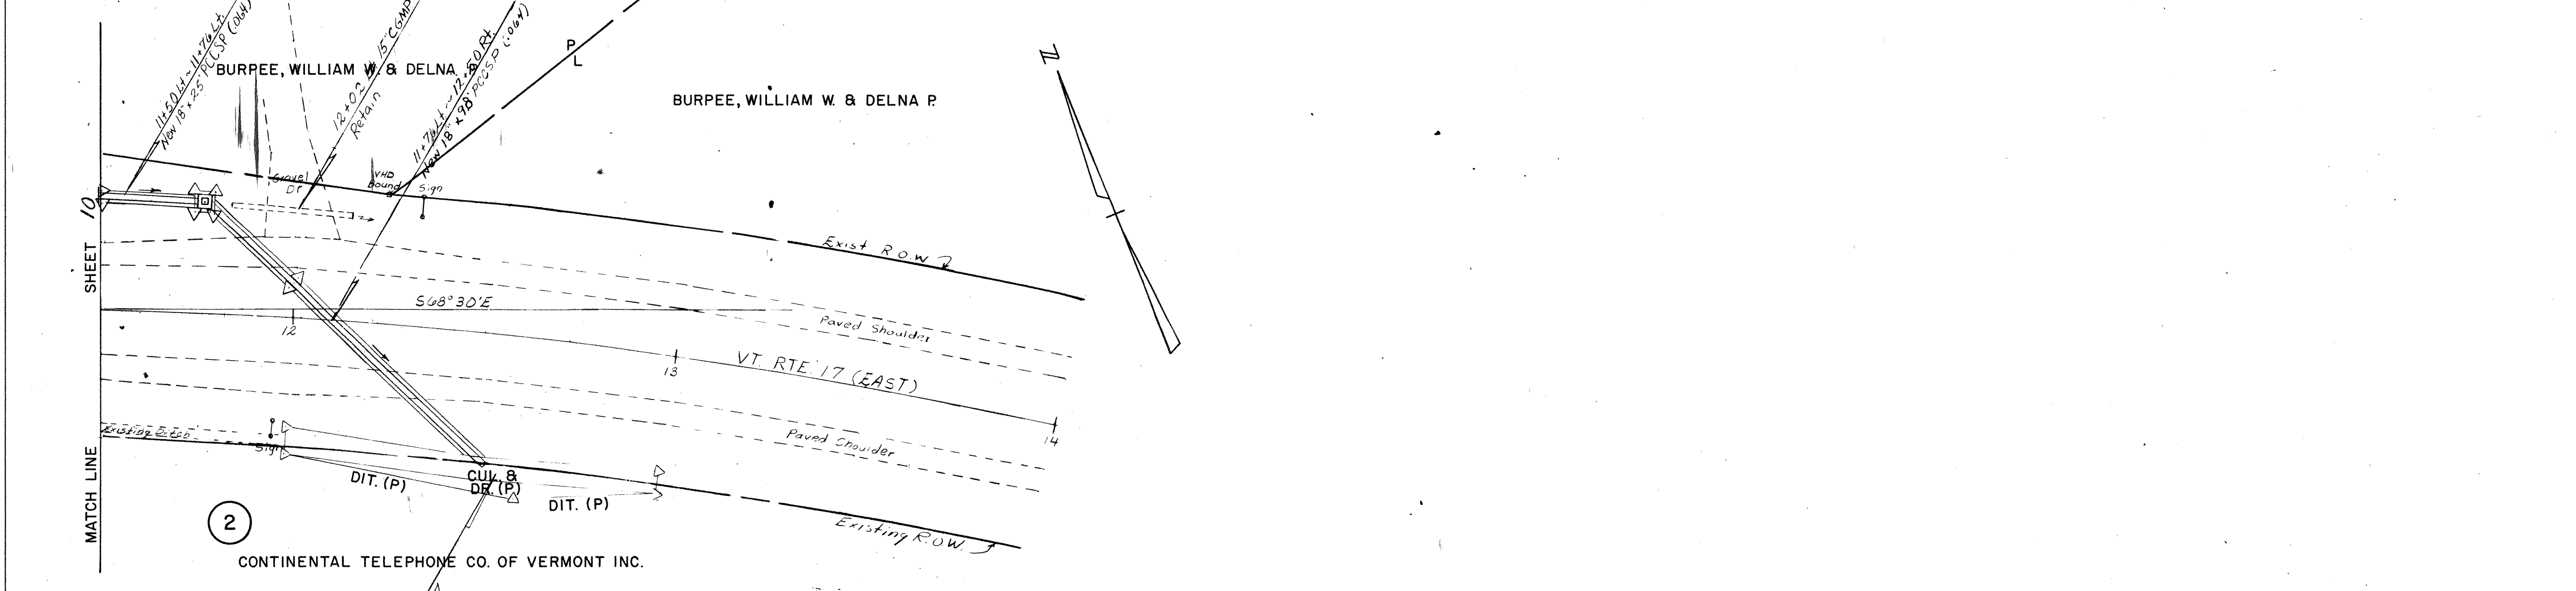

PROFILE	SURVEYED	DATE
	PLOTTED	BY
NOTE BOOK NO.	CHECKED	DATE
	STRUCTURE NOTATION CHVD	BY

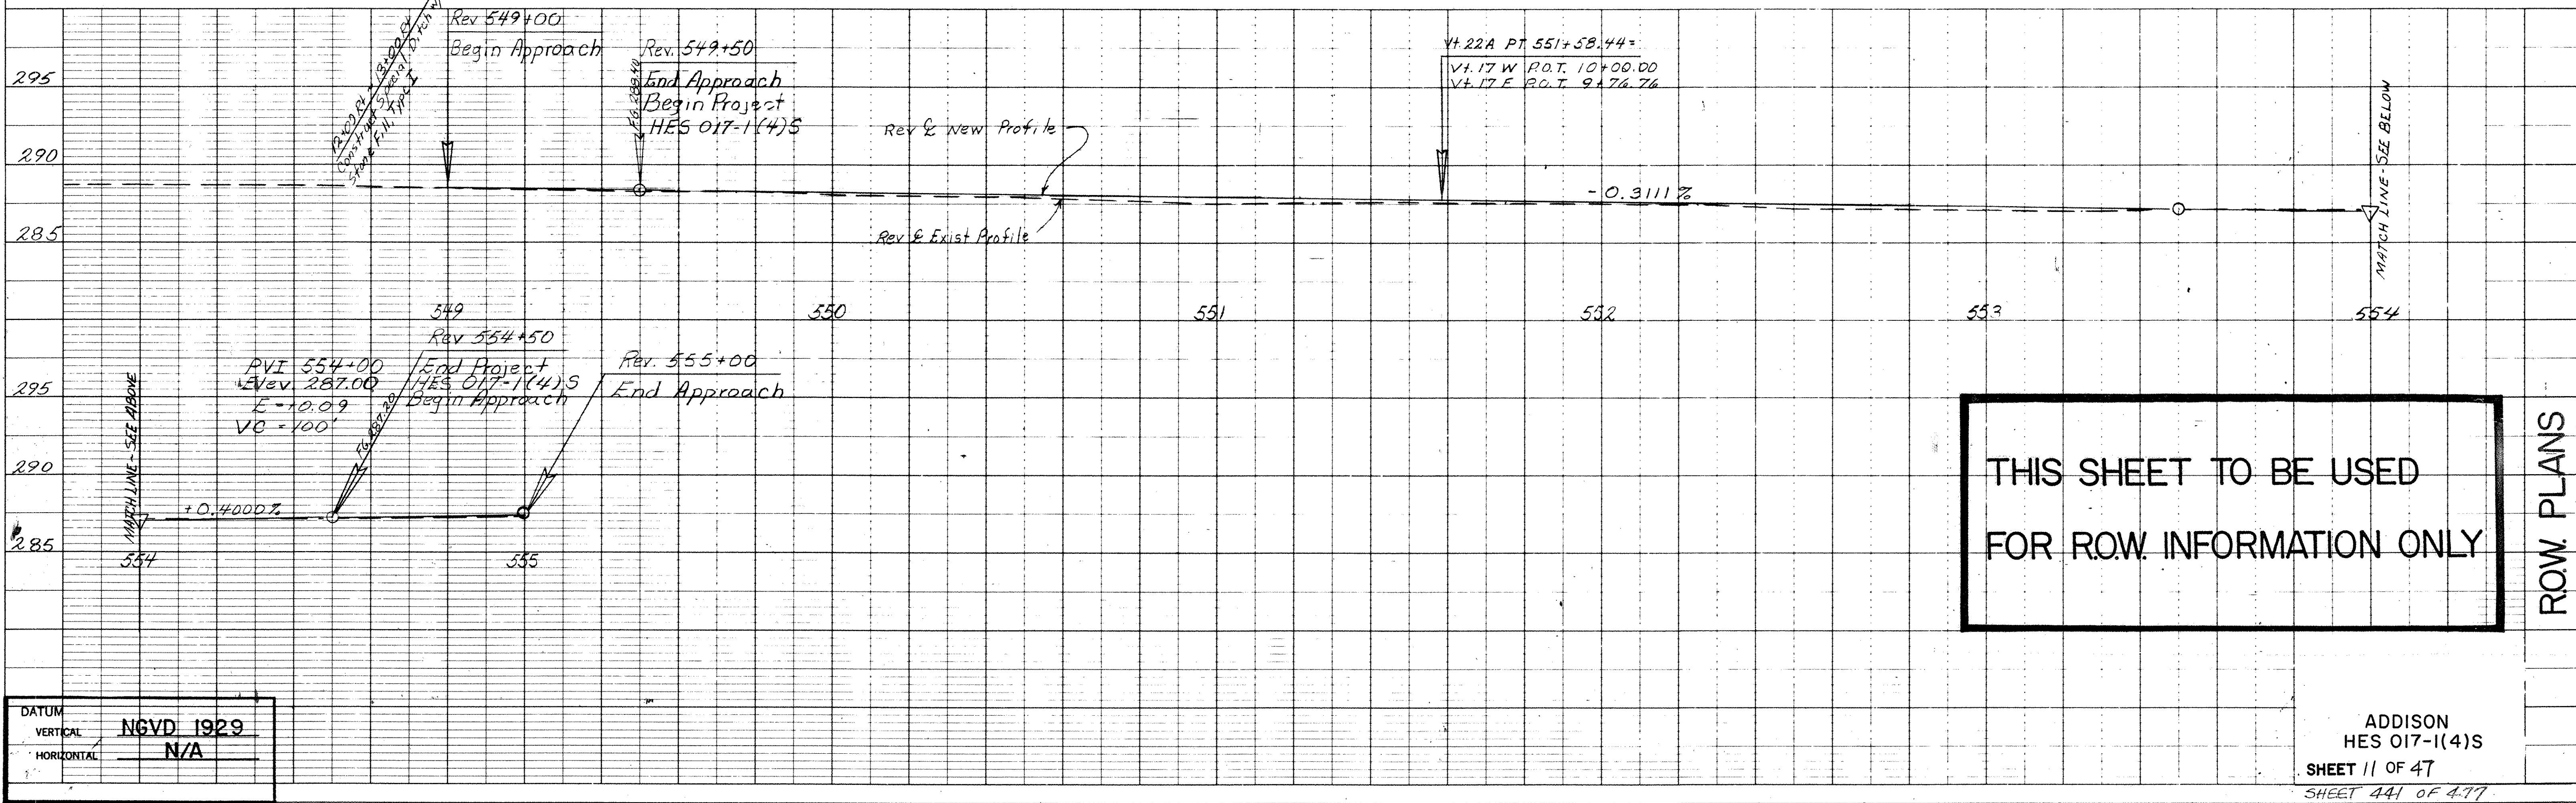

DATUM	VERTICAL	NGVD 1929
	HORIZONTAL	N/A

ADDISON
HES 017-1(4)S
SHEET 11 OF 47
SHEET 441 OF 477