



Pavement & Shoulder Transition Detail

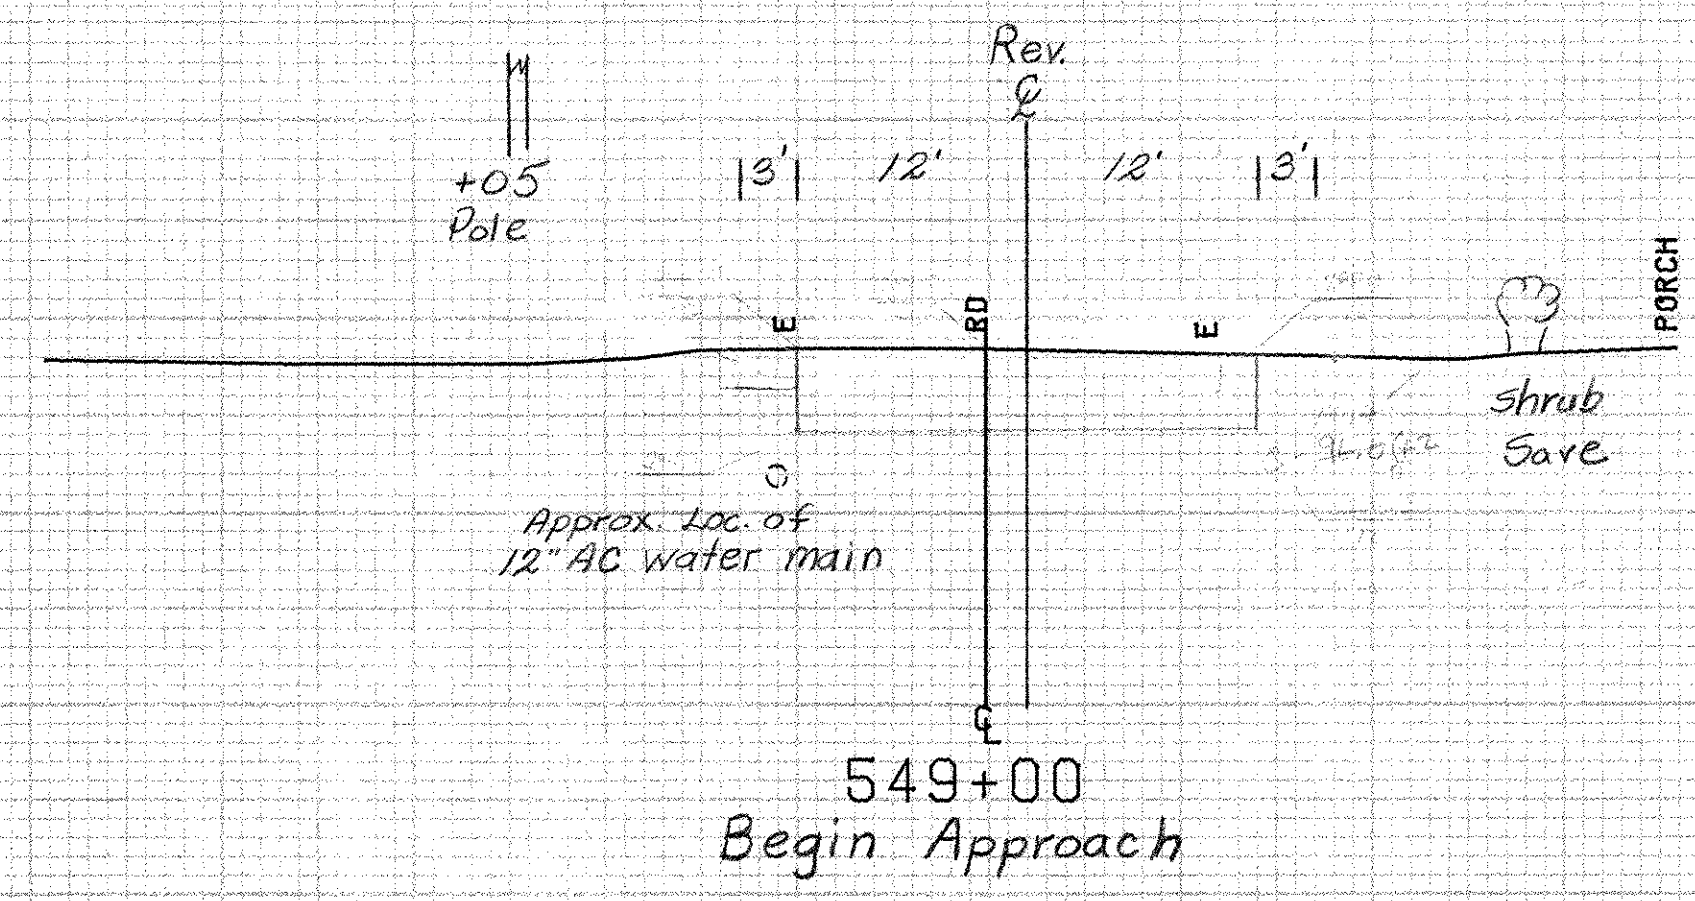


SBA F017-1(2) 549+00

SR	RT	
LT		
SR	RT	
LT		


280

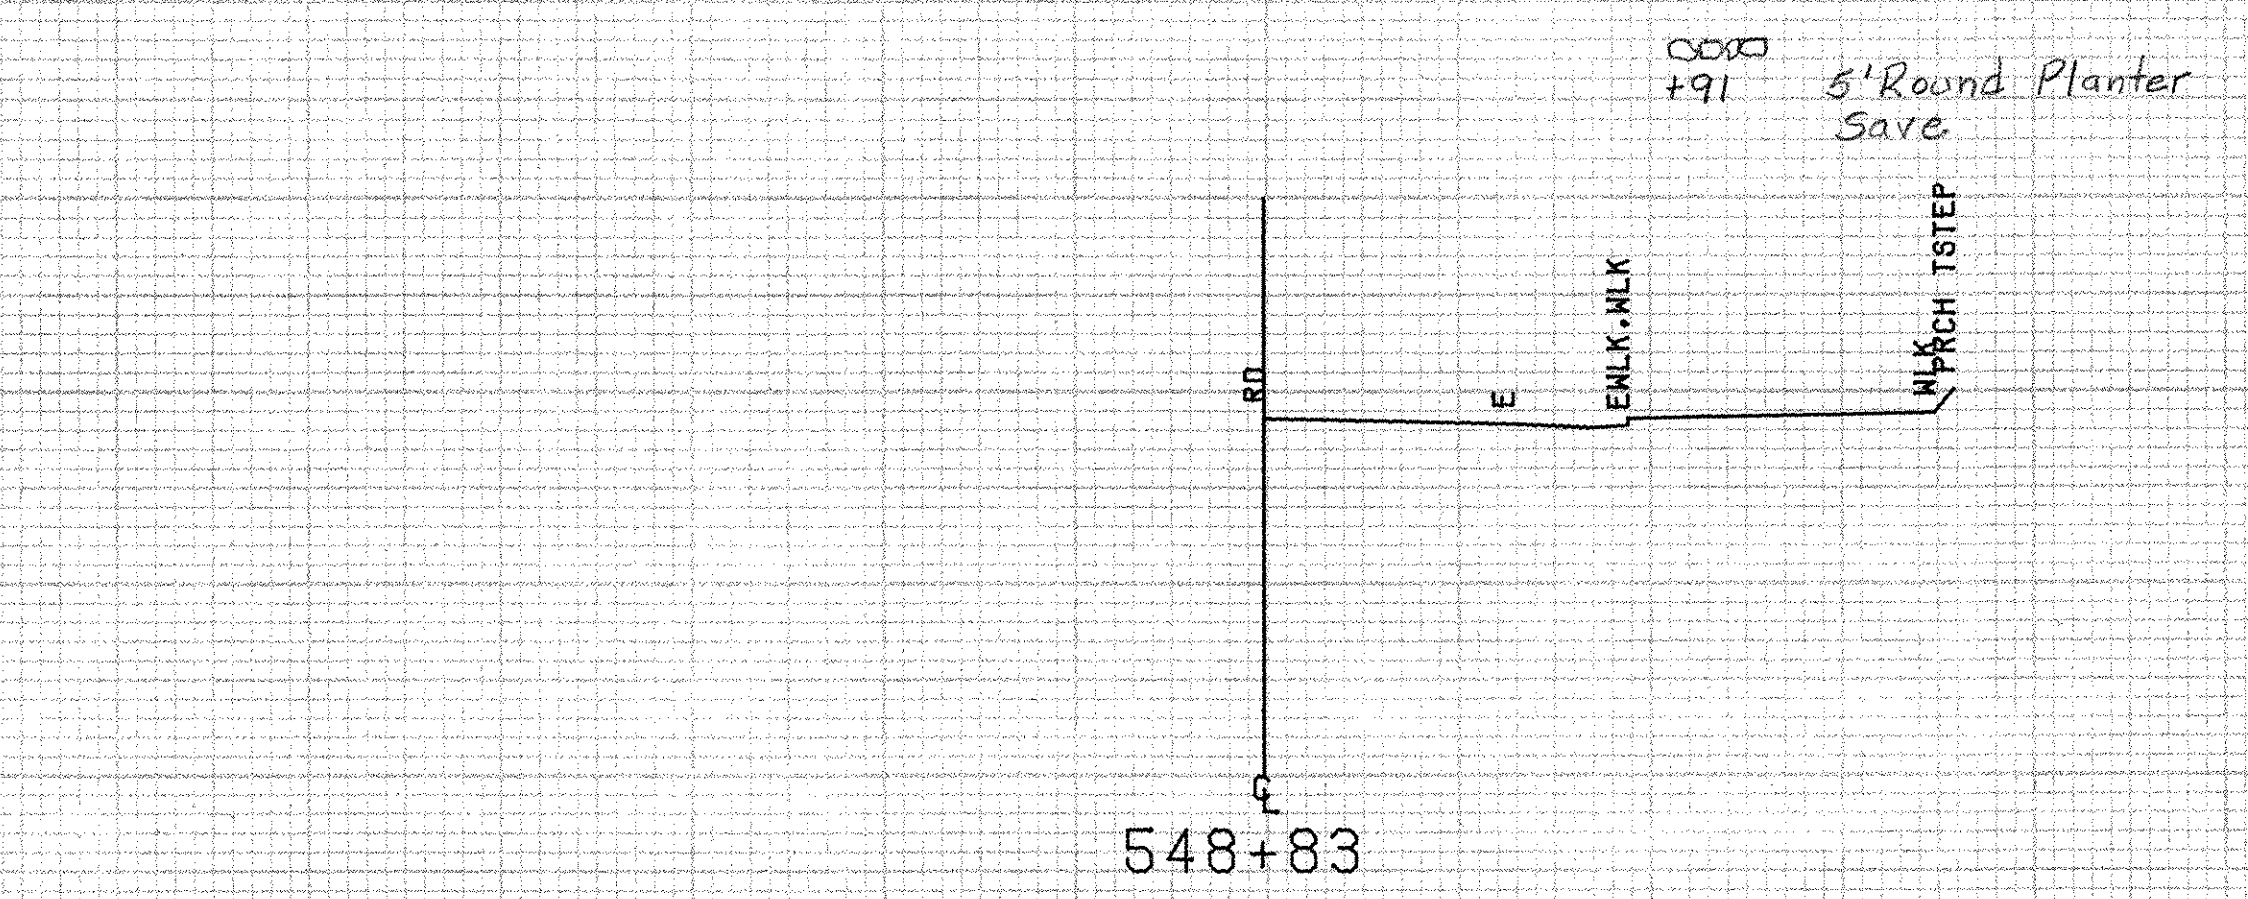

280

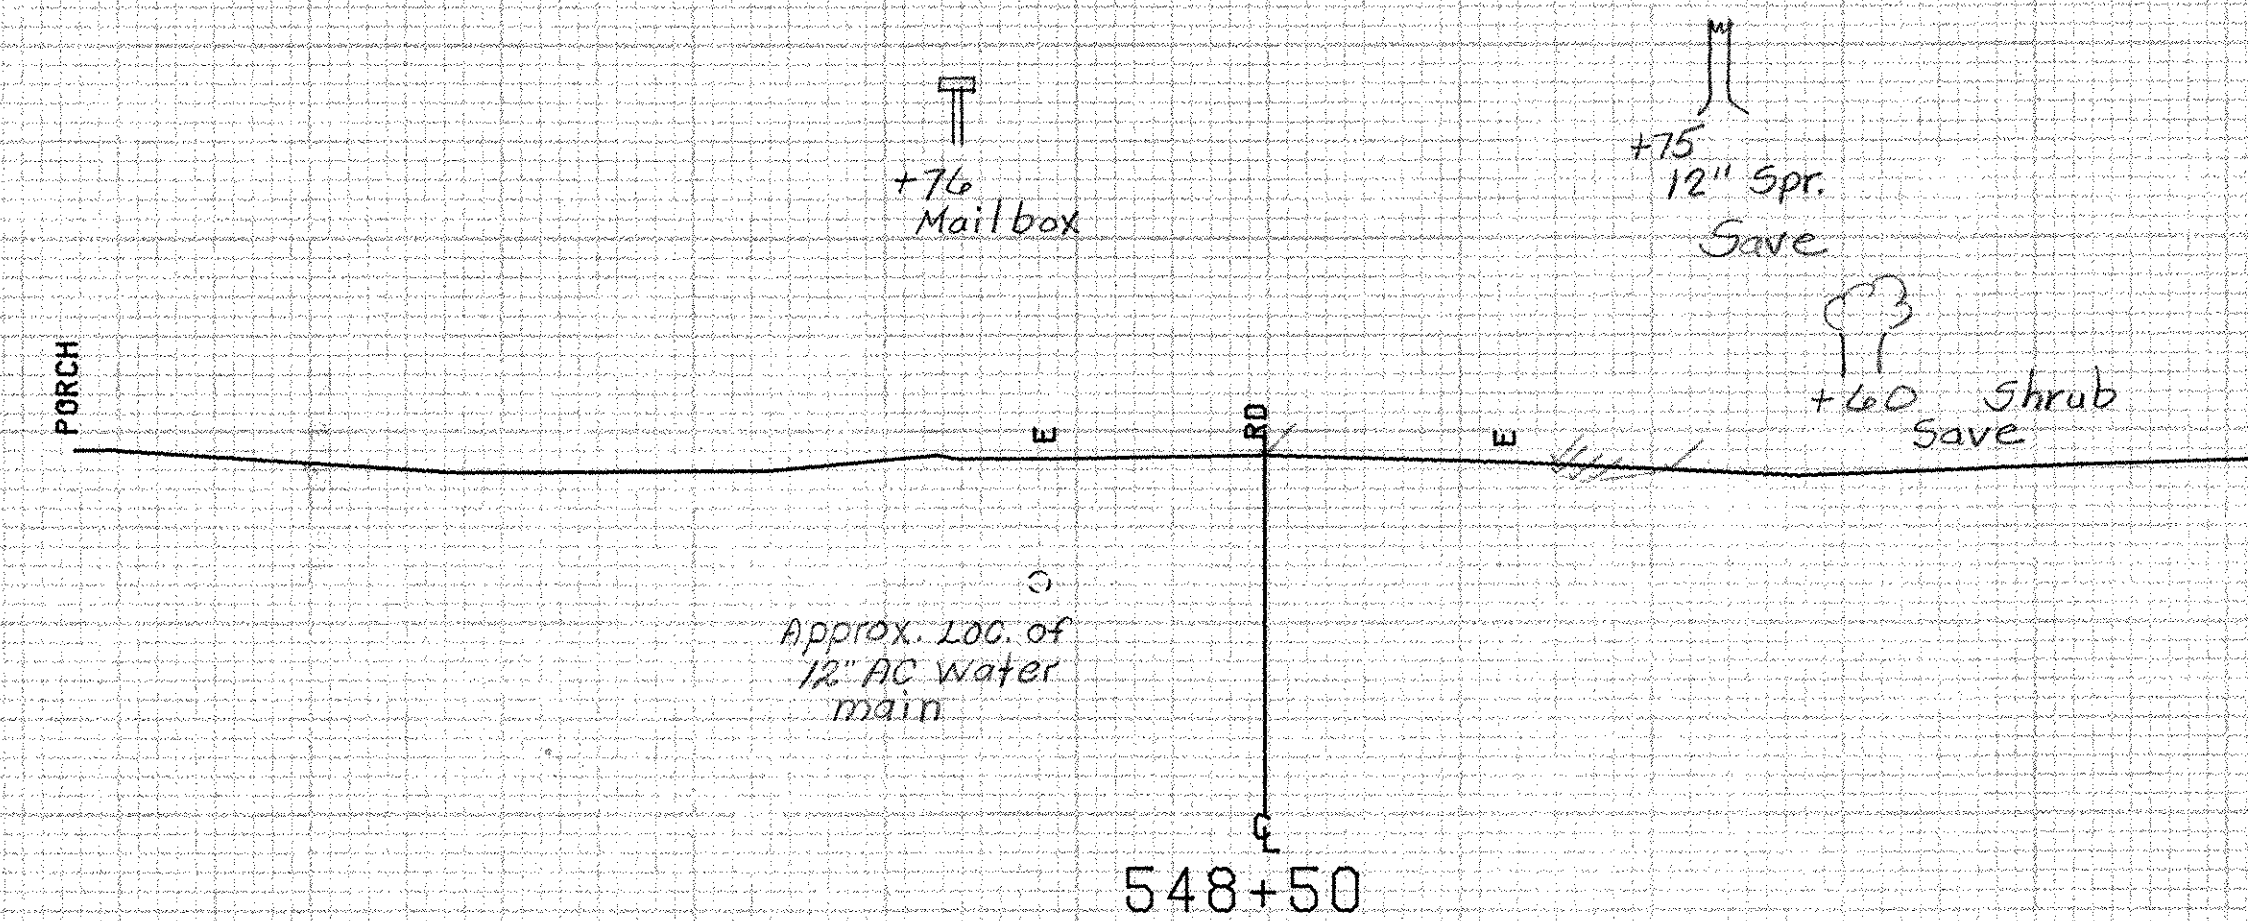

280

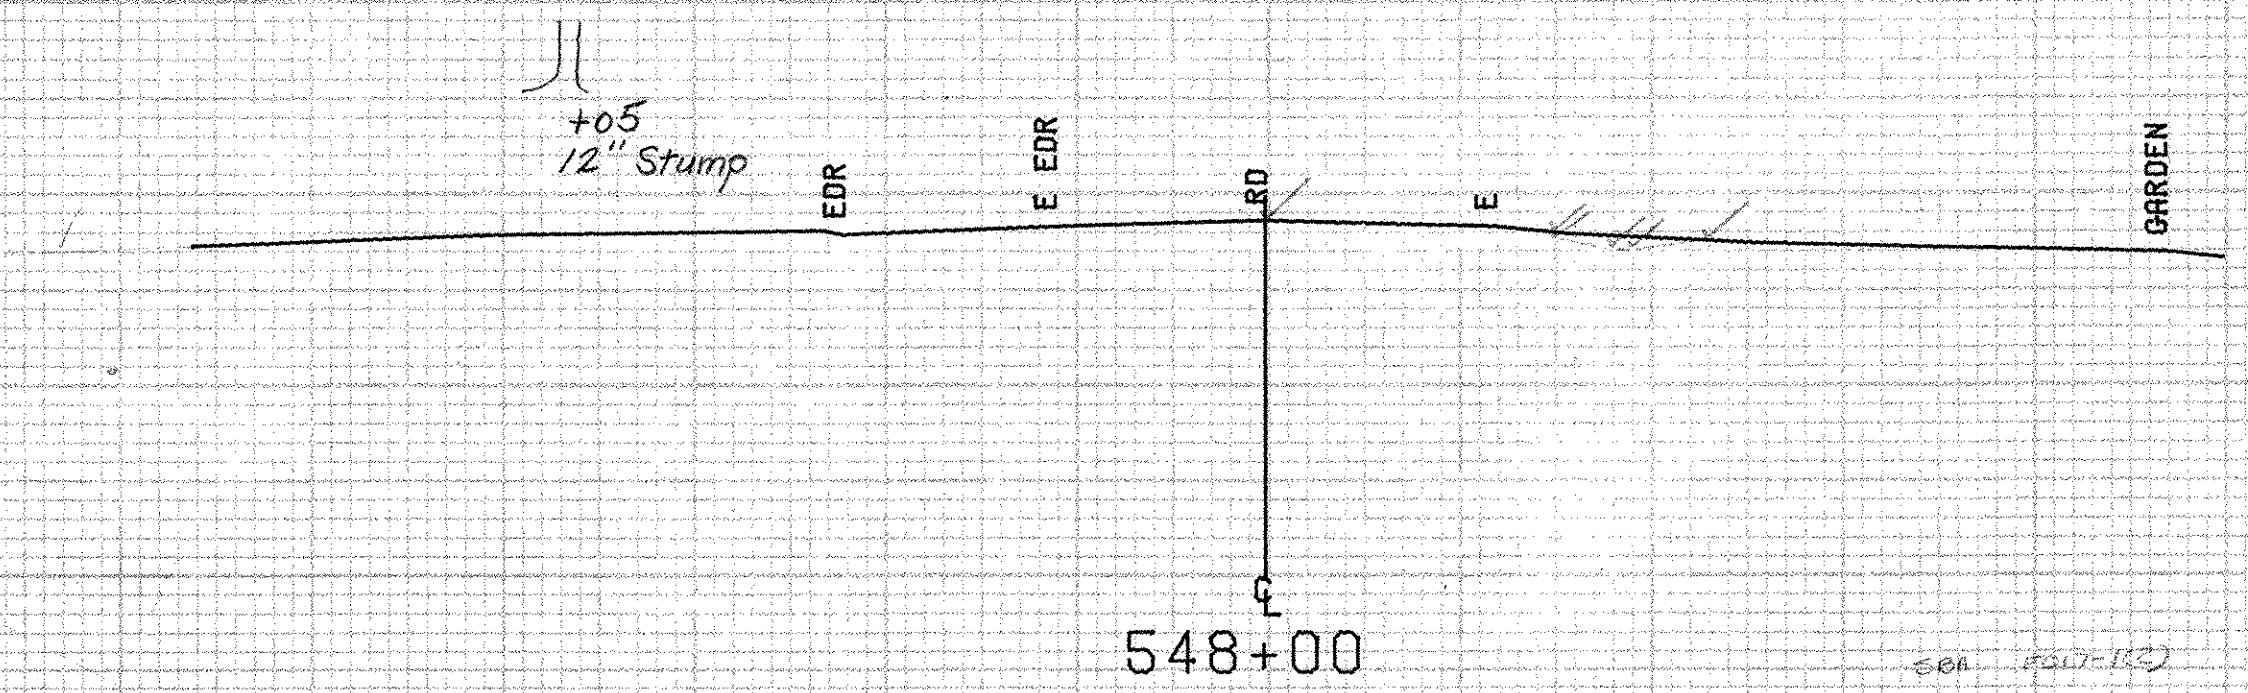

280

SHEET 467 OF 477

FROM STA.	548+00	TO STA.	549+00
PROJECT NAME	ADDISON	VT22A	
NO.	HES017-1(4)S	PLOTTED	11/29/84
SURVEYED BY	FANTONI	SEPT	1984
SHEET	37	OF	47 SHEETS

SCALE 10 FEET