


DATE \_\_\_\_\_  
 BY \_\_\_\_\_  
 SURVEYED \_\_\_\_\_  
 FINAL SURVEY \_\_\_\_\_  
 NOTE BOOK \_\_\_\_\_  
 NO. \_\_\_\_\_

DATE \_\_\_\_\_  
 BY \_\_\_\_\_  
 SURVEYED \_\_\_\_\_  
 ORIGINAL SURVEY \_\_\_\_\_  
 NOTE BOOK \_\_\_\_\_  
 NO. \_\_\_\_\_

COMMON	
23.5	497.5
25	497.2
27	496.6
29	497.4
34	500.4
36	502.6
39	501.5
27	497.5
25.5	497.5

S.F.	
20	498.4
25	497.2
27	496.6
29	497.4
36	500.4
36	502.6
33	500.6
27	498.0
21	498.4
20	498.4

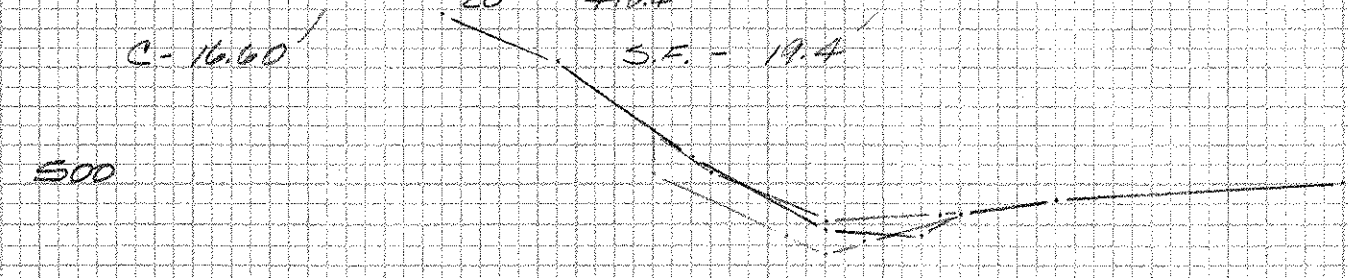

47+0

46+75	0	0	8.98
47+0	16.60	9.69	19.40
47+50	19.70	35.61	31.30
48+0	14.25	31.44	25.15
		<u>12.74 C.V.</u>	<u>66.21 C.V.</u>

46+75  
ZERO


COMMON	
20	498.1
25	499.1
34	499.8
35	501.7
30	500.0
26	498.2
24	498.0
20	498.1

S.F.	
19	498.6
25	497.1
34	499.8
35	501.7
25	497.9
19	498.5

C-14.25 S.F. 13.60

46+18  
BUTT

48+0  
BUTT

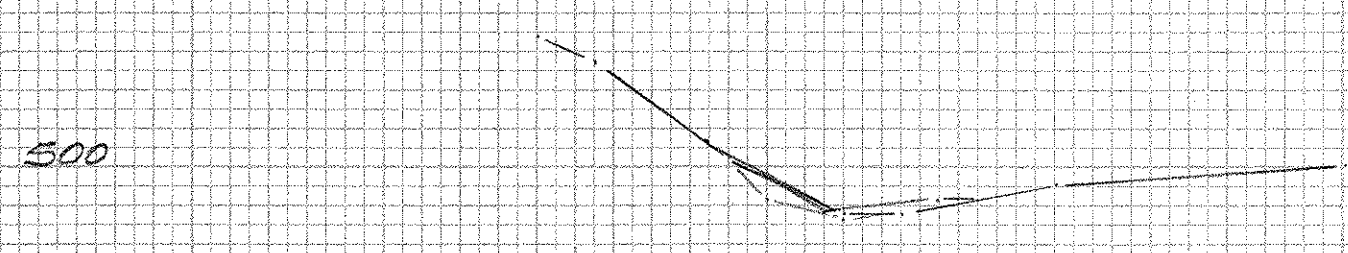

46+0

COMMON	
23	497.5
26	497.5
32	500.5
30	498.2
26	497.1
23	497.5

S.F.	
19	498.5
23	497.5
26	497.1
30	498.2
32	500.5
27	497.6
21	498.2
19	498.3

C-5.30 S.F. 6.35

45+00	5.30	6.35	2.02
46+0	12	2.36	4.35
46+10	10	3.53	4.25
46+15	5.80	6.35	
	<u>C-5.07</u>	<u>S.F. 7.05</u>	


45+85  
BUTT

COMMON	
25	497.8
37	501.2
36	501.8
40	505.2
37	501.5
36	501.5
28	497.1
25	497.8

S.F.	
26	497.7
28	497.1
36	501.5
37	501.5
38	503.5
31	499.6
26	497.7

C-19.70 S.F. 14.4

47+50

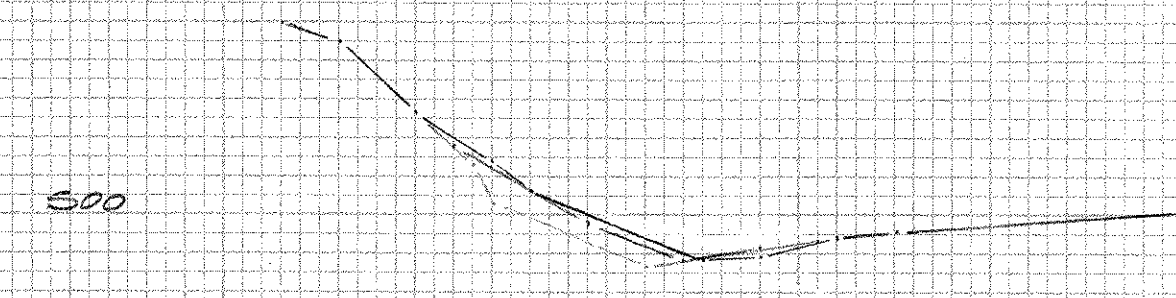

SHARENAH - BRIDPORT - ADDISON  
 F 07-12  
 COMMON EXCAVATION \* STONE FILL TYPE I