


DATE
BY
REVIEWED
PLOTTED
TEMPERATURE
NOTE BOOK
AREAS CHECKED
NO.


DATE
BY
REVIEWED
PLOTTED
TEMPERATURE
NOTE BOOK
AREAS CHECKED
NO.

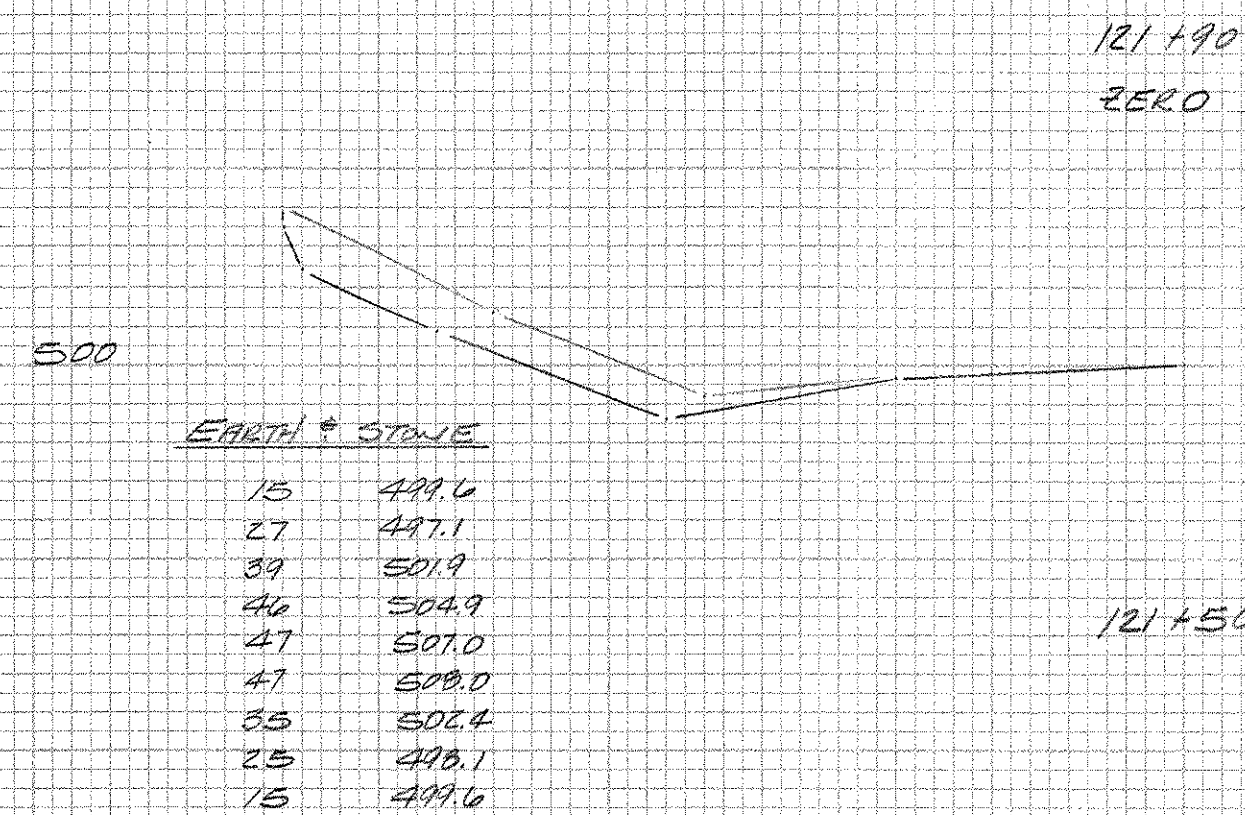

EARTH & STONE

15	499.6
27	497.1
39	501.9
46	504.9
47	507.0
47	509.0
35	502.4
25	498.1
15	499.6


C = 48.95
S.F. = 48.75

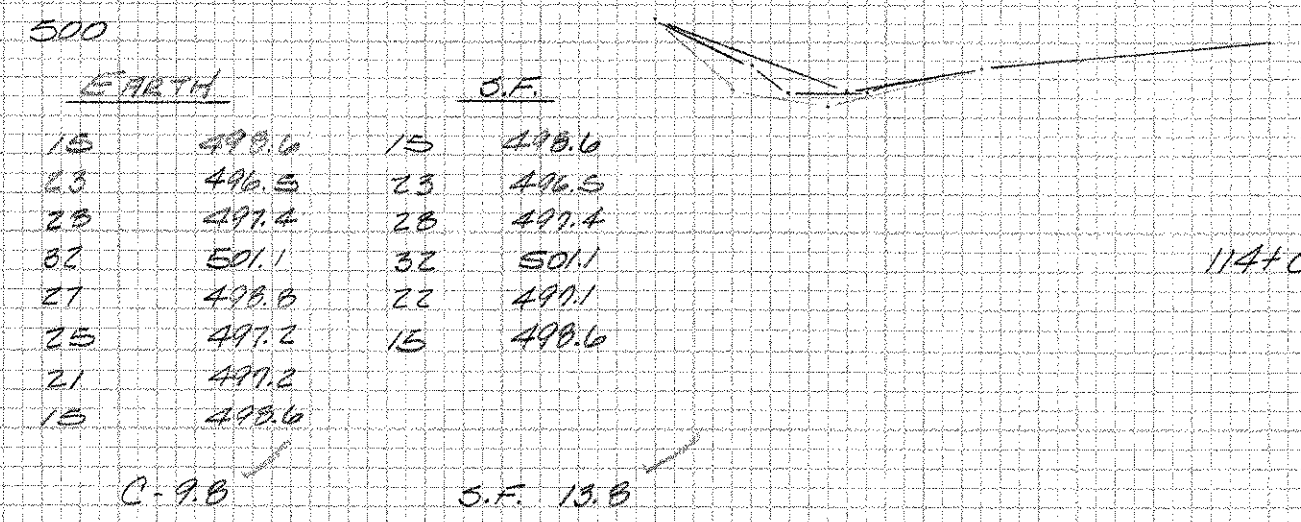

EARTH S.F.

15	498.6	15	498.6
23	496.5	23	496.5
28	498.4	28	498.4
32	501.1	32	501.1
37	498.8	22	498.1
25	497.2	15	498.6
21	497.2		
15	498.6		


C = 9.8 S.F. 15.8

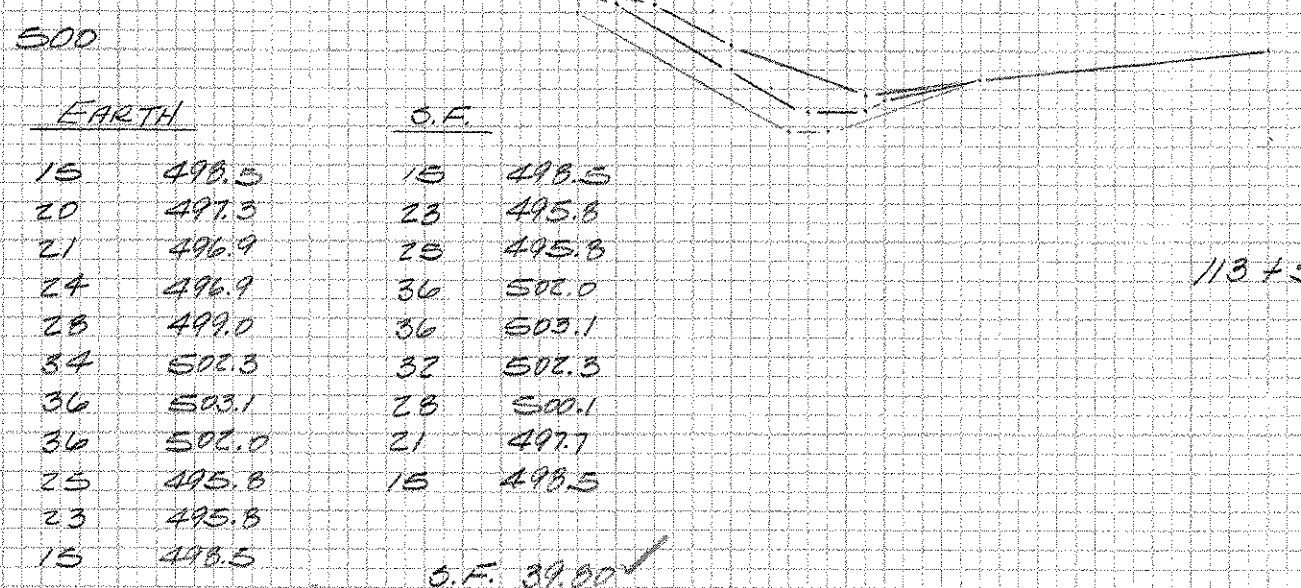

EARTH S.F.

15	498.5	15	498.5
20	497.5	23	495.8
21	496.9	28	495.8
24	496.9	36	502.0
28	499.0	36	503.1
34	502.5	32	502.3
36	503.1	25	500.1
36	502.0	21	497.7
25	495.8	15	498.5
23	495.8		
15	498.5		


C = 21.70 S.F. 39.00

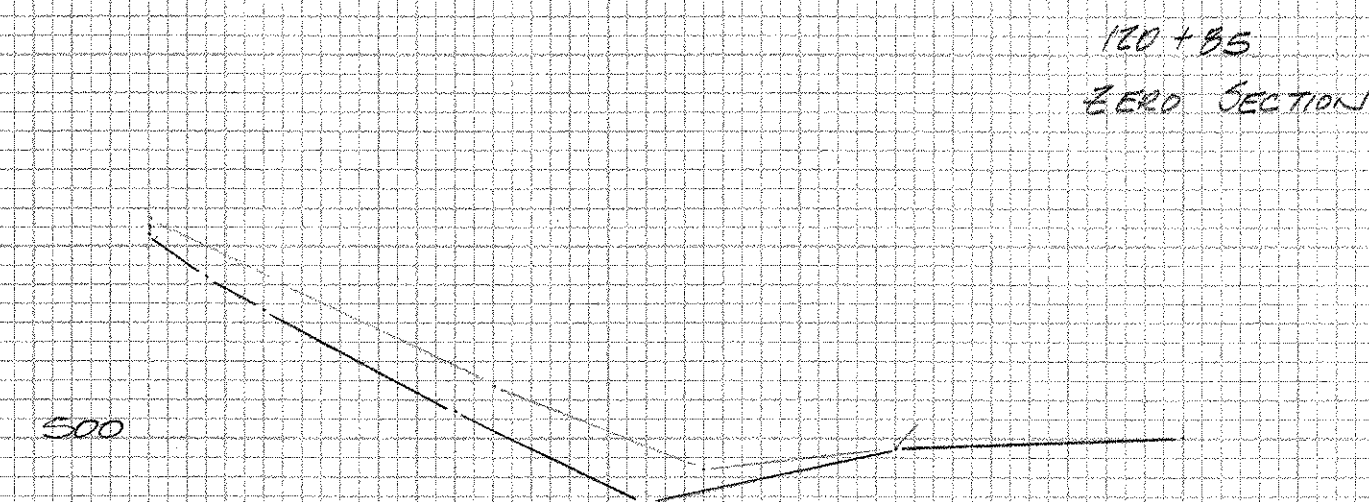

EARTH & STONE

15	499.5
25	496.7
38	501.3
48	504.4
51	508.4
54	510.6
54	511.4
47	508.0
36	502.5
25	498.3
15	499.5

C = 67.55
S.F. = 67.55


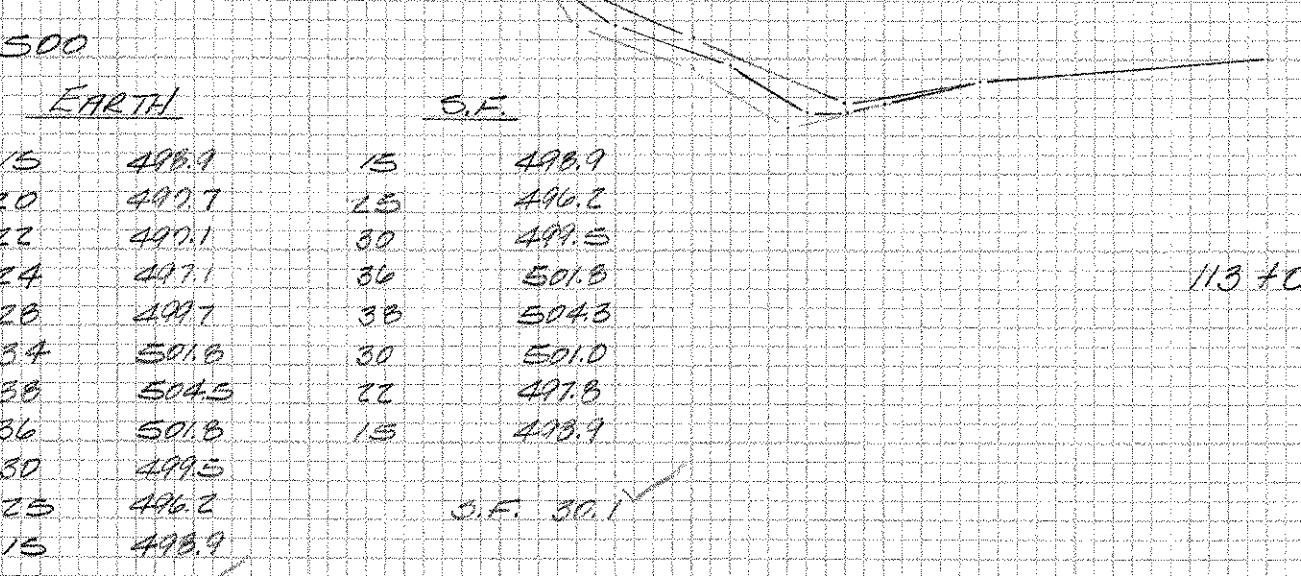


EARTH S.F.

15	498.9	15	498.9
20	497.7	25	496.2
22	497.1	30	499.5
24	497.1	34	501.8
28	497.7	38	504.3
34	501.8	30	501.0
35	504.5	22	497.8
36	501.8	15	498.9
30	499.5		
25	496.2		
15	498.9		

C = 16.25 S.F. 30.1

112+25	EXCAV.	66.80	67.85	S.F.	77.65	71.90
+50	25	66.80	67.85		77.65	71.90
+50	50	66.80	70.90		77.65	69.77
113+0	50	16.25	35.14		30.10	64.91
+50	50	21.70	29.17		39.80	49.63
114+0	50	9.80	203.06		15.80	286.22

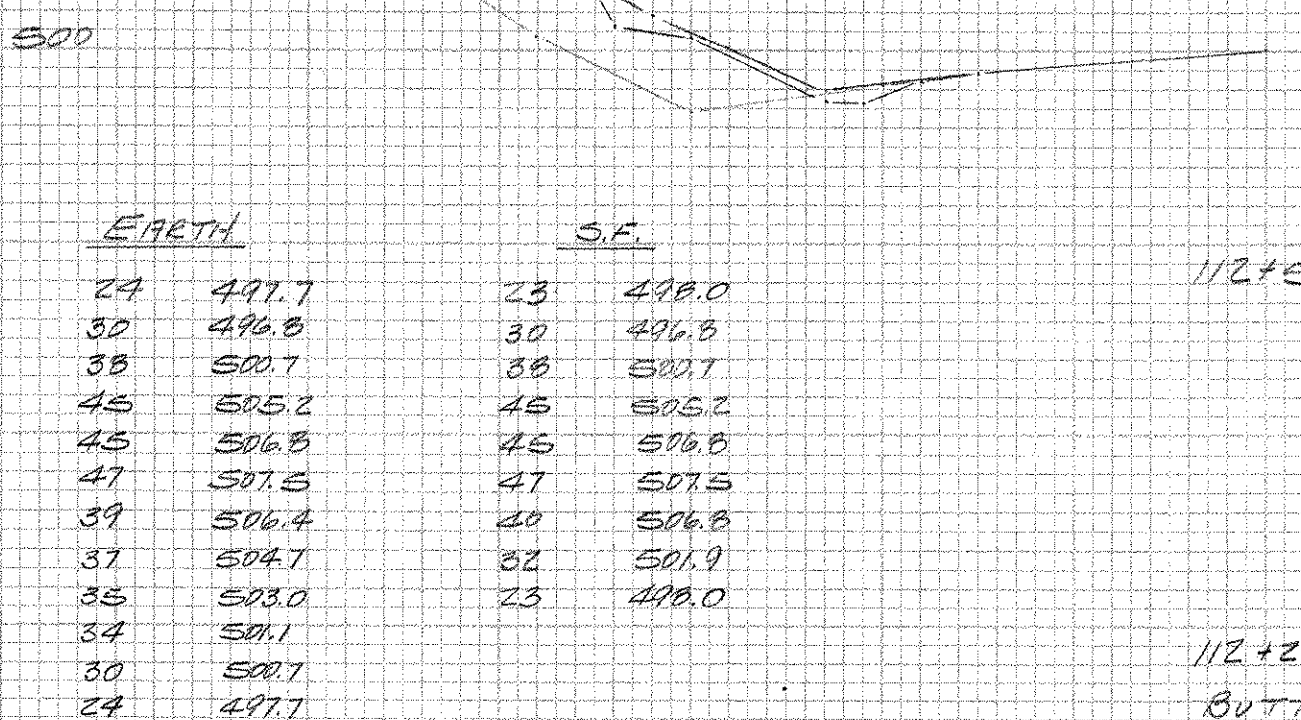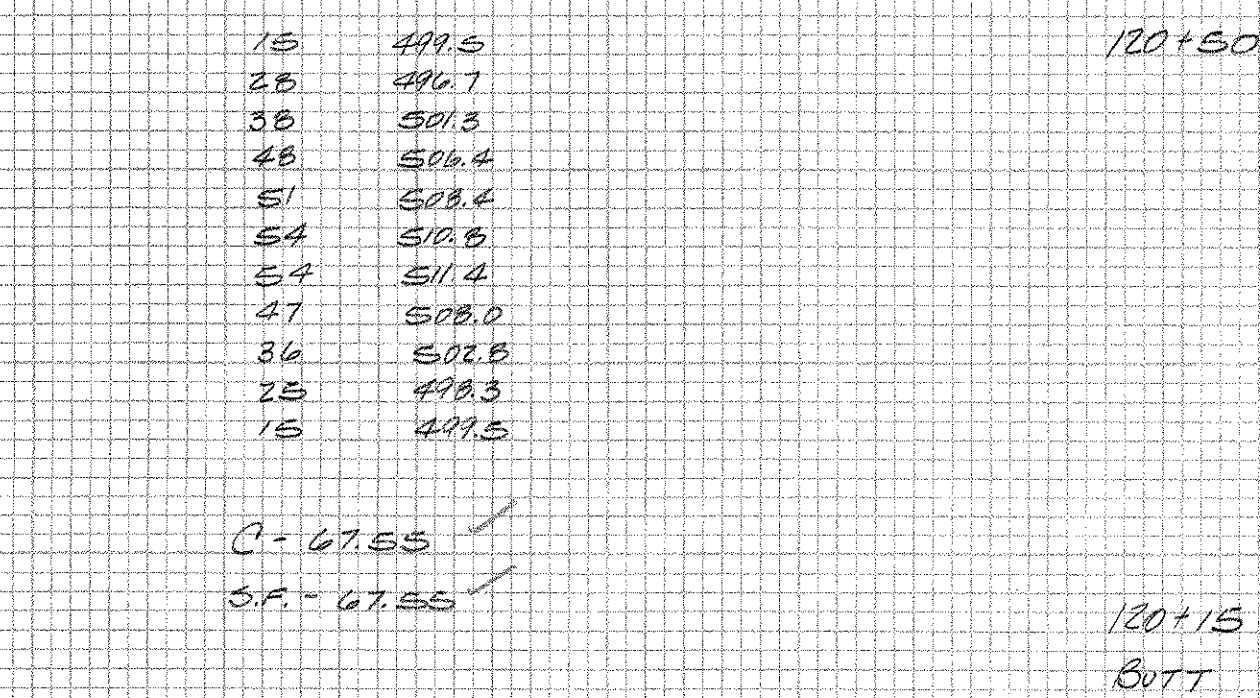

EARTH S.F.

24	497.7	23	498.0
30	496.8	30	496.8
38	500.7	38	500.7
45	505.2	45	505.2
45	506.5	45	506.5
47	507.5	47	507.5
39	506.4	30	506.8
37	504.7	32	501.9
35	503.0	23	498.0
34	501.1		
30	500.7		
24	497.7		

C = 66.80 S.F. 77.65

120+15	EXCAV.	67.55	67.55	S.F.	67.55	67.55
+50	35	67.55	67.55		67.55	67.55
+50	35	67.55	43.78		43.78	43.78
+50	0	181.84.04	0		181.84.04	181.84.04
121+40	EXCAV.	48.95	48.95	S.F.	48.95	48.95
+50	10	48.95	18.15		18.15	18.31
+50	40	48.95	36.26		48.95	36.26
+90	0	54.29	54.29		0	54.29

185.78 COMMON
185.73 S.F. TYPE I

SHOREHAM - BRIDPORT - HADISON
F 017-1(E)

Also X-SECTION FOR SLOPE
STABILIZATION - S.F. TYPE I *
COMMON EXCAVATION