


FINAL SURVEY
 NO. _____
 DATE _____
 BY _____
 APPROVED
 PLOTTED
 NOTE BOOK
 TEMPLATE
 AREA ENGINEER

ORIGINAL SURVEY
 NO. _____
 DATE _____
 BY _____
 APPROVED
 PLOTTED
 NOTE BOOK
 TEMPLATE
 AREA ENGINEER

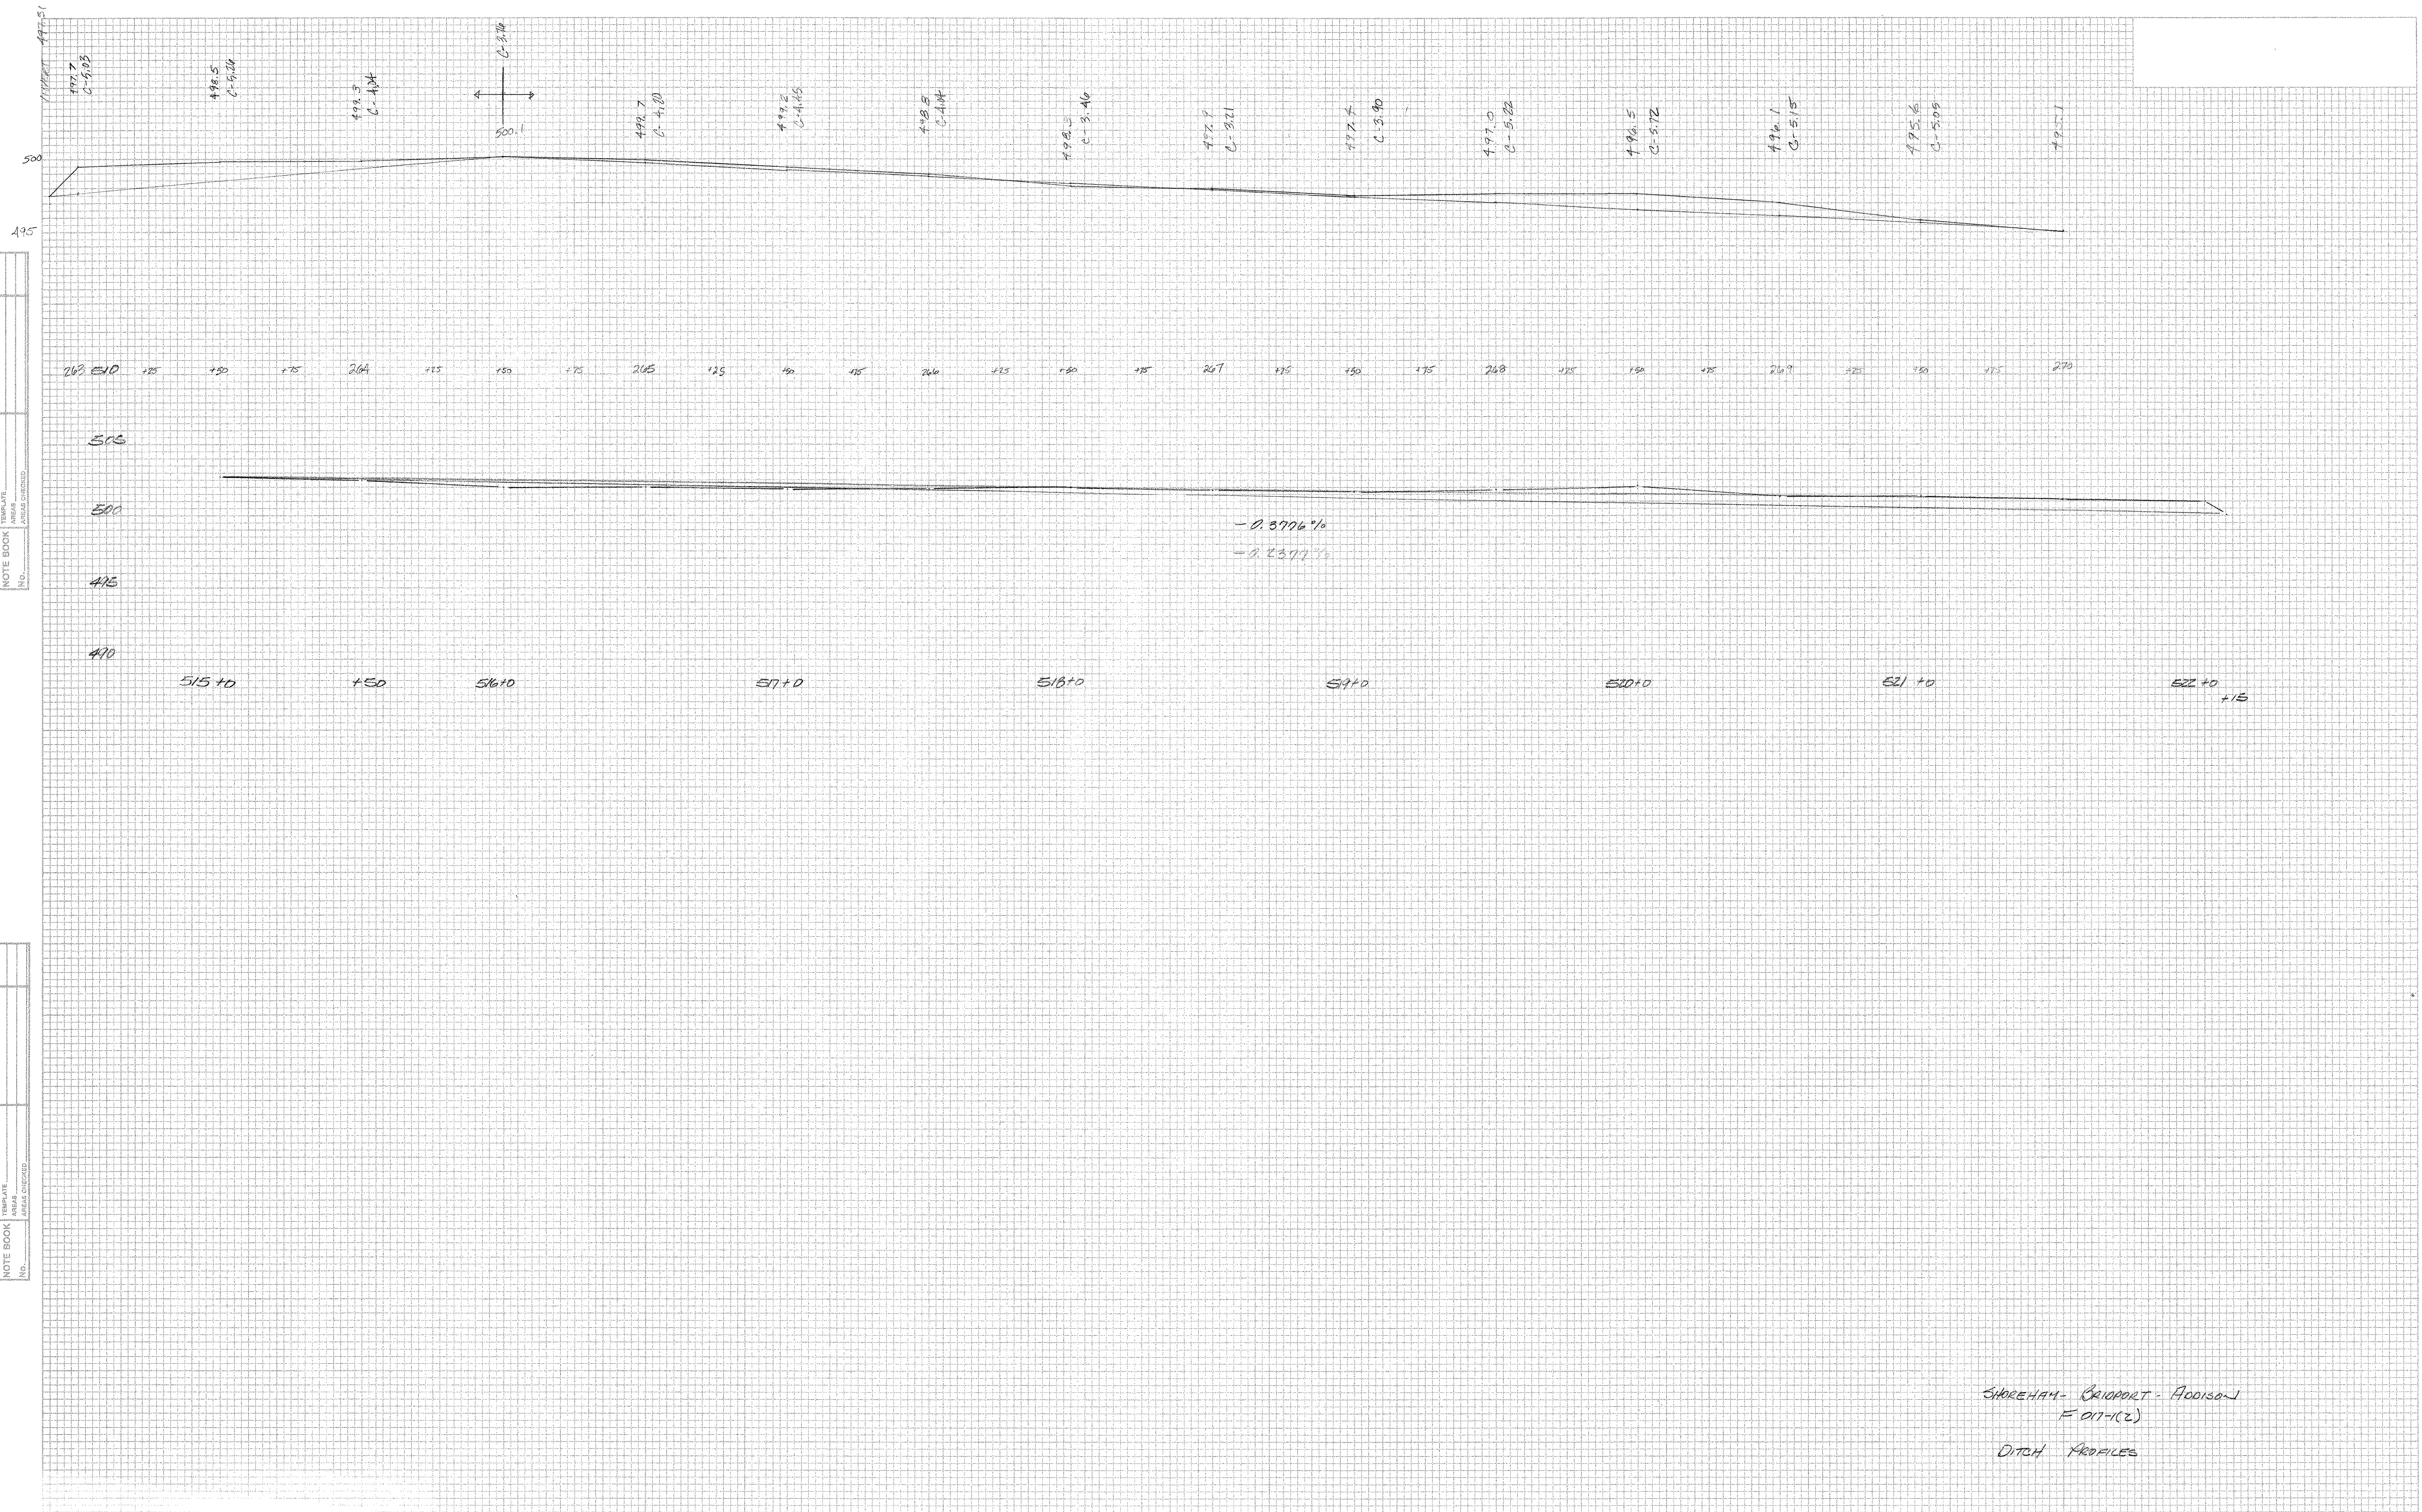

SHREHAN - BRIDPORT - ADDISON
 F 017-(2)
 DITCH PROFILES