


DATE \_\_\_\_\_ BY \_\_\_\_\_  
 SURVEYED BY \_\_\_\_\_  
 ORIGINAL SURVEY NOTE BOOK No. \_\_\_\_\_  
 TEMPLATE \_\_\_\_\_  
 AREAS \_\_\_\_\_  
 ADJUSTED \_\_\_\_\_

DATE \_\_\_\_\_ BY \_\_\_\_\_  
 SURVEYED BY \_\_\_\_\_  
 ORIGINAL SURVEY NOTE BOOK No. \_\_\_\_\_  
 TEMPLATE \_\_\_\_\_  
 AREAS \_\_\_\_\_  
 ADJUSTED \_\_\_\_\_




3 x 10' Stone Pad @ OUTLET


+47  
 431+53 BK 2H p 13  
 18" RCP Retain  
 Remove top 2' of inlet headwall; extend inlet w/ 18" x 4" RCP from outlet;  
 relay next 4' section & outlet;  
 replace removed 4' section & outlet w/ New 24" x 5"

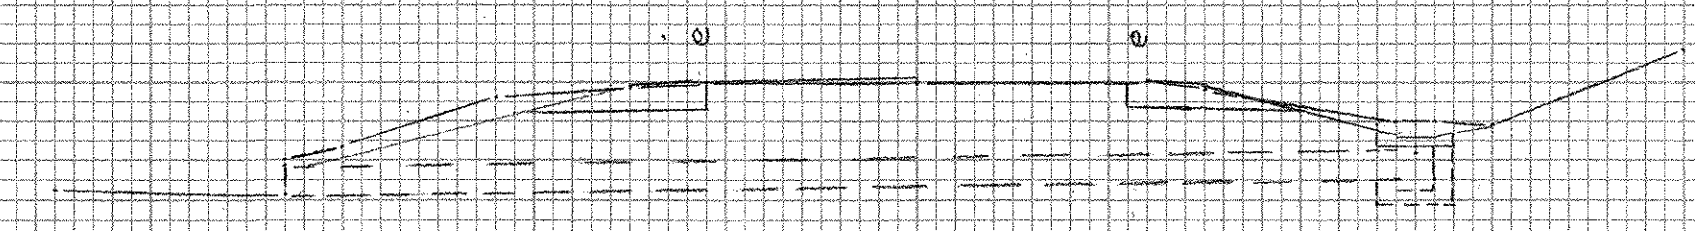


+25  
 451+25 BK 2H p 67  
 18" RCP Retain  
 Lower D.I. walls 1' & replace cover  
 w/ New C.I. Grate, Type B

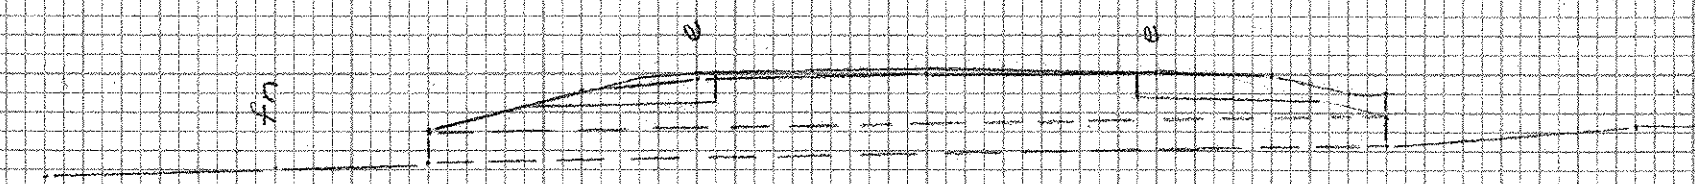

+42  
 424+47 BK 2H p 1  
 18" RCP Retain  
 Remove top 2' headwall  
 clean outlet ditch 10' ± w/ rental items

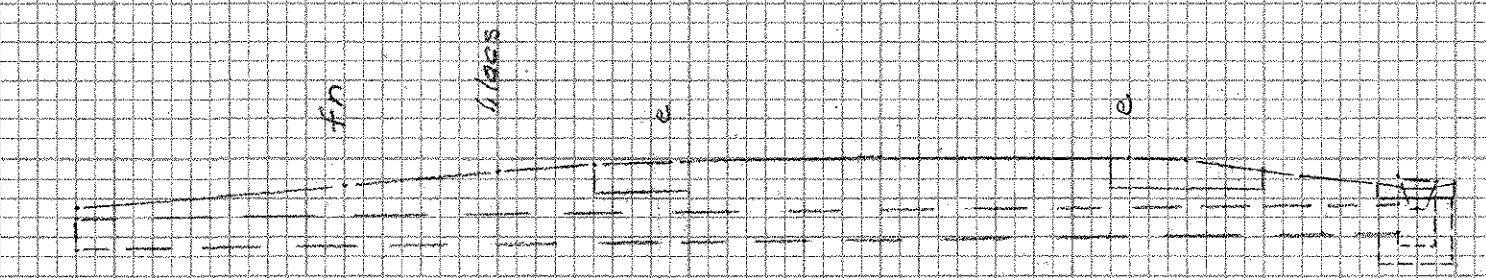


+90  
 440+95 = 75° Rt BK 2H p 43  
 18" RCP Retain  
 Lower D.I. walls 1' & replace cover  
 w/ New C.I. Grate, Type A

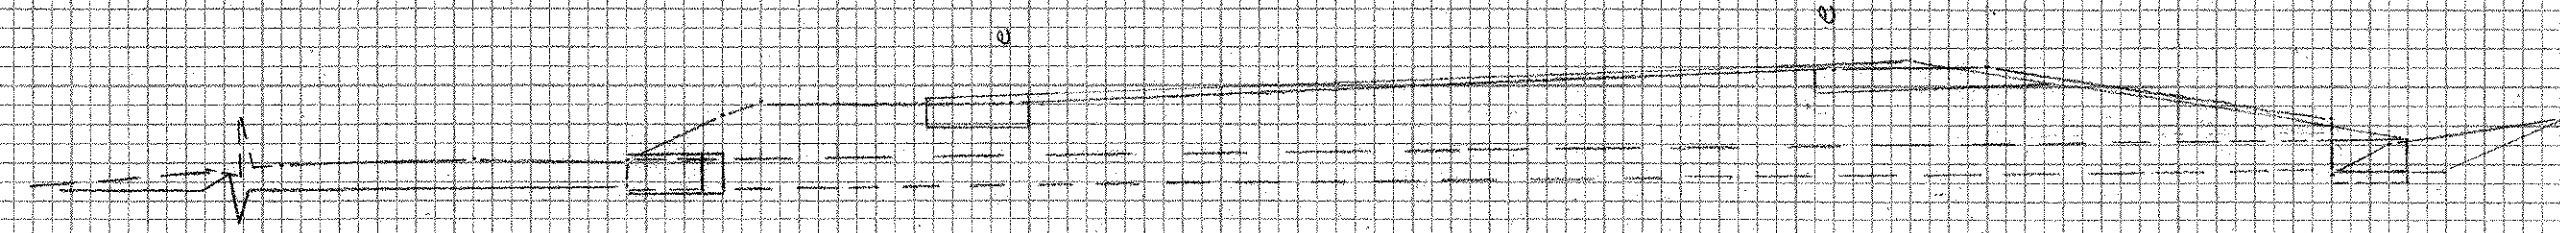

Ditch Cleaning - 100' ±  
 to be paid under A11  
 Average Excavator Rental  
 & Truck Rental

+33  
 422+33 @ 36° Lt BK 2G p 131  
 18" RCP Retain  
 Remove top 2' of inlet headwall; extend inlet w/ 4" x 18" RCP from outlet  
 replace removed 4' section & outlet w/ New 24" x 5"

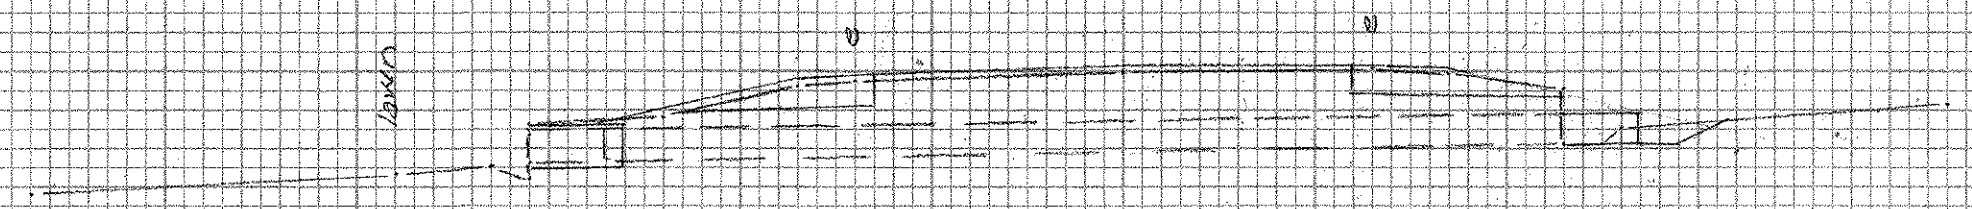

+10  
 436+45 @ 62° Rt BK 2H p 19  
 18" RCP Retain  
 Remove top 2' of inlet headwall; extend inlet w/ 18" x 4" RCP from outlet  
 replace removed 4' section & outlet w/ New 24" x 5"

SHOREHAM - BRIDFORD - ADDISON  
 F 017-1(2)  
 DRAINAGE SHEET NO. 5 OF 11