


NO.	DATE	BY	REVISION
1	11/10/08	JK	Initial

NO.	DATE	BY	REVISION
1	11/10/08	JK	Initial

520

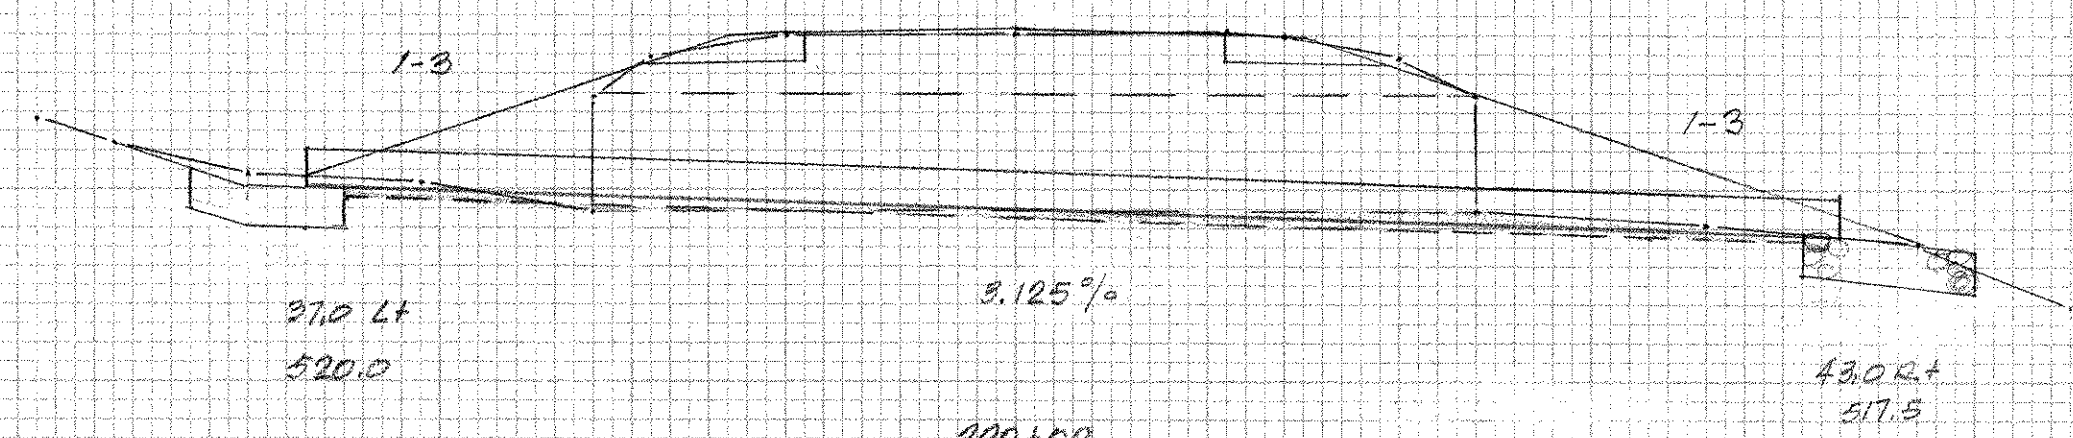

3.125%
 320+00
 REMOVE EXISTING 12" CAME PASS
 NEW 24" x 20" PCCSP
 BK 2E x 43

TRENCH EXCAV (Temp 24" removal)
 $40' \times 4.1 \times 1.5 = 277 = 9.1 \text{ cy}$
 field
 miss. p/ou/ro
 see

TRENCH EXCAV (New 24")
 $17' \times 4 \times 2 = 136 \text{ cf}$
 stone
 4.1 cf

STRUCTURE EXCAV (removal)
 $(300 \text{ sf} \times 12.1) - (\frac{6^2}{2} \times 15.46) = 277 = 122.1 \text{ cy}$

Jard Borrow
 $77 \times 0.5 \times 12.1 \times 1/27 = 17.3 \text{ cy}$

SHOREHAM - BUDGET - ADDISON
 F 017-1(2)
 DRAINAGE SHEET No. 10 OF 11