



DESIGNED	DATE
CHECKED	
DRAWN	
IN CHARGE	
PROJECT	
SHEET	
DATE	


DESIGNED	DATE
CHECKED	
DRAWN	
IN CHARGE	
PROJECT	
SHEET	
DATE	

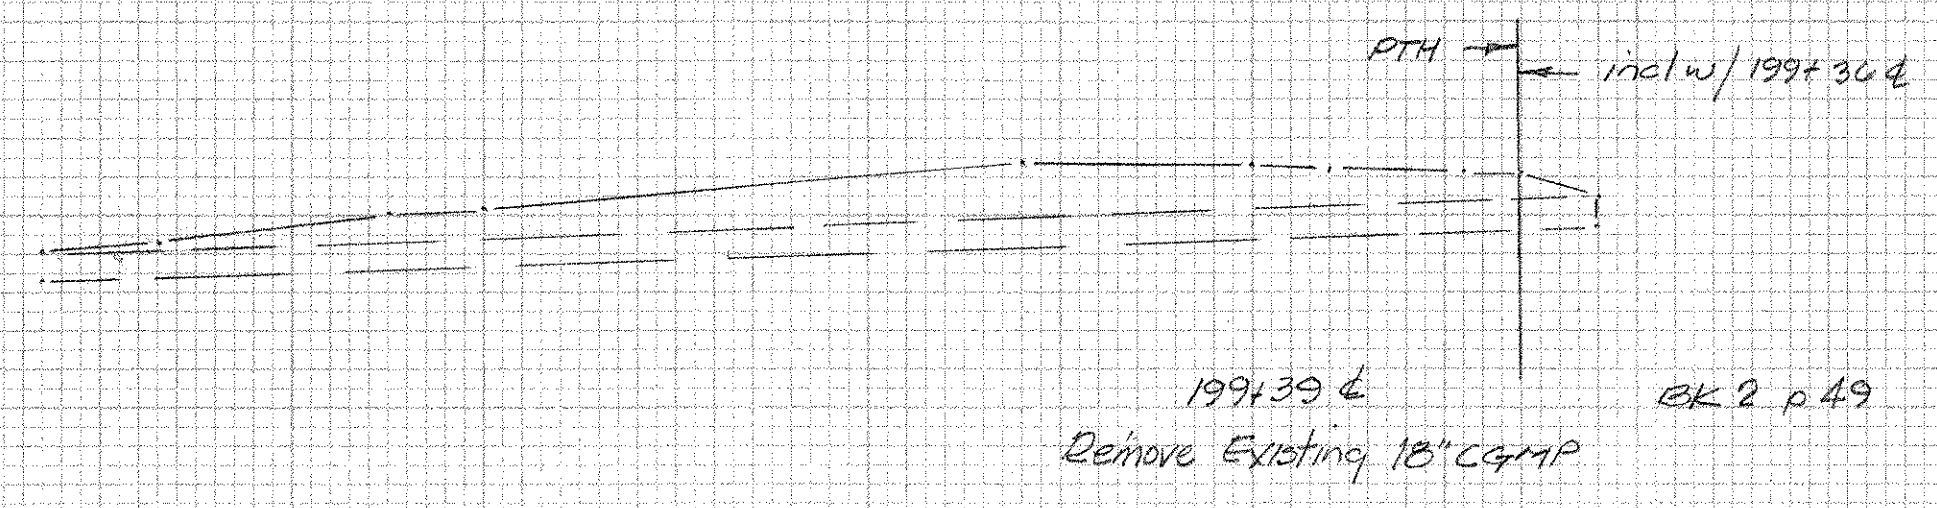


2400' x 3.6' x 27' = 35 cu yd
 2000' x 3.6' x 27' = 35 cu yd
 9/11/90

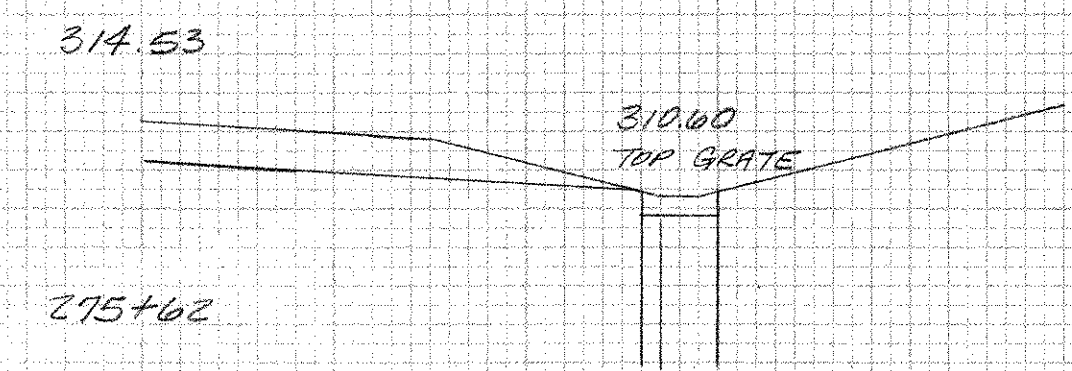


	TANGENT	V.C. CORR.	ON V.C.
275+0	309.45	-0.00	309.45
+14.10	310.74	-0.03	310.71
+17.29	311.03	-0.05	310.98
+30.00	312.20	-0.14	312.06
+42.71	313.36	-0.25	313.11
+45.90	313.65	-0.32	313.33

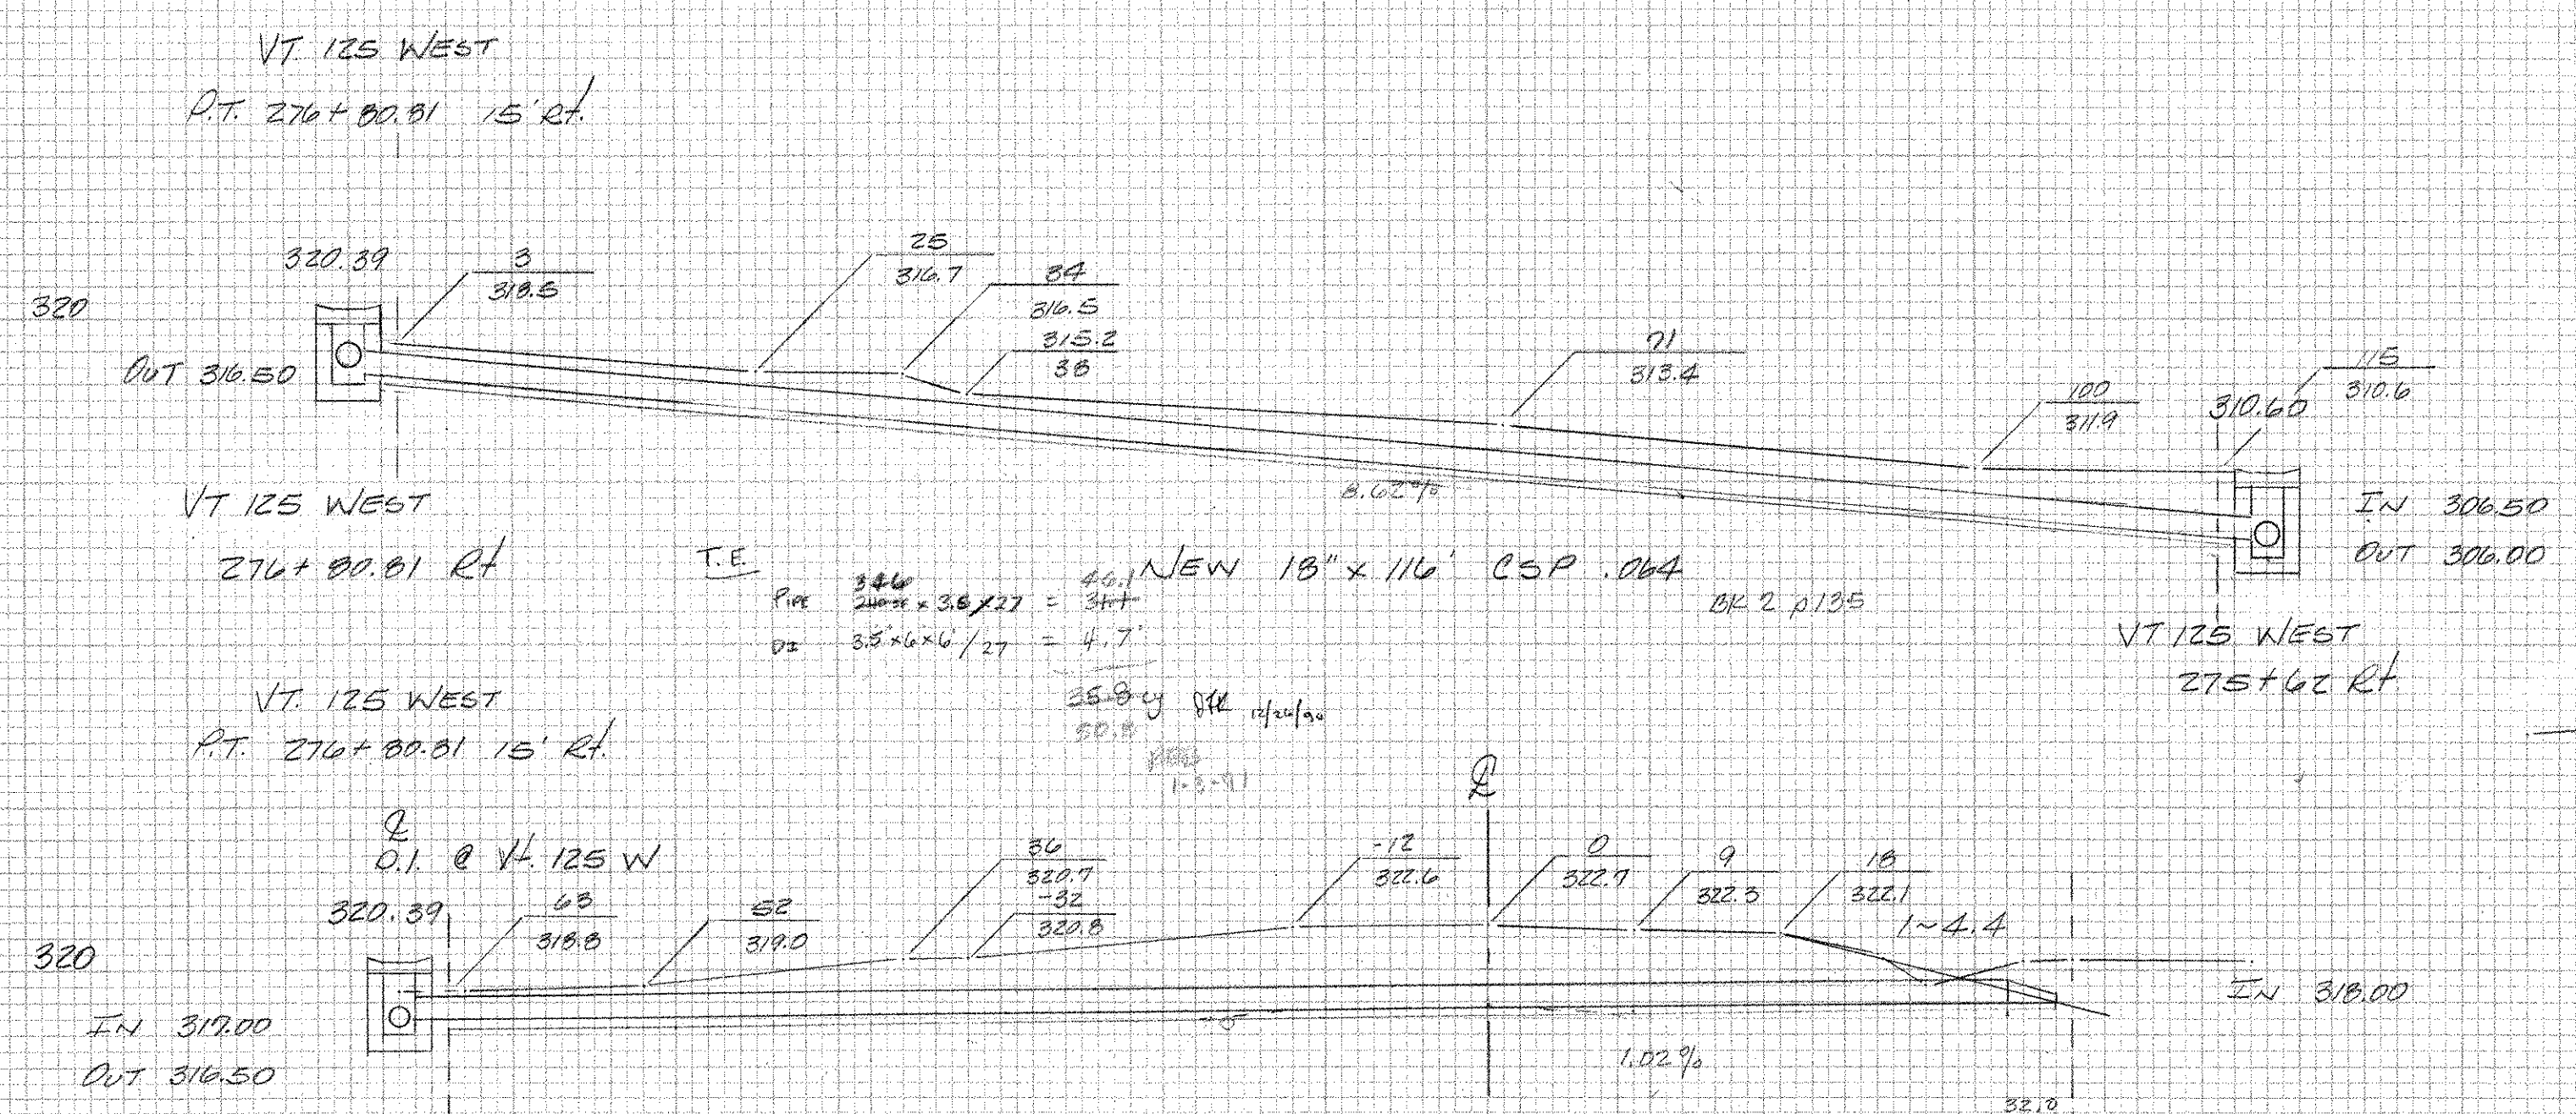

NEW 18" x 116" CSP .064
 BK 2 p 135
 T.E. 3.6' x 3.6' x 27' = 34.7 cu yd
 3.6' x 3.6' x 27' = 34.7 cu yd

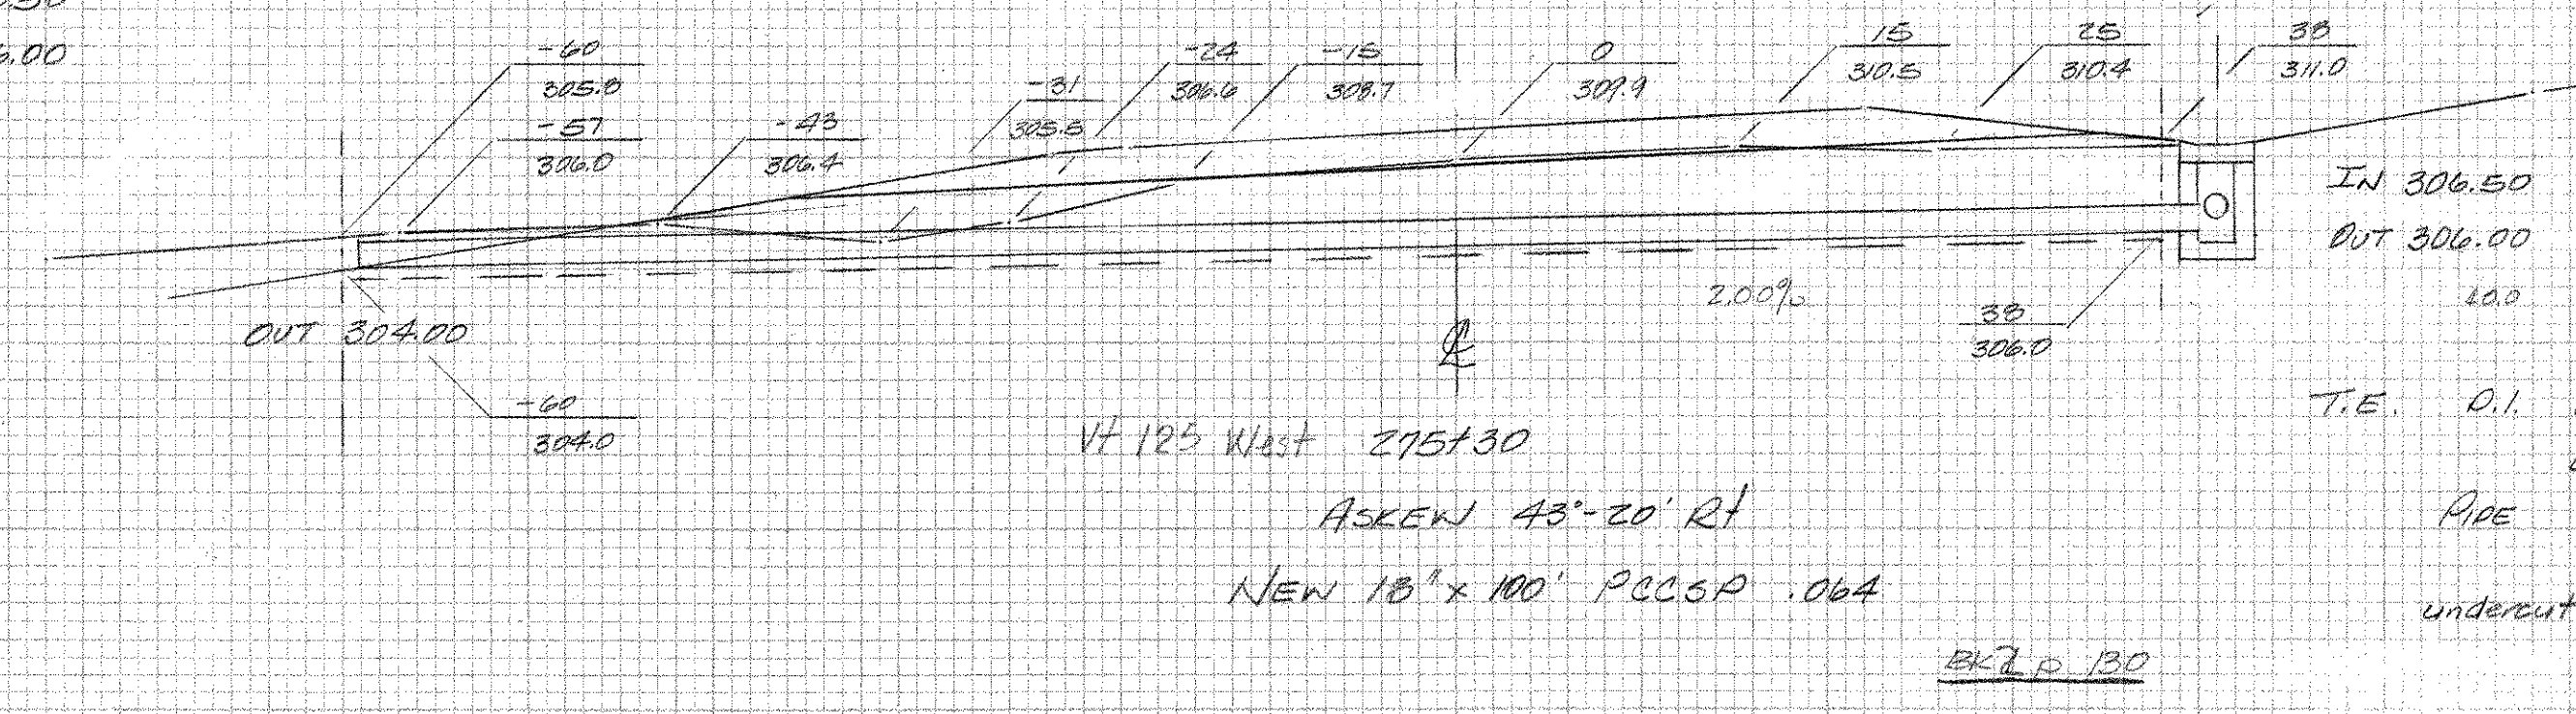

T.E. 3.6' x 3.6' x 27' = 34.7 cu yd
 3.6' x 3.6' x 27' = 34.7 cu yd
 3.6' x 3.6' x 27' = 34.7 cu yd

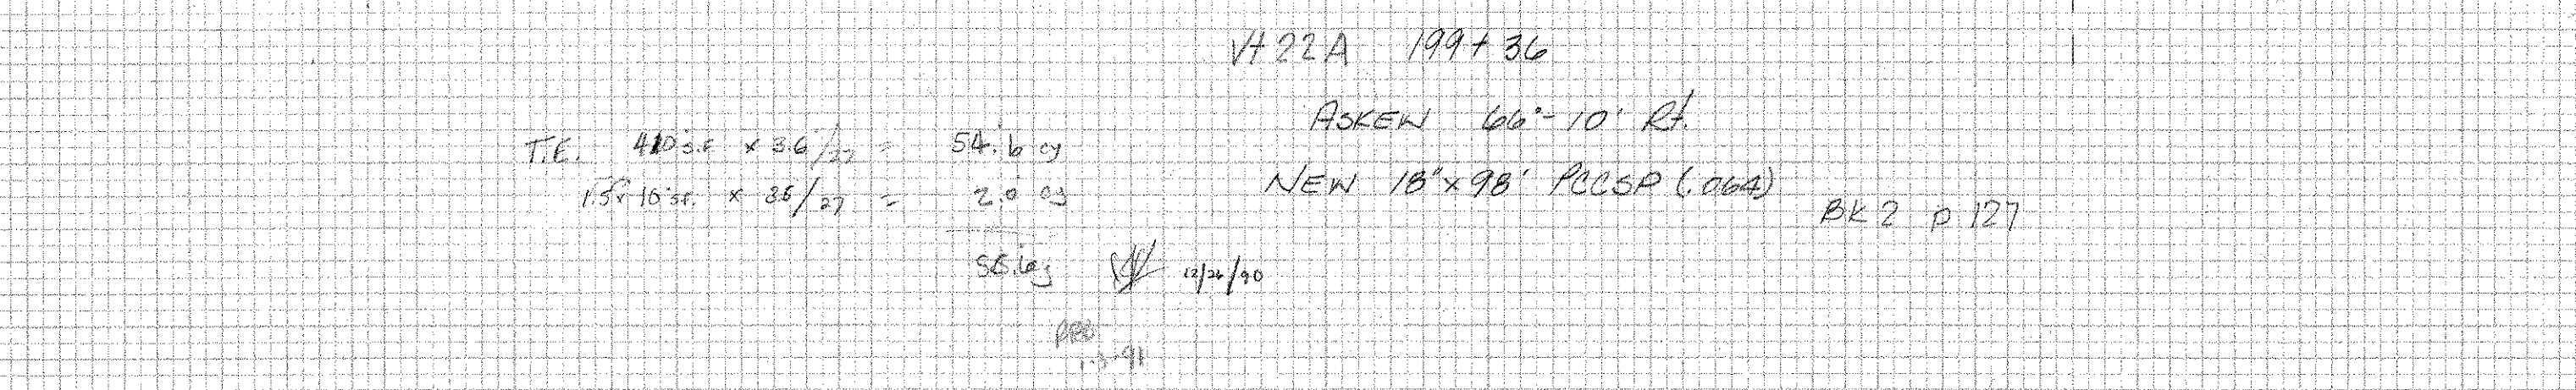

VT 22A 199+36
 ASKEN 60'-10' RT
 NEW 18" x 98" PCCSP (.064) BK 2 p 127
 T.E. 40' x 3.6' x 27' = 54.7 cu yd
 15' x 16' x 3.6' x 27' = 2.0 cu yd

BRIODART HES F017-112
 SHEET 2 OF 3
 DRAINAGE