


FINAL SURVEY NOTE BOOK No. _____
 PROJECTED PLATE AREA SHEET ORDERED

ORIGINAL SURVEY NOTE BOOK No. _____
 PROJECTED PLATE AREA SHEET ORDERED

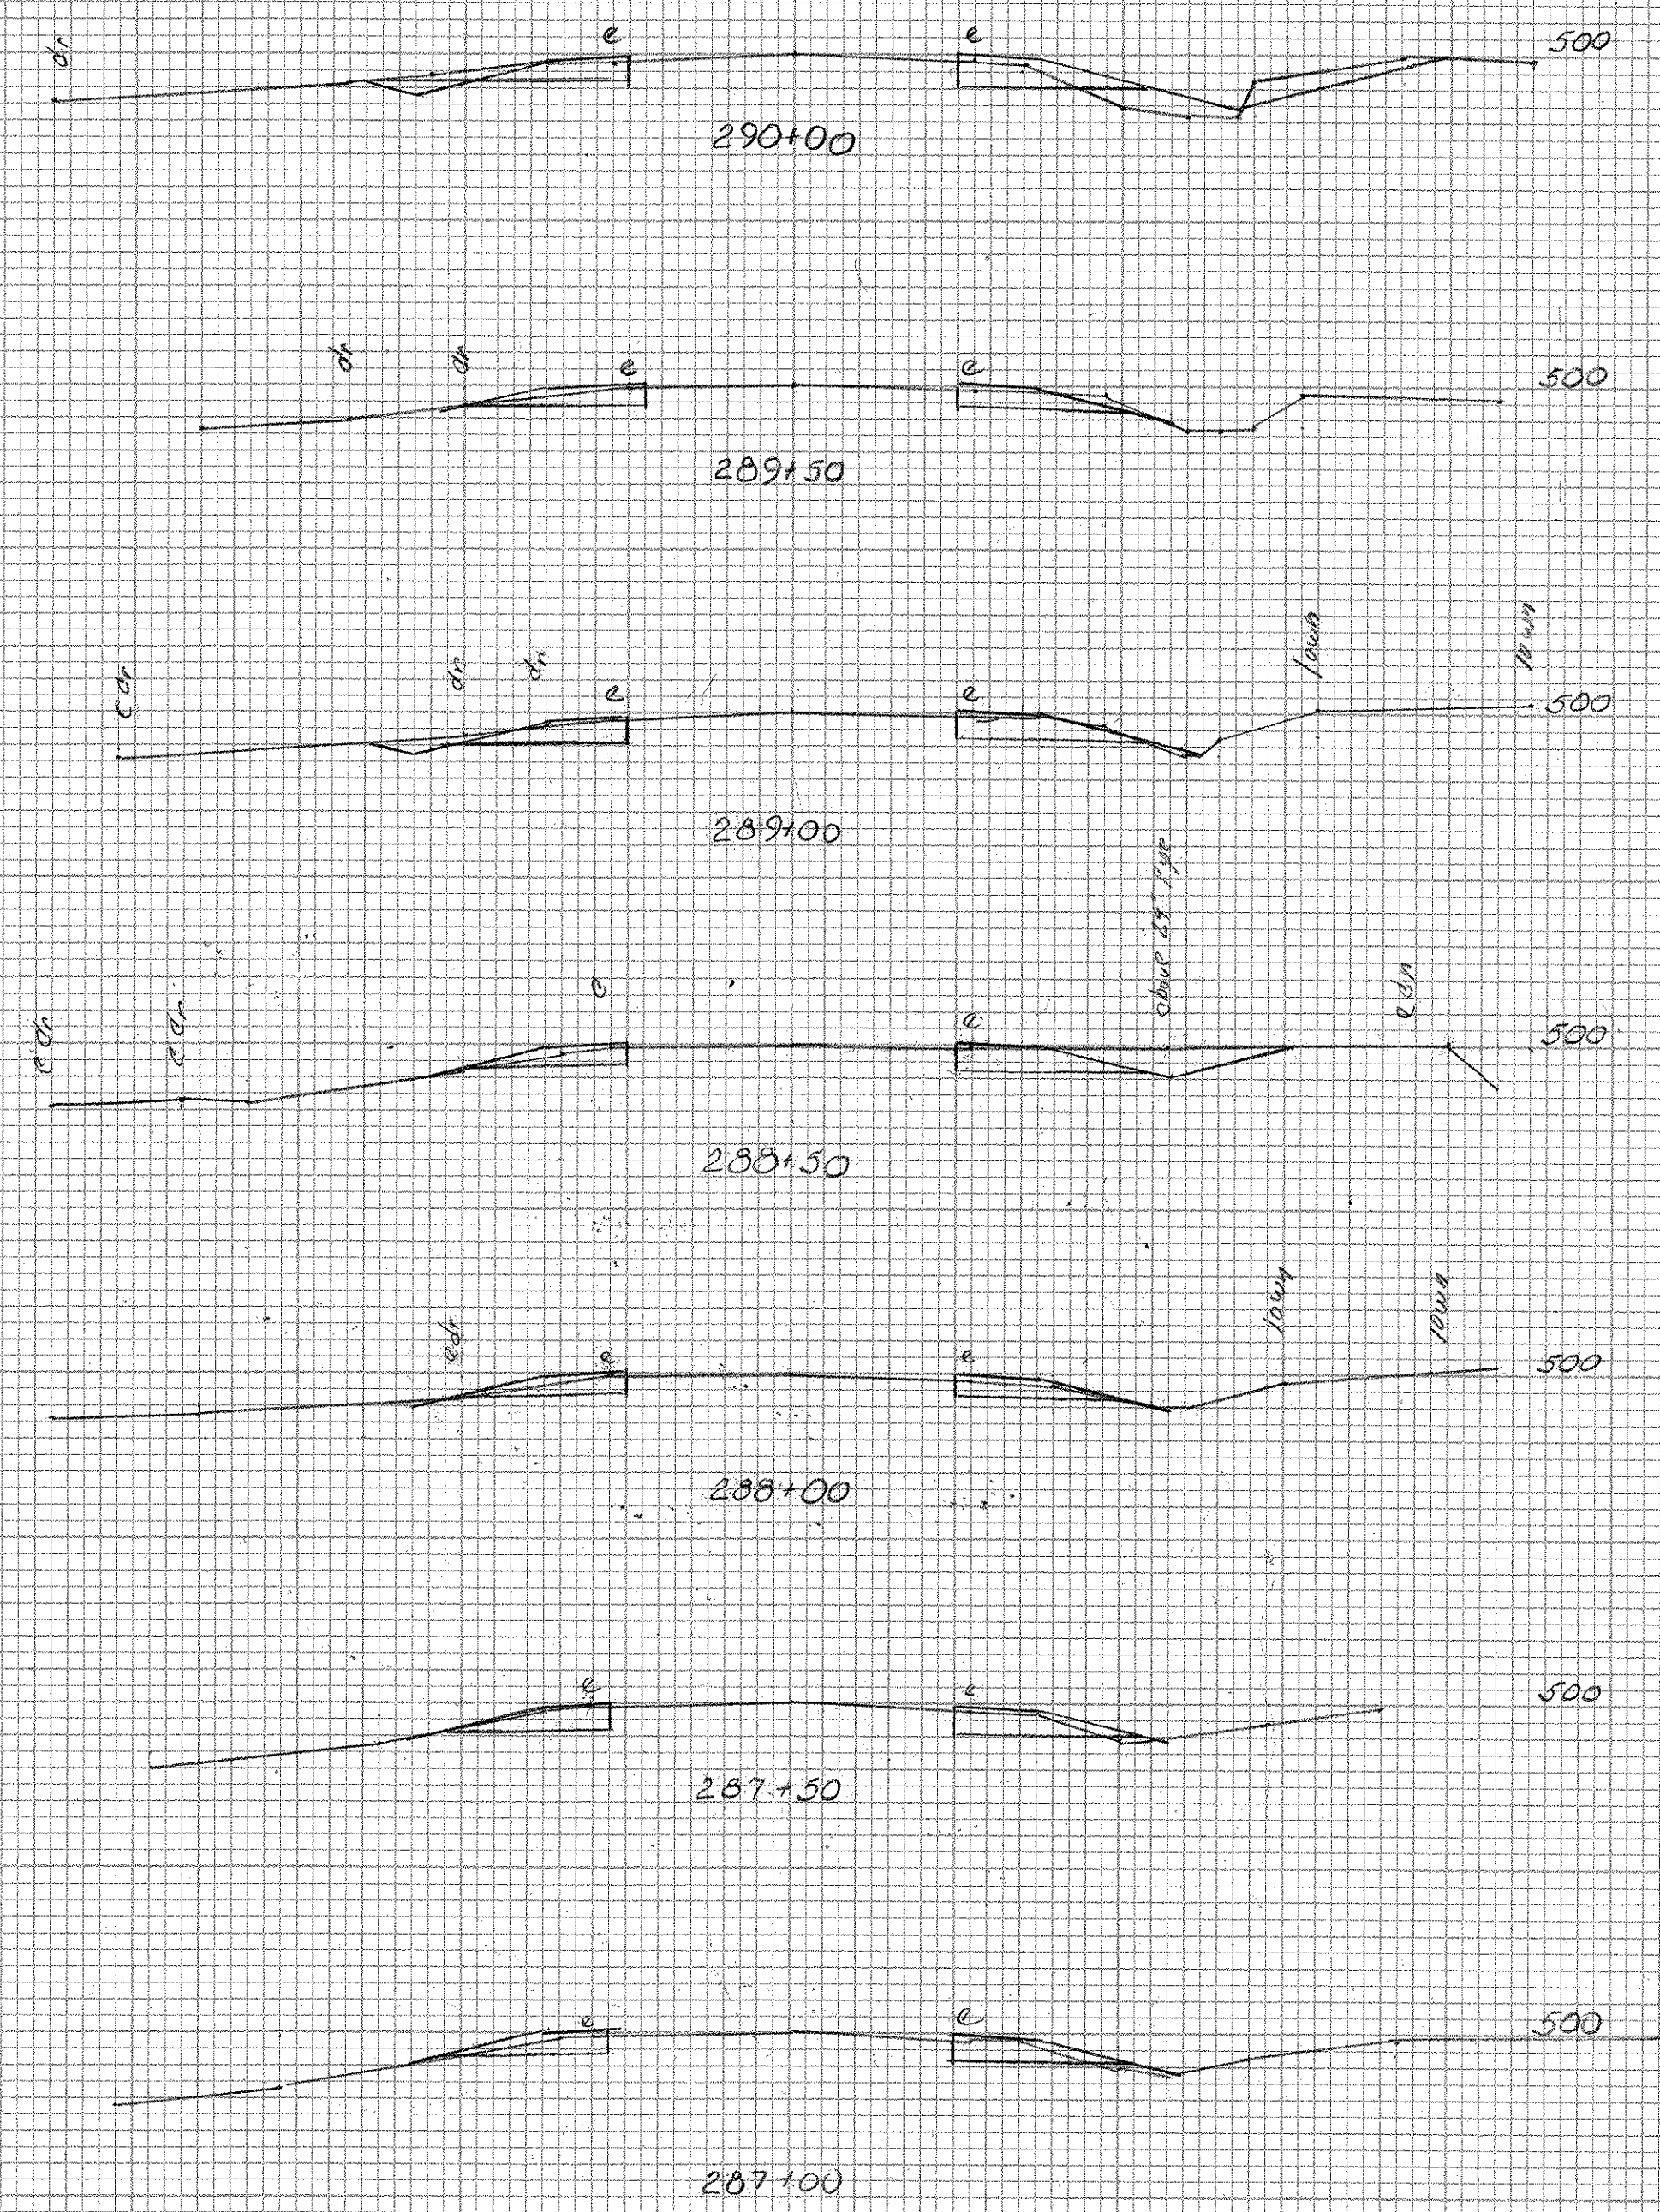

SHOREHAM-BRIDPORT-ADDITION
 FO17-1 (2)

Original Sections
 Plotted R. EUSSEY