
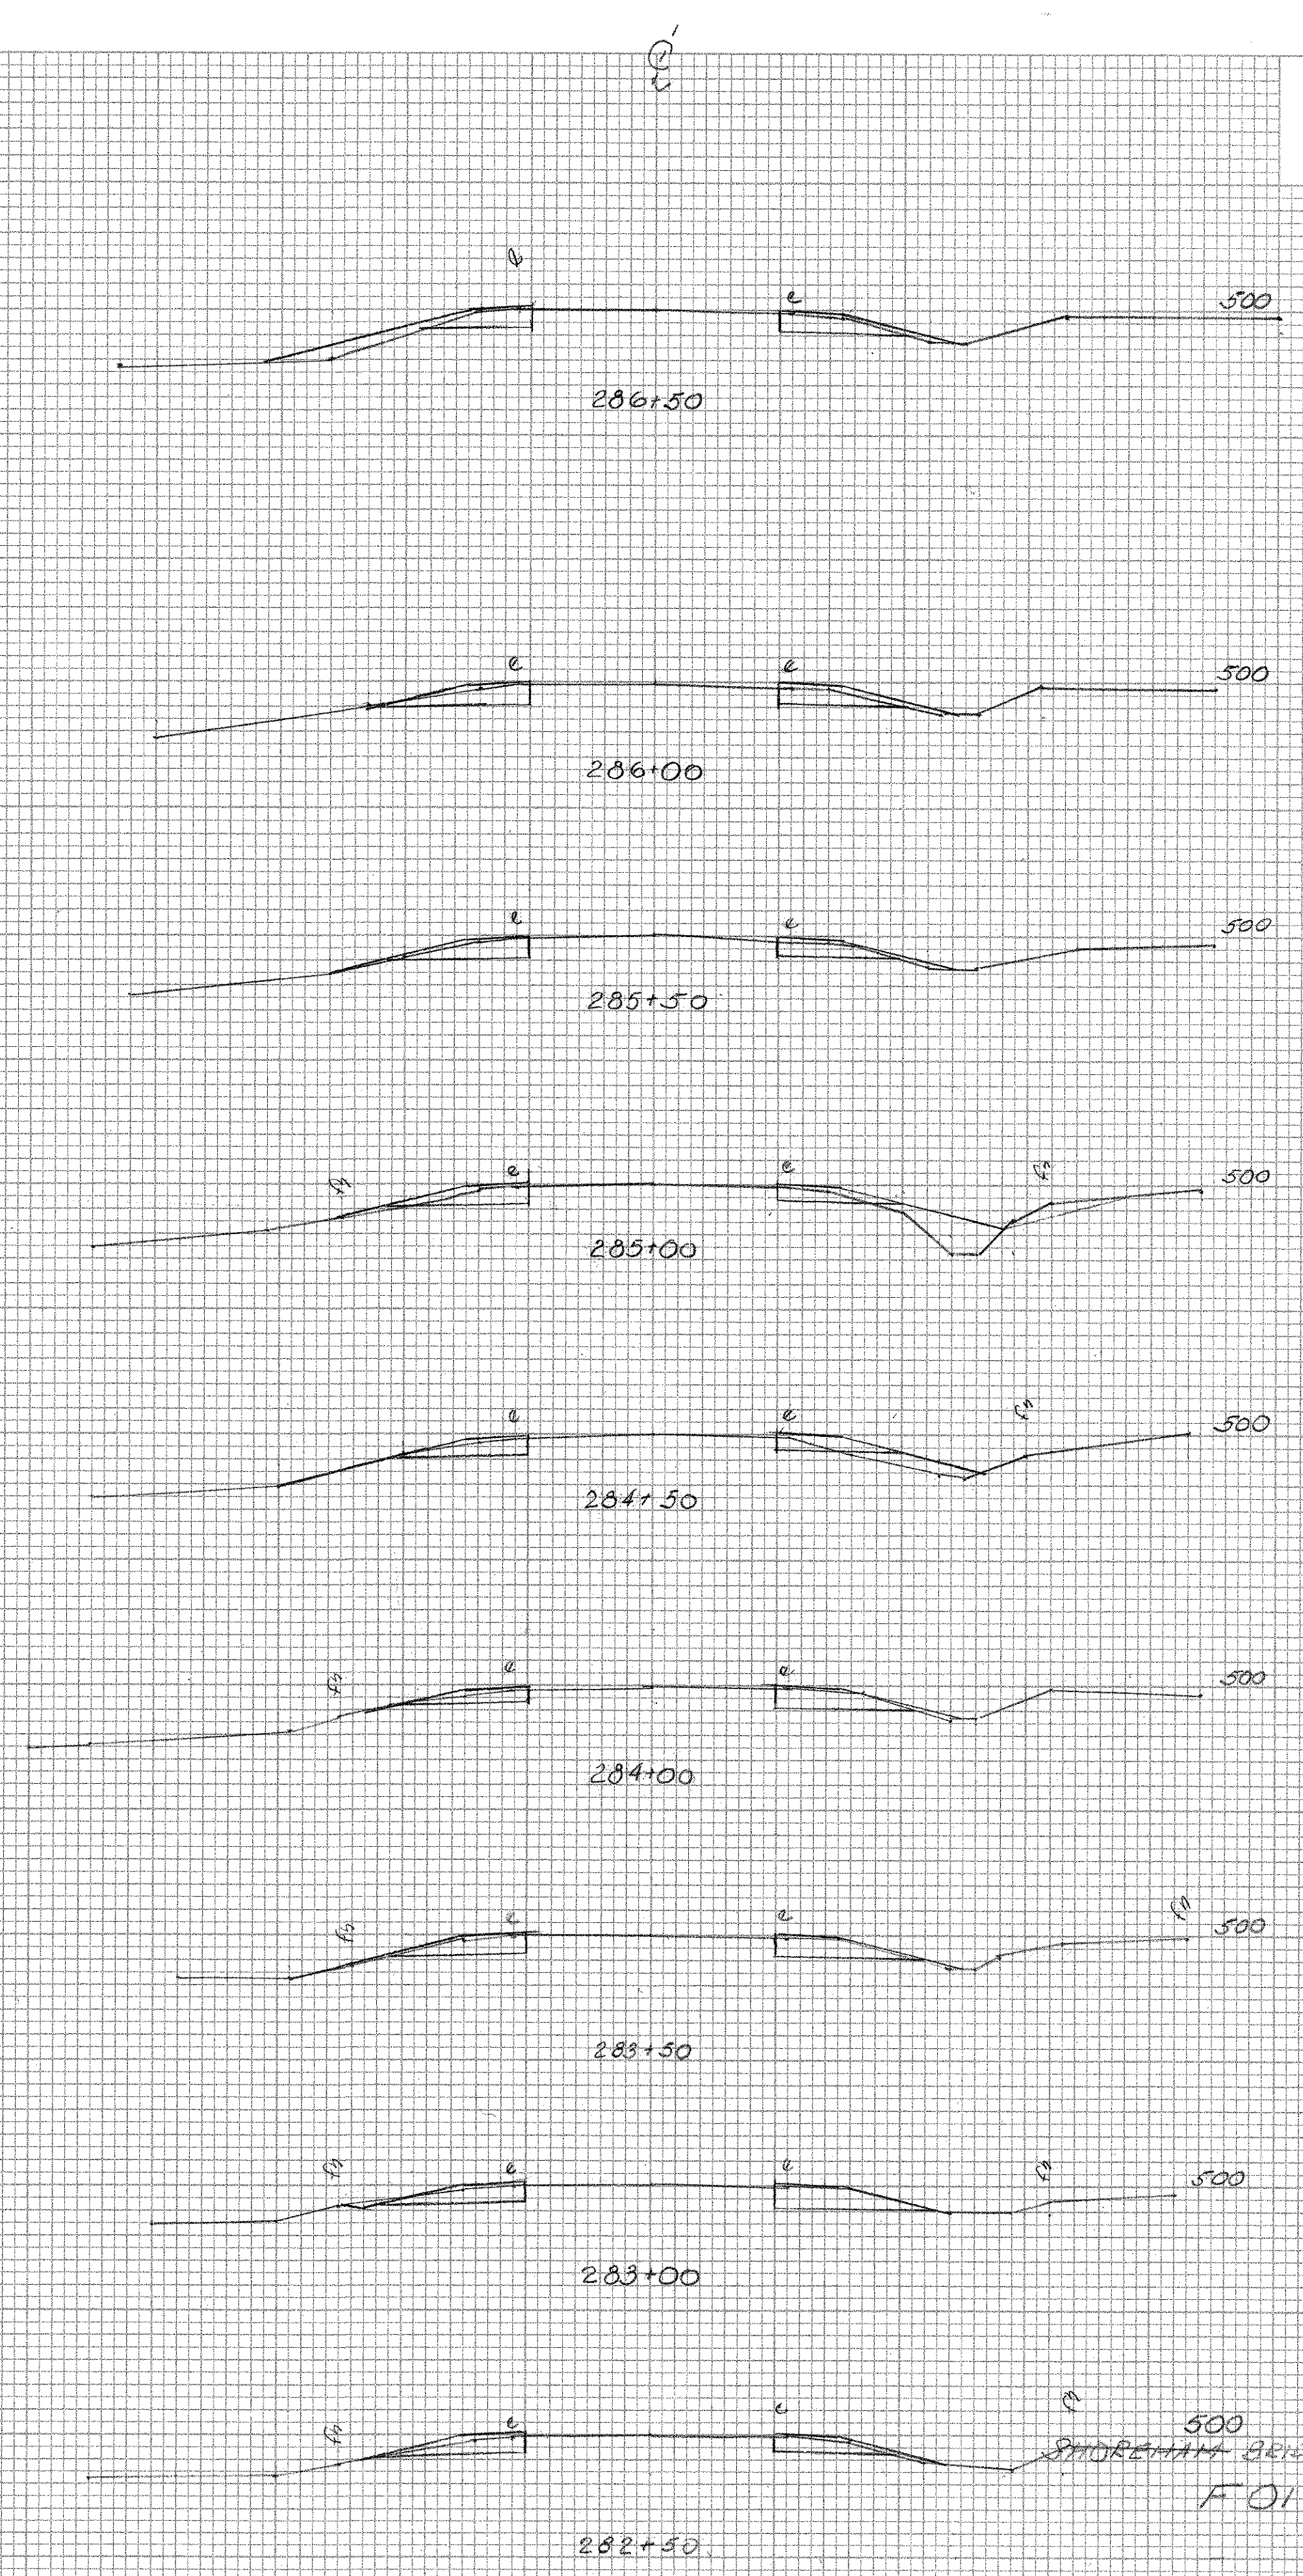


DATE _____
 BY _____
 SURVEYED _____
 REVISION _____
 TEMPLATE _____
 AREA _____
 NO. _____
 FINAL SURVEY NOTE BOOK

DATE _____
 BY _____
 SURVEYED _____
 REVISION _____
 TEMPLATE _____
 AREA _____
 NO. _____
 ORIGINAL SURVEY NOTE BOOK

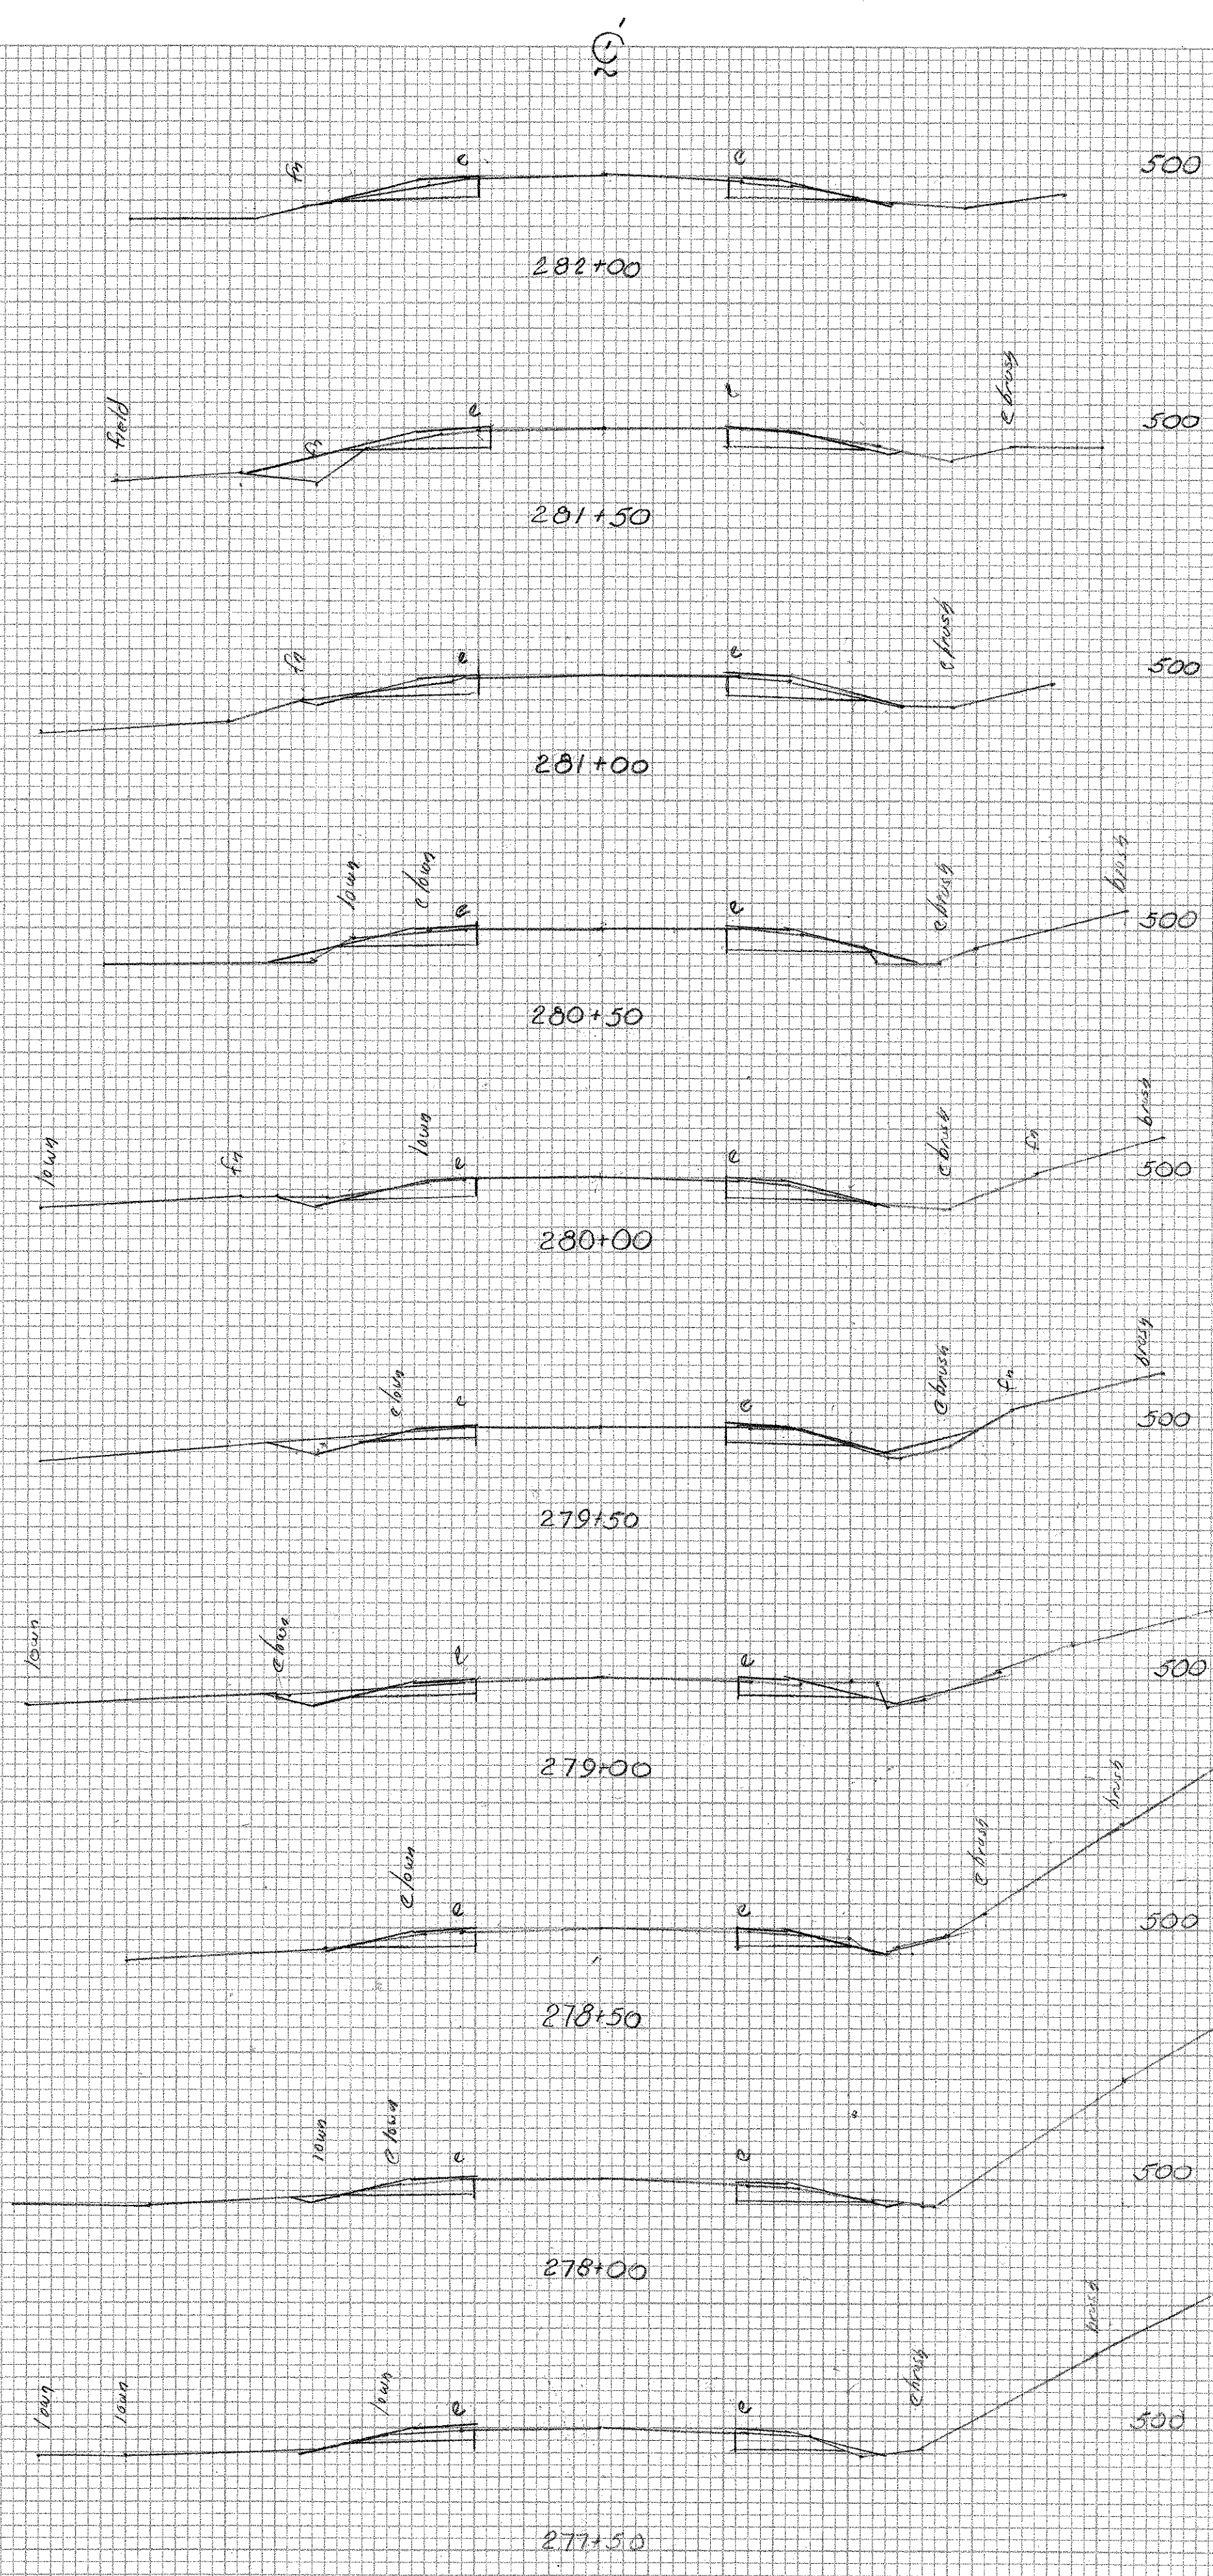

500
 SHORTEST DISTANCE - APPROXIMATE
 FOIT-1 (2)

Original Sections