


NO.	DATE	BY	REVISION
1			
2			
3			
4			
5			

NO.	DATE	BY	REVISION
1			
2			
3			
4			
5			

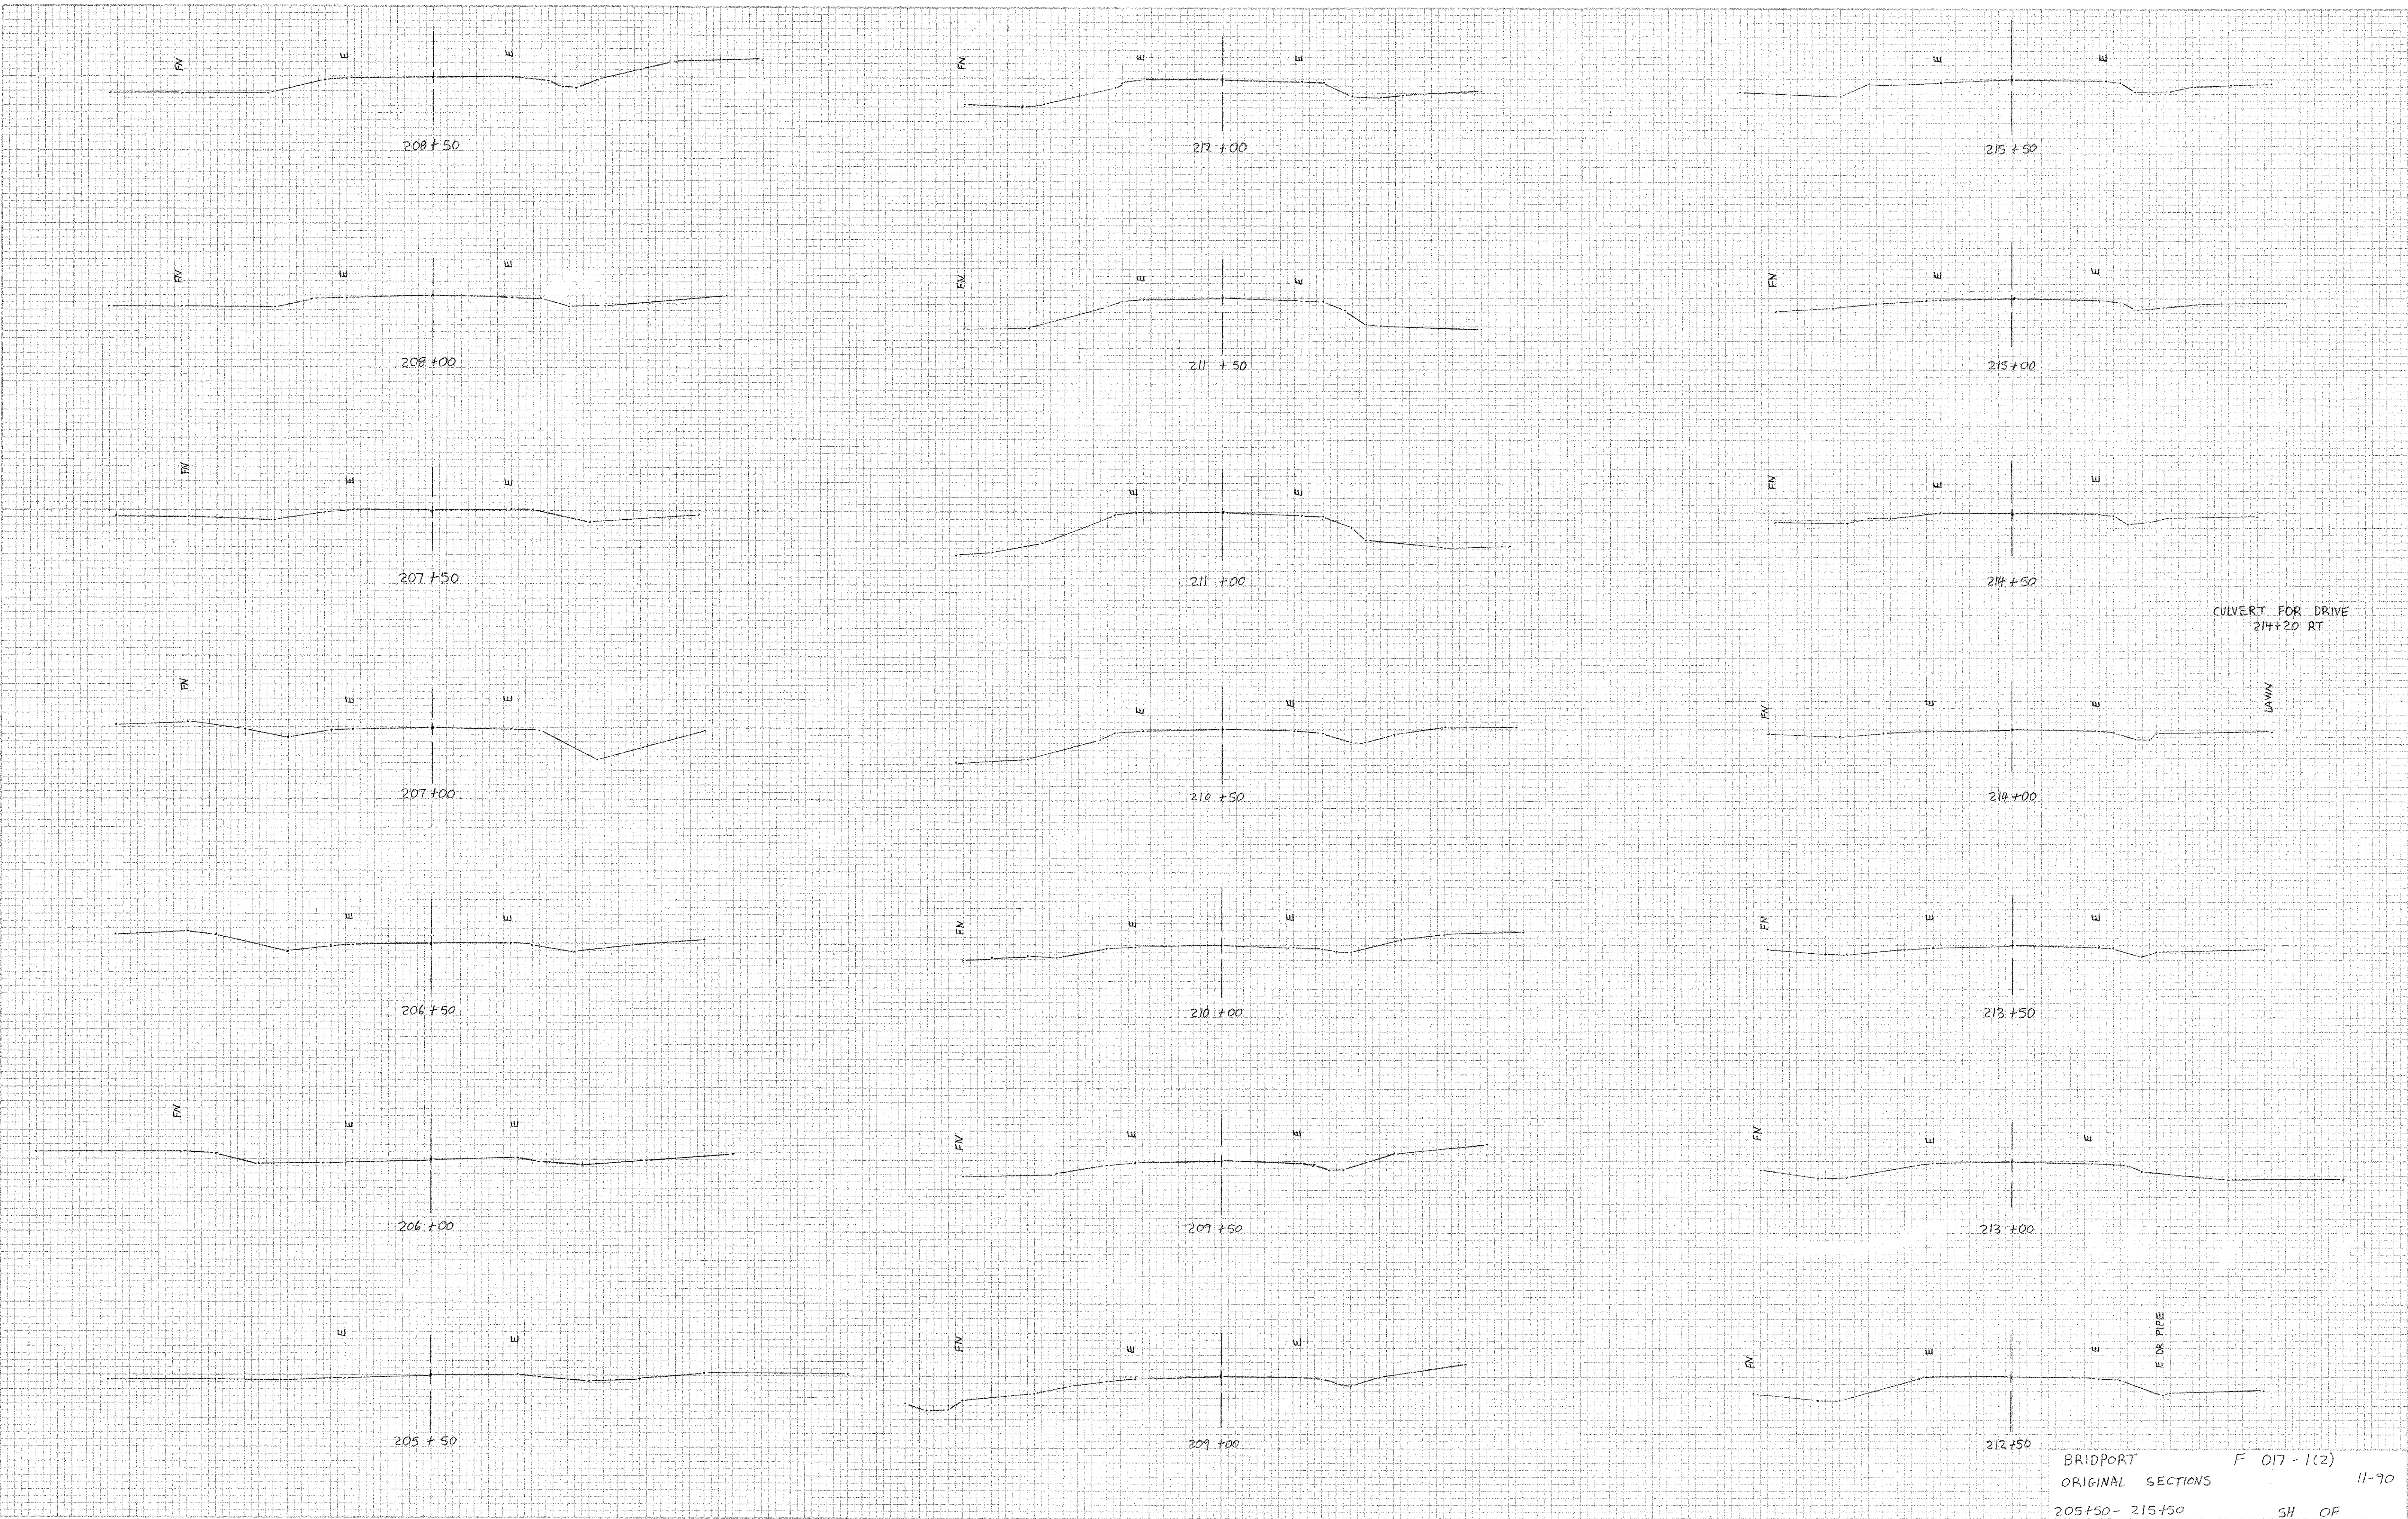

BRIDPORT F 017-1(2)
 ORIGINAL SECTIONS 11-90
 205+50- 215+50 5H OF