


# PROJECT DESCRIPTION AND LOCATION

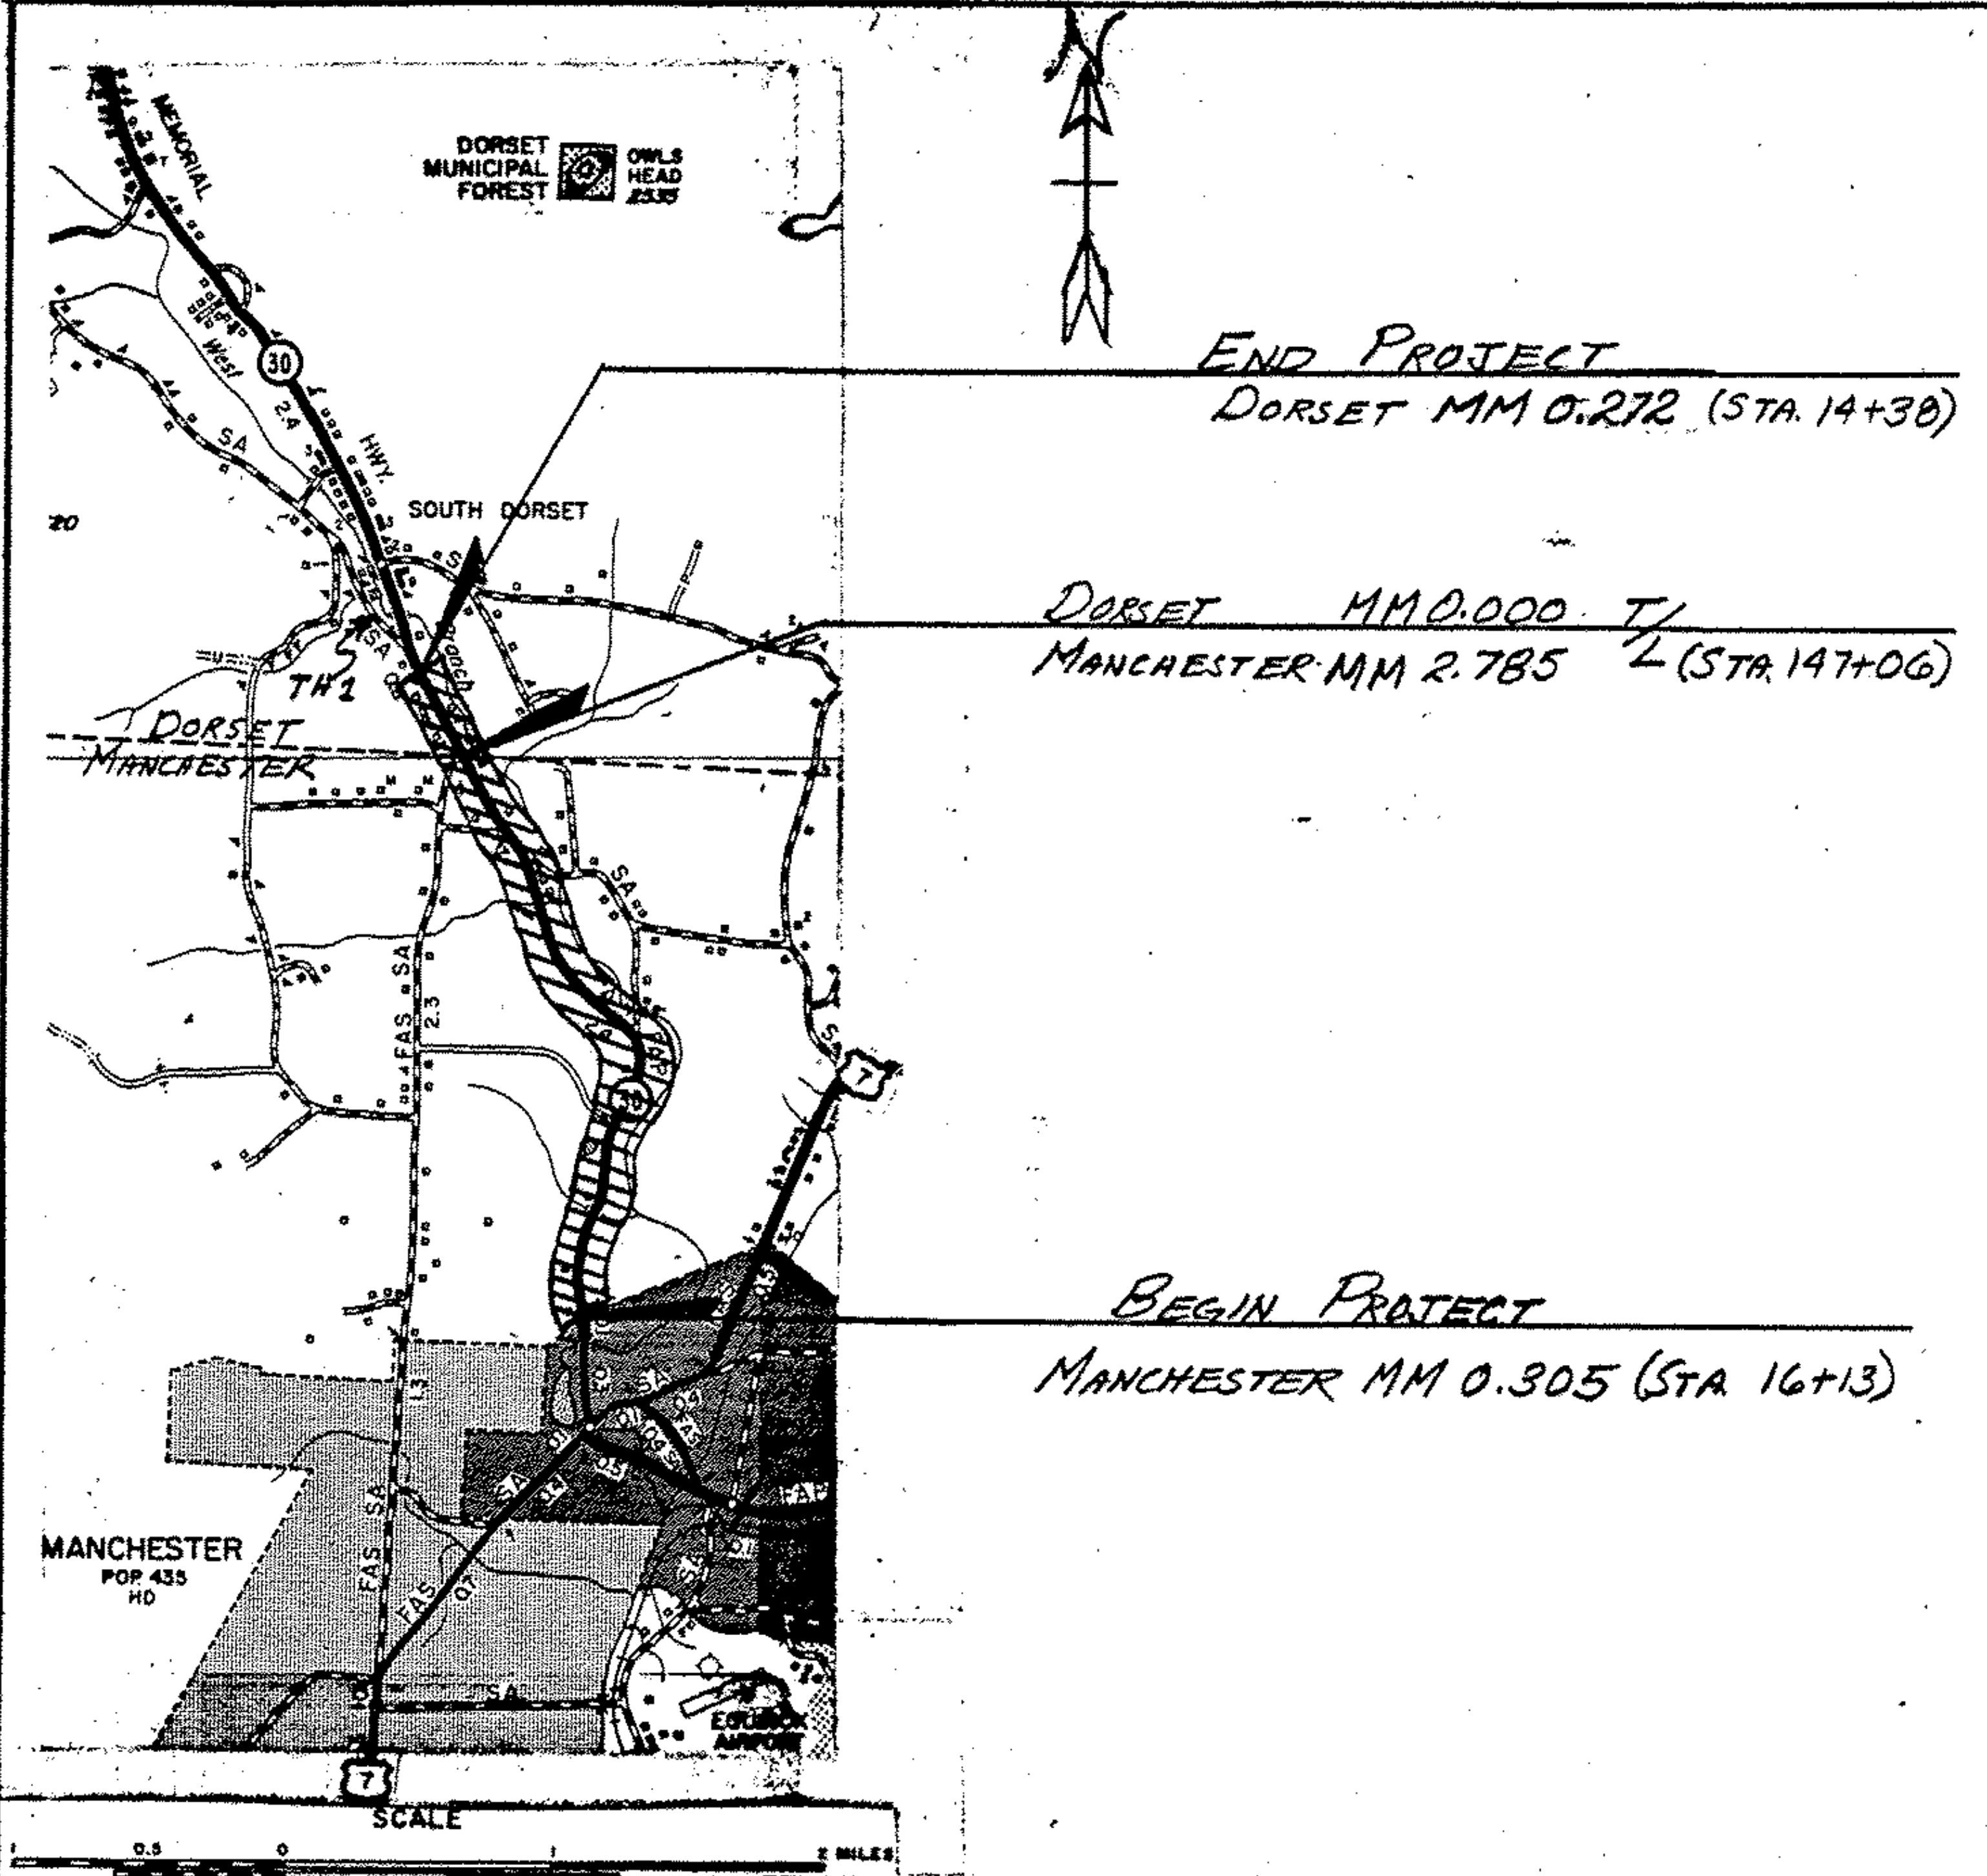

## PROJECT LOCATION

BEGINNING ON THE NORTH END OF BRIDGE #53 - THE MANCHESTER URBAN LIMITS - AT MM 0.305 ON VT. 30 IN MANCHESTER WHICH IS 1613' (0.305 MI) NORTHWEST OF THE INTERSECTION WITH US 7 AND PROCEEDING 2.752 MILES NORTHWEST TO MM 0.272 IN DORSET, 1212' (0.230 MI) SOUTHEAST OF TH 1  
 LENGTH OF PROJECT = 14,531' = 2.752 MI.

PROJECT MANCHESTER - DORSET

NO. F 015-2(2)S  
 SHEET 2 OF 11 SHEETS