



TYPICAL SECTIONS & DESIGN DATA

ITEM 406.25, BITUMINOUS CONCRETE PAVEMENT
 LEVELING COURSE, TYPE III OR IV (22' WIDE), EST. 250 TONS/MI.
 AS DIRECTED BY THE ENGINEER. *SEE NOTE #1
 1/4" WEARING COURSE ($\pm 1/4$) TYPE III (22' WIDE)

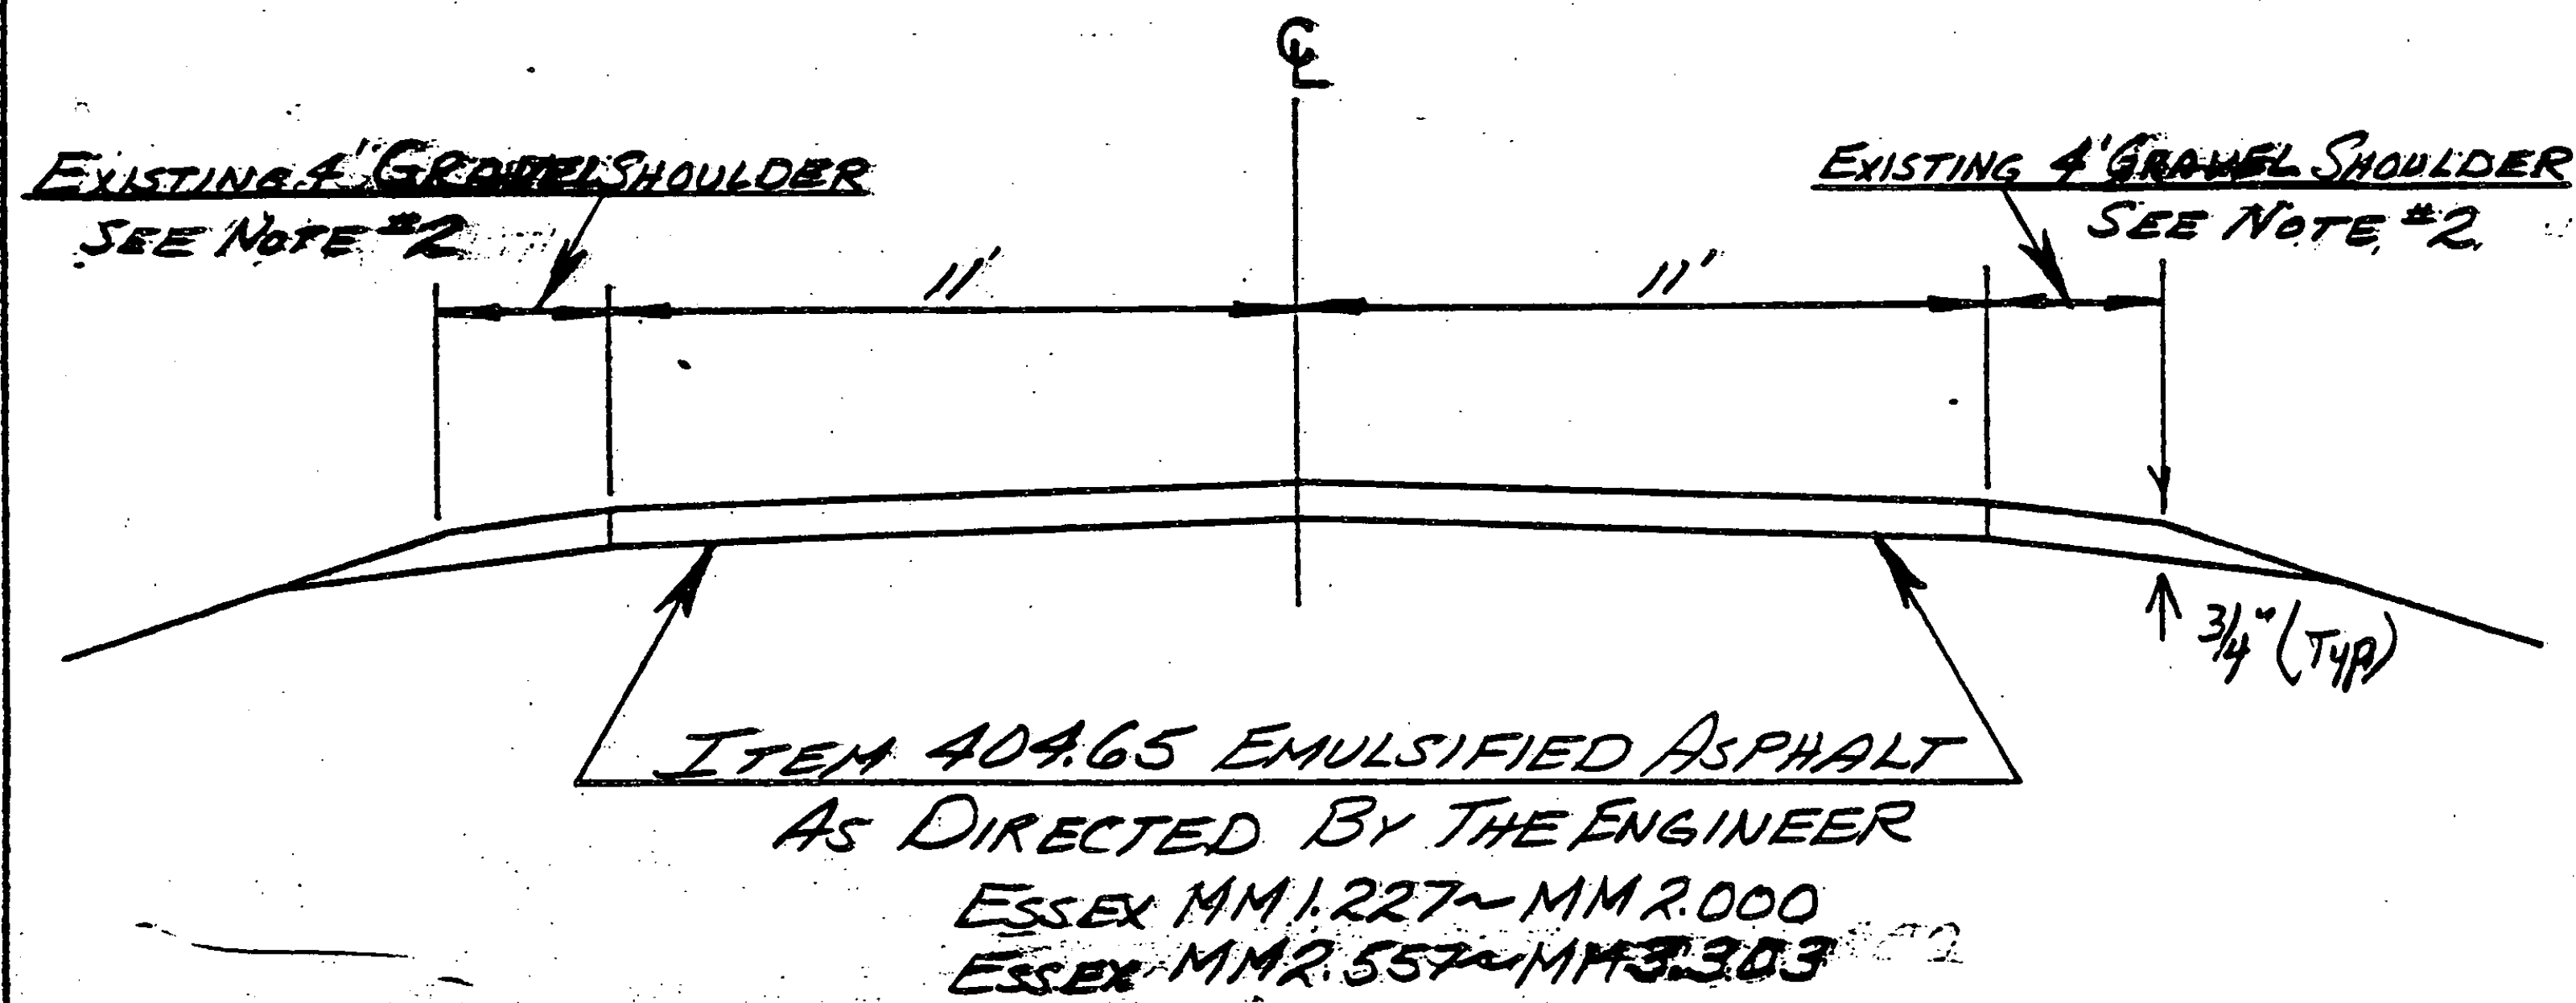

ITEM 406.25, BITUMINOUS CONCRETE PAVEMENT
 LEVELING COURSE, TYPE III OR IV (23' WIDE), EST. 250 TONS/MI.
 AS DIRECTED BY THE ENGINEER. *SEE NOTE #1
 1/4" WEARING COURSE ($\pm 1/4$) TYPE III (23' WIDE)

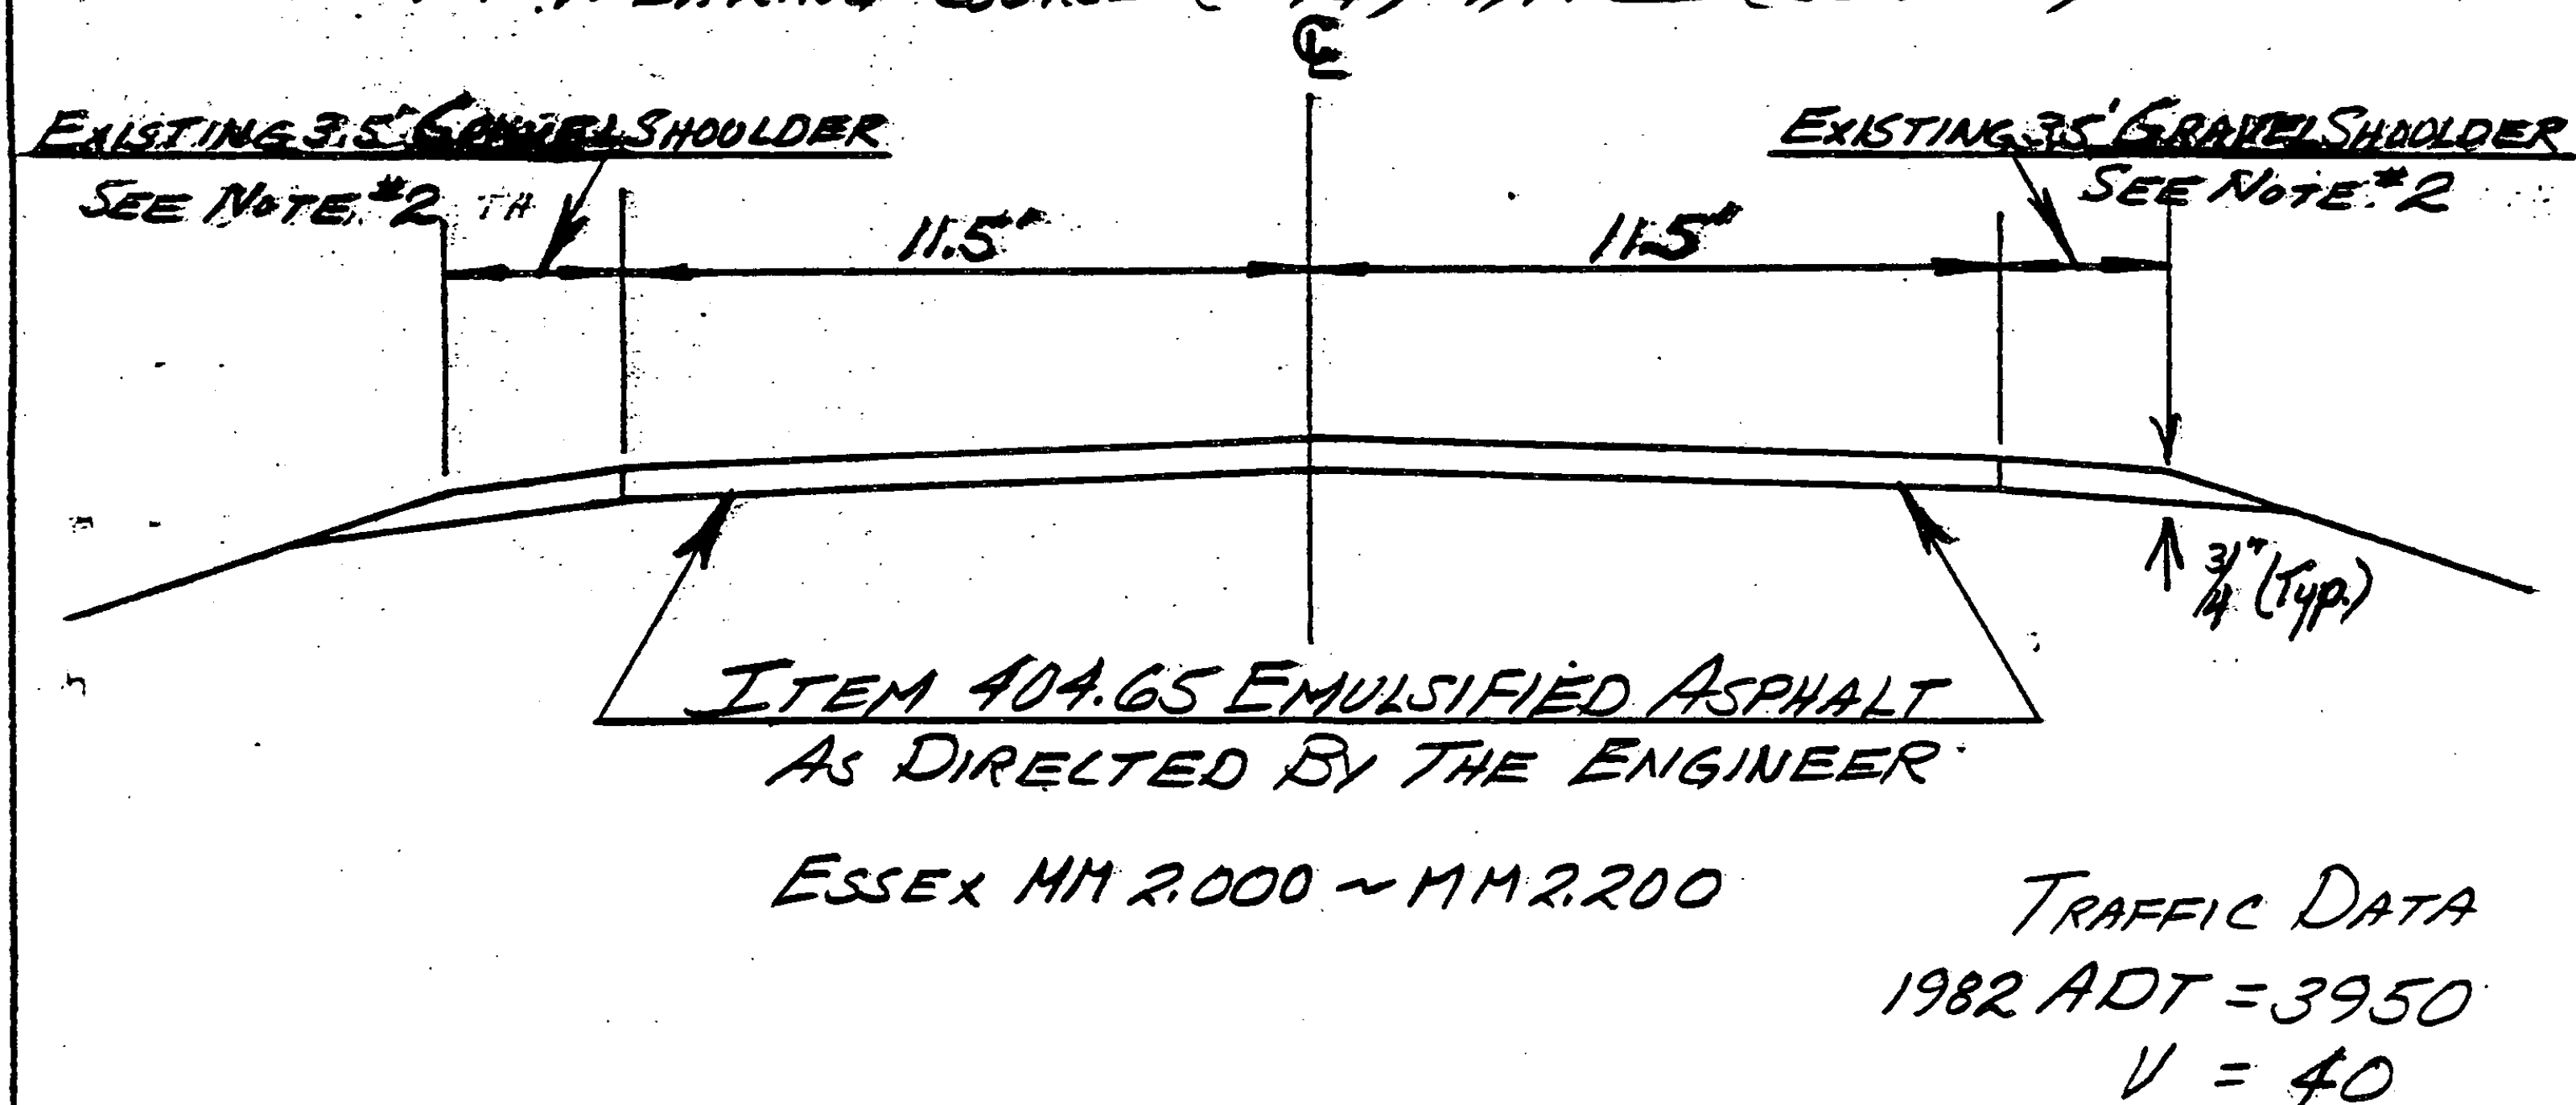

NOTE #1: LEVEL COURSE BASED ON 22' WIDE ROADWAY, QUANTITY FACTORED FOR ACTUAL WIDTH.

NOTE #2: SHOULDERS TO BE PAVED - REFER TO SHEET 60160 FOR DETAILS.

PROJECT ESSEX

NO. M 5400(3) S
 SHEET 4 OF 60