



TYPICAL SECTIONS & DESIGN DATA

ITEM 406.25, BITUMINOUS CONCRETE PAVEMENT
 LEVELING COURSE, TYPE III OR II (22' WIDE), EST. 150 TONS/MI.
 AS DIRECTED BY THE ENGINEER *SEE NOTE #1
 1/4" WEARING COURSE ($\pm 1/4"$) TYPE III (23' WIDE)

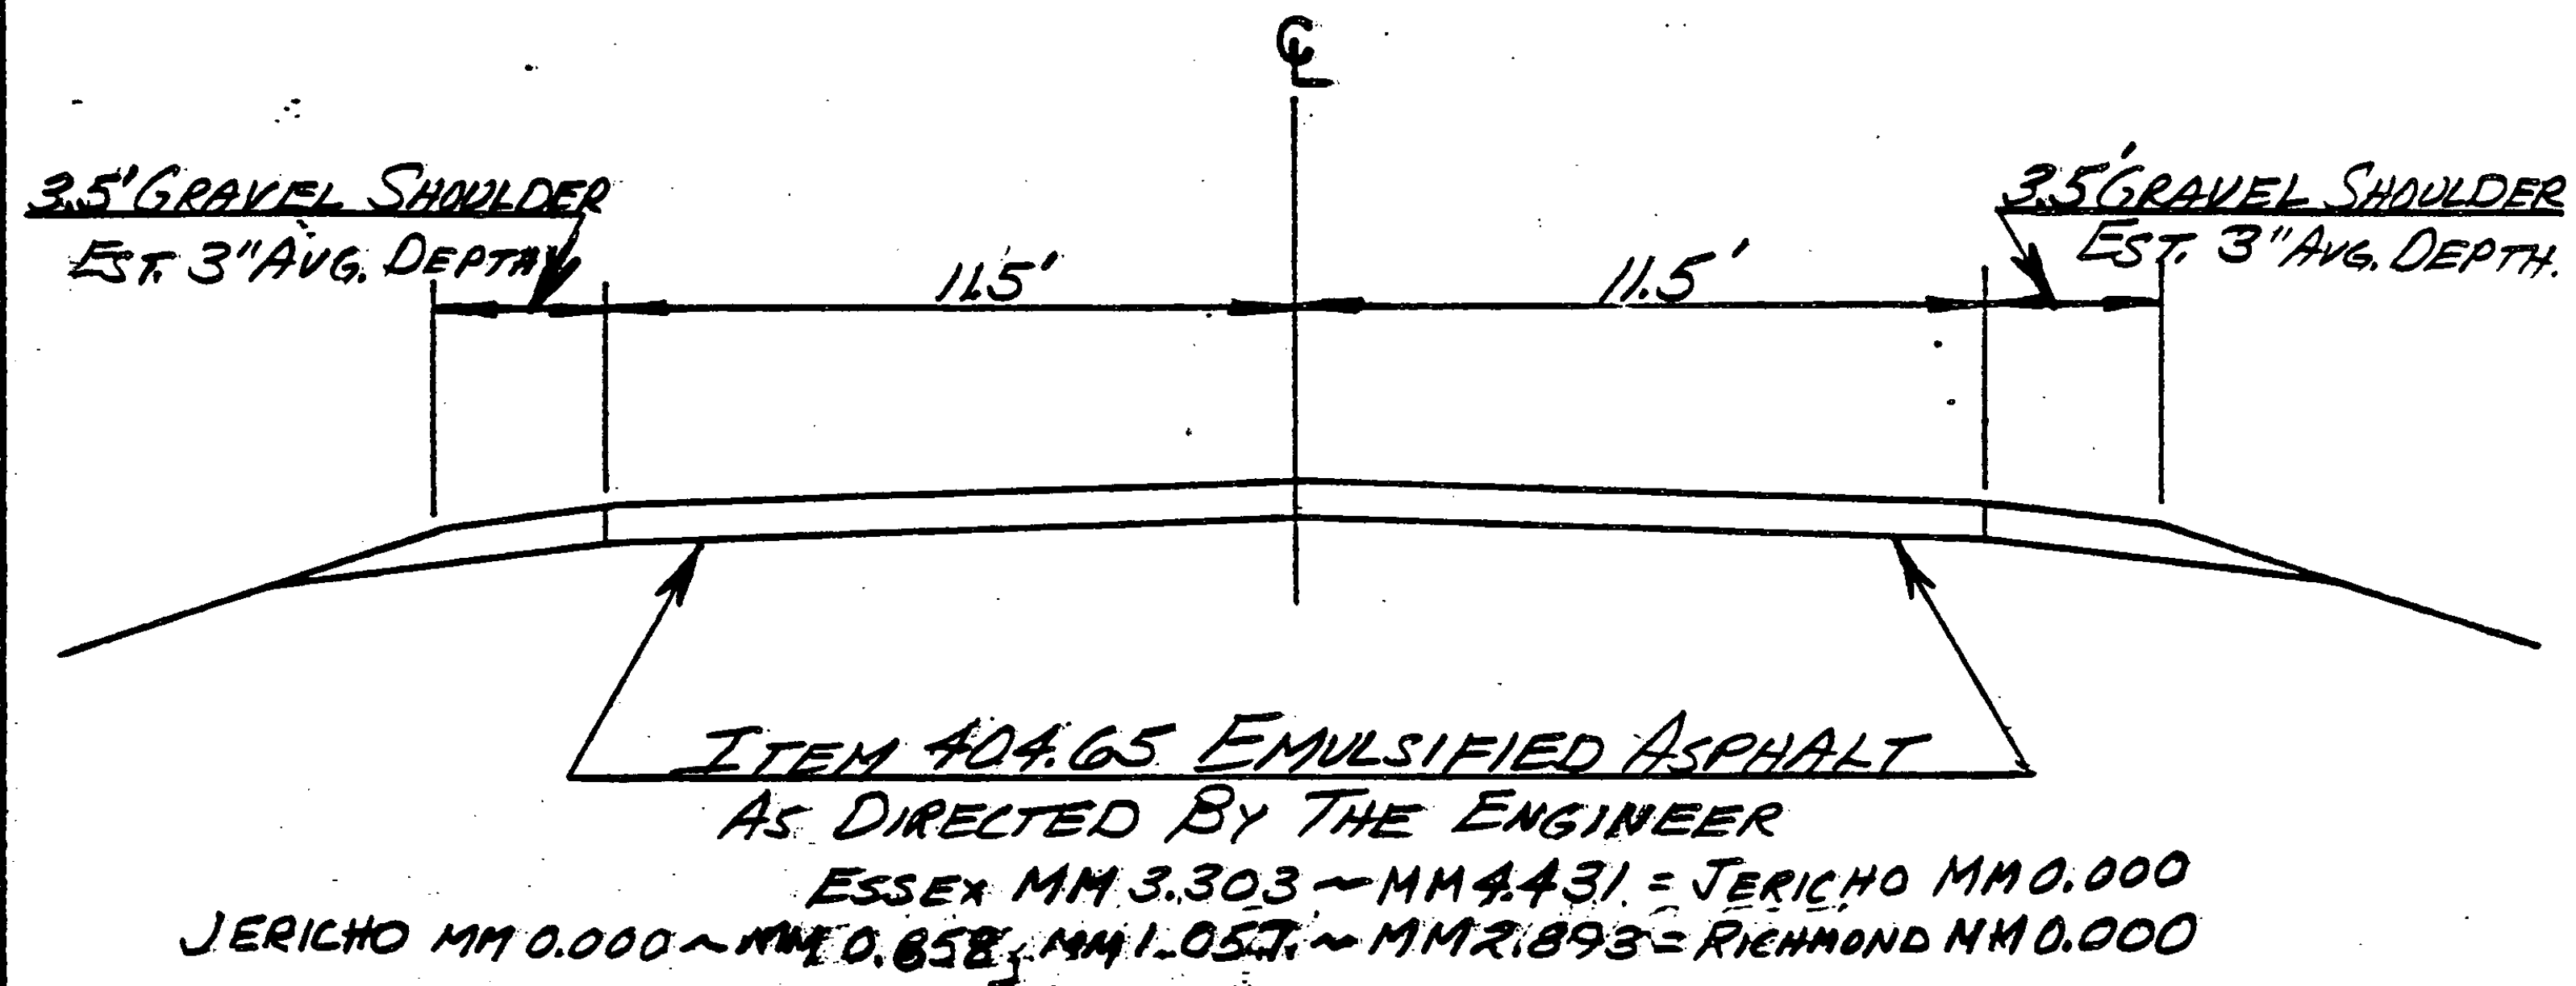

ITEM 406.25, BITUMINOUS CONCRETE PAVEMENT
 LEVELING COURSE, TYPE III OR II (23' WIDE), EST. 250 TONS/MI.
 AS DIRECTED BY THE ENGINEER *SEE NOTE #1
 1/4" WEARING COURSE ($\pm 1/4"$) TYPE III (23' WIDE)

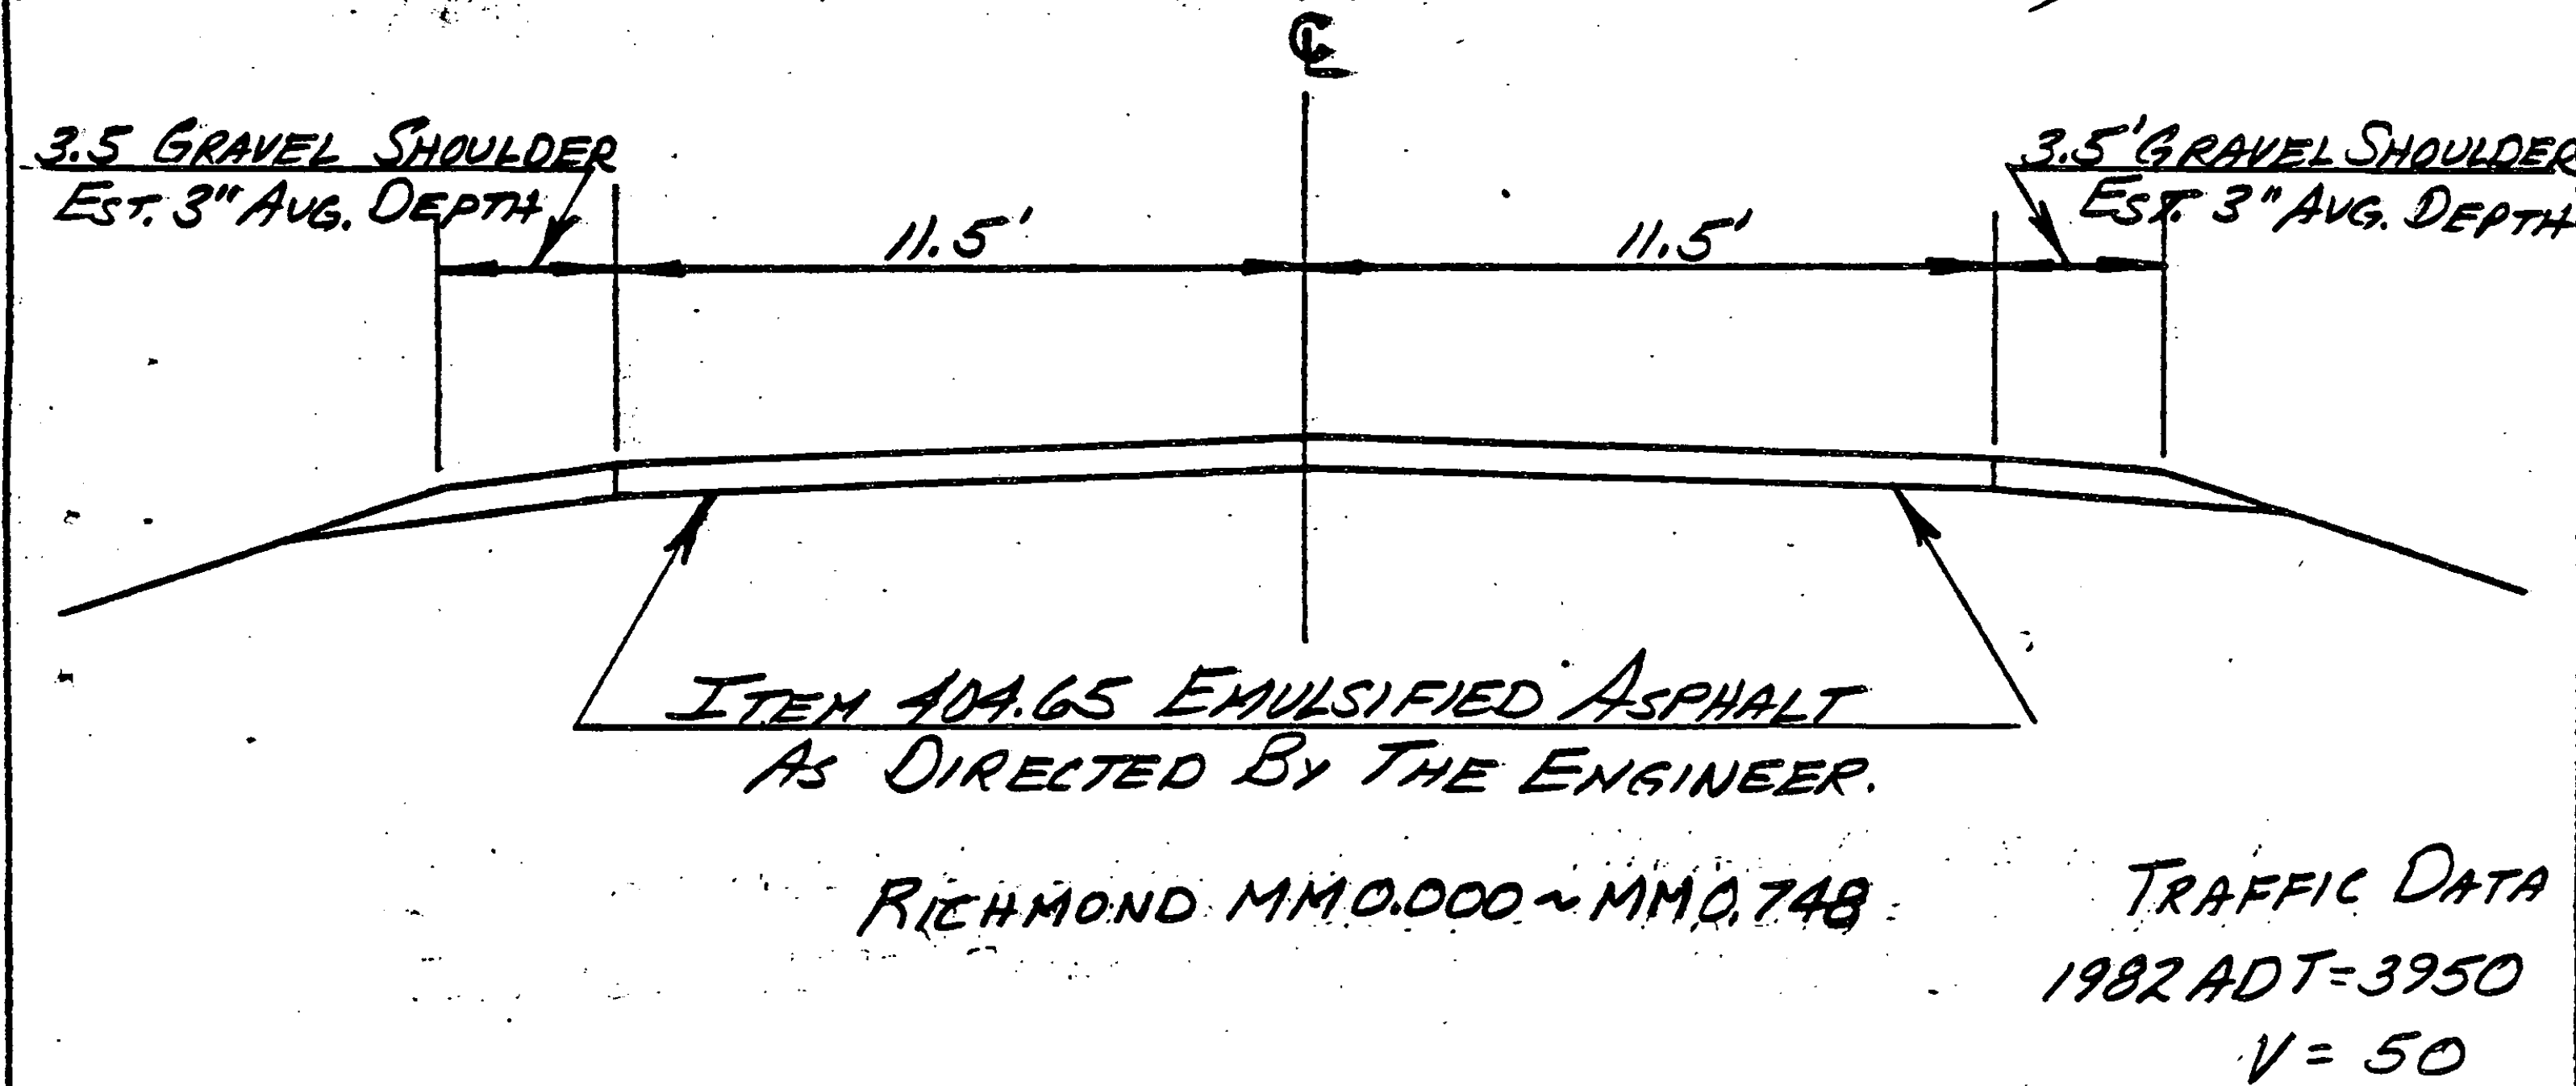

NOTE #1: LEVEL COURSE BASED ON 22' WIDE ROADWAY, QUANTITY FACTORED FOR ACTUAL WIDTH.