


TYPICAL SECTIONS & DESIGN DATA

ITEM 406.25, BITUMINOUS CONCRETE PAVEMENT
 3" DEPTH - TO BE LAID IN TWO COURSES - 23' WIDE

1 - 1 3/4" COURSE (1/4) TYPE II

1 - 1 1/4" WEARING COURSE (1/4) TYPE III

NOTE: ESTIMATE FOR THIS SECTION DOES NOT
 INCLUDE 1 1/4" WEARING COURSE OR GRAVEL SHOULDERS
 THESE ARE TO BE CONTINUOUS WITH ADJACENT
 AREAS. SEE SHEET 20 OF 60.

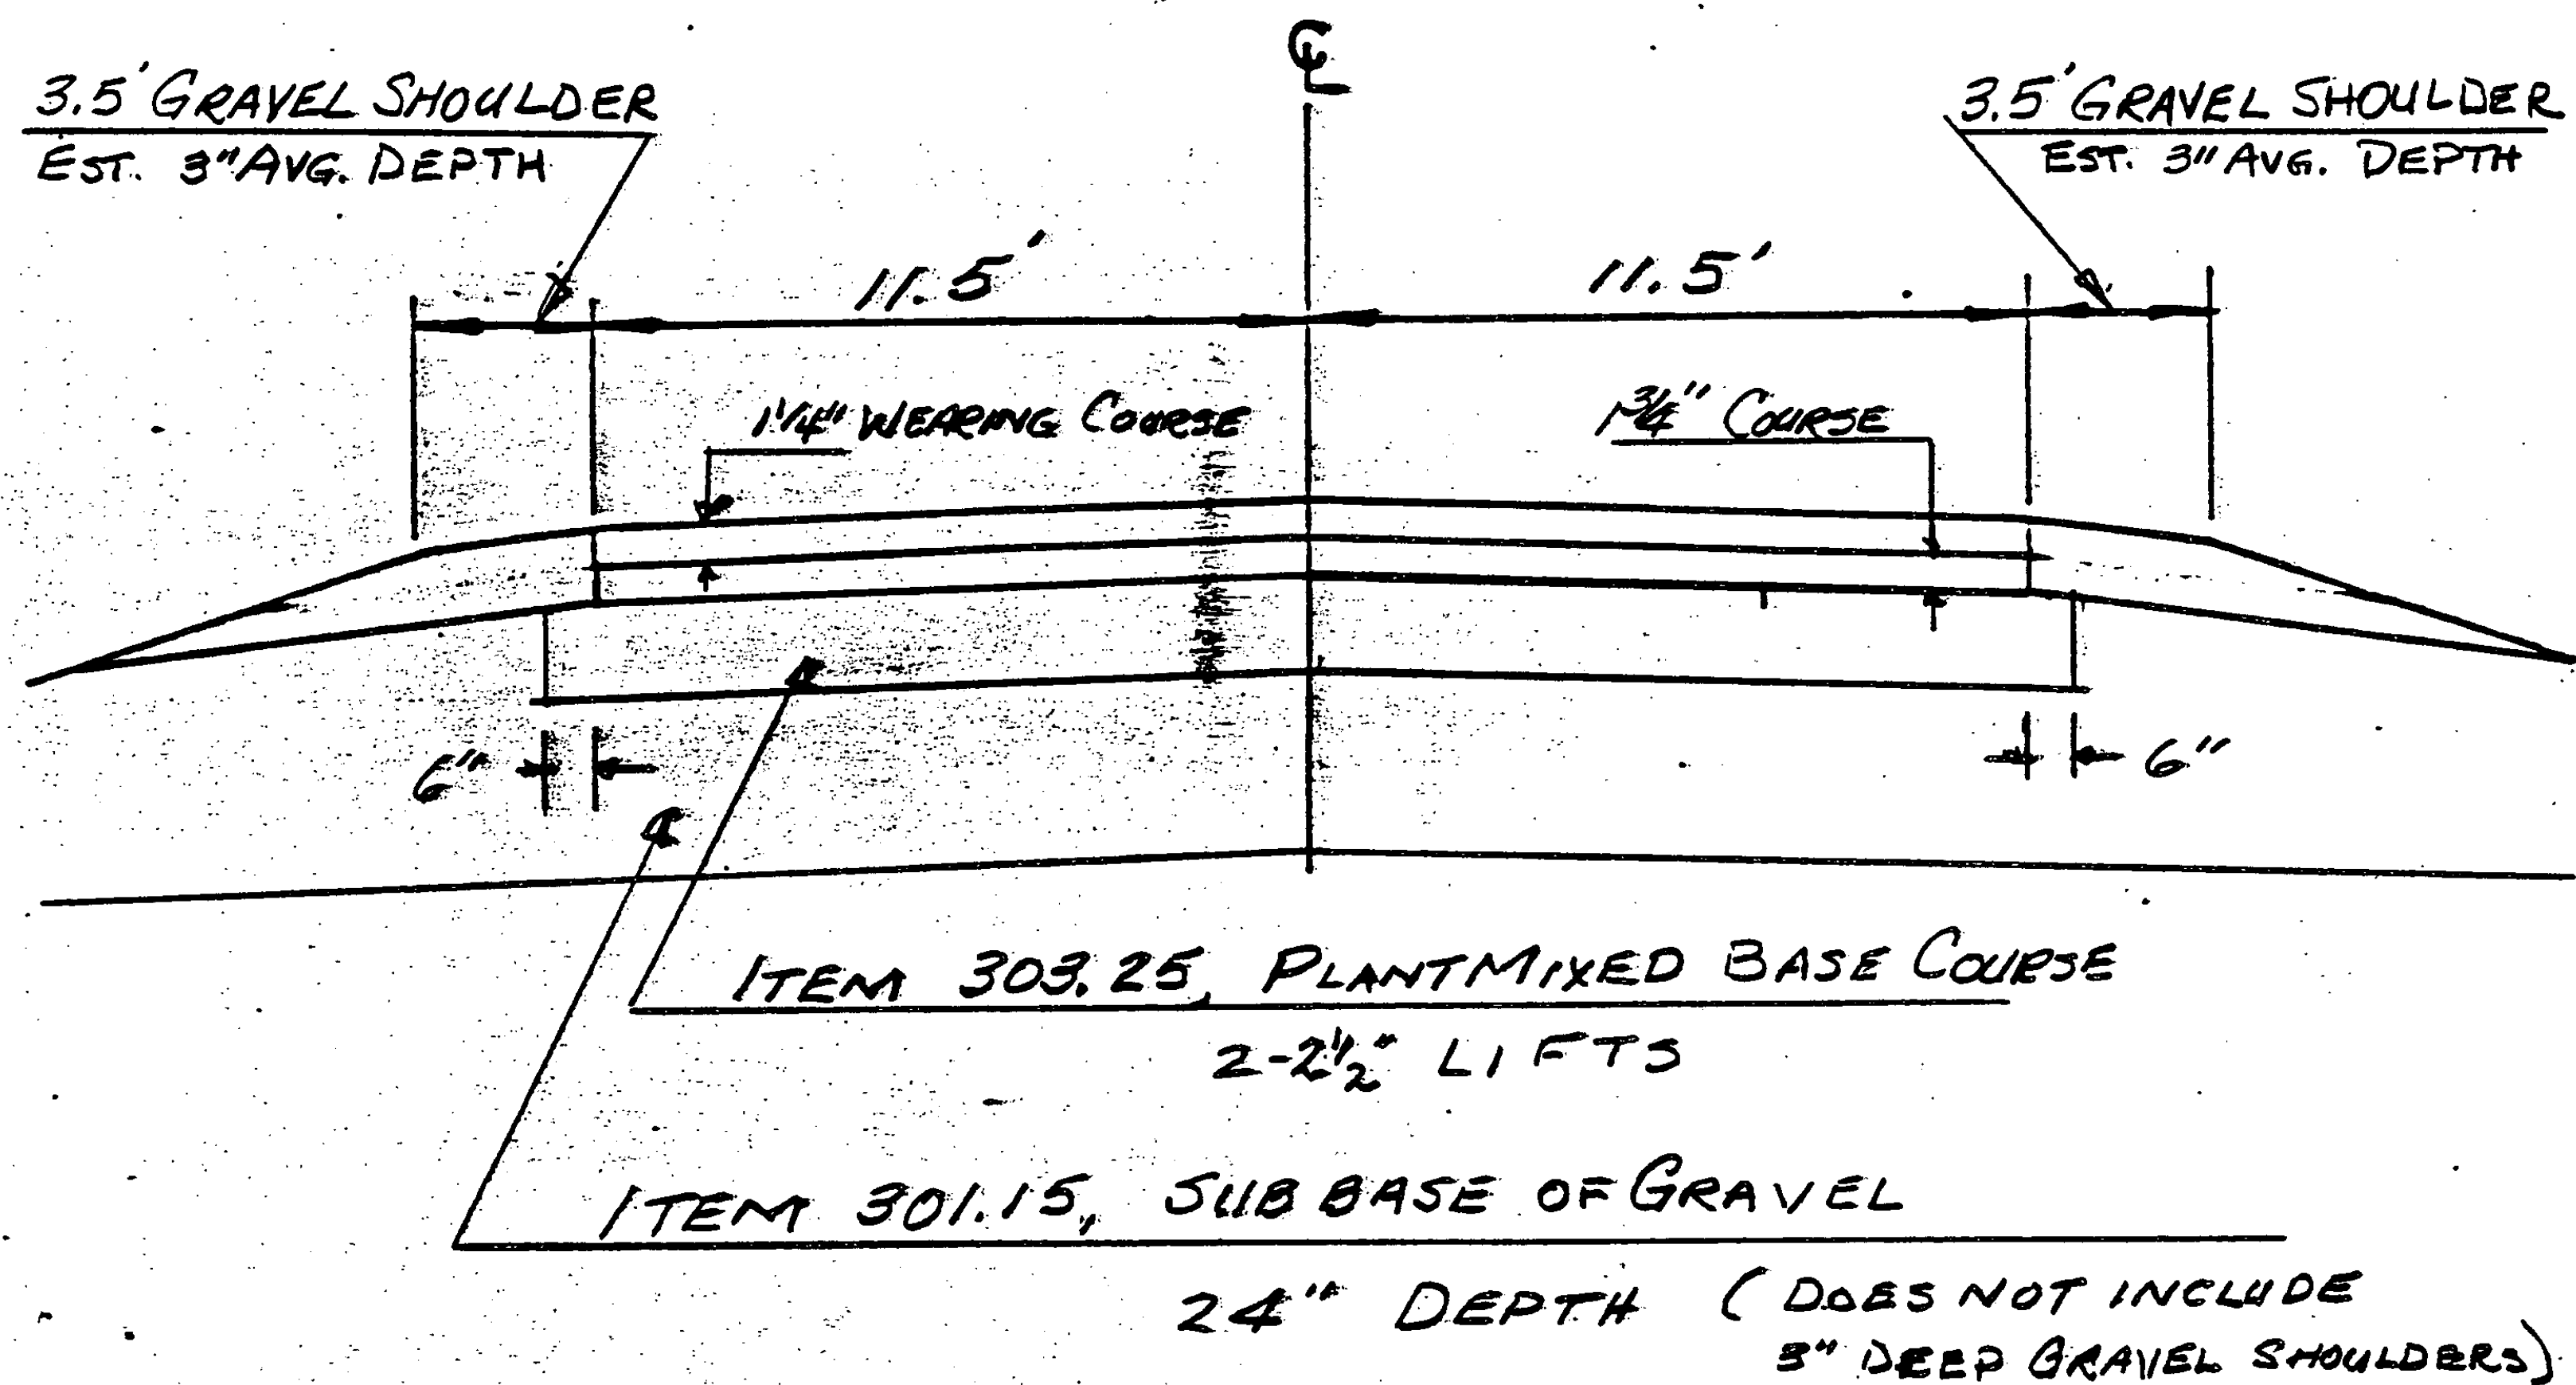

JERICO MM 0.850 ~ MM 1.057

TRAFFIC DATA

1982 ADT 3340

V 50