


EDGE LINE 4' FROM GUARDRAIL

8" DURABLE WHITE LINE 15' TYPICAL BOTH LOCATIONS

ISLAND FORMED WITH DOUBLE YELLOW

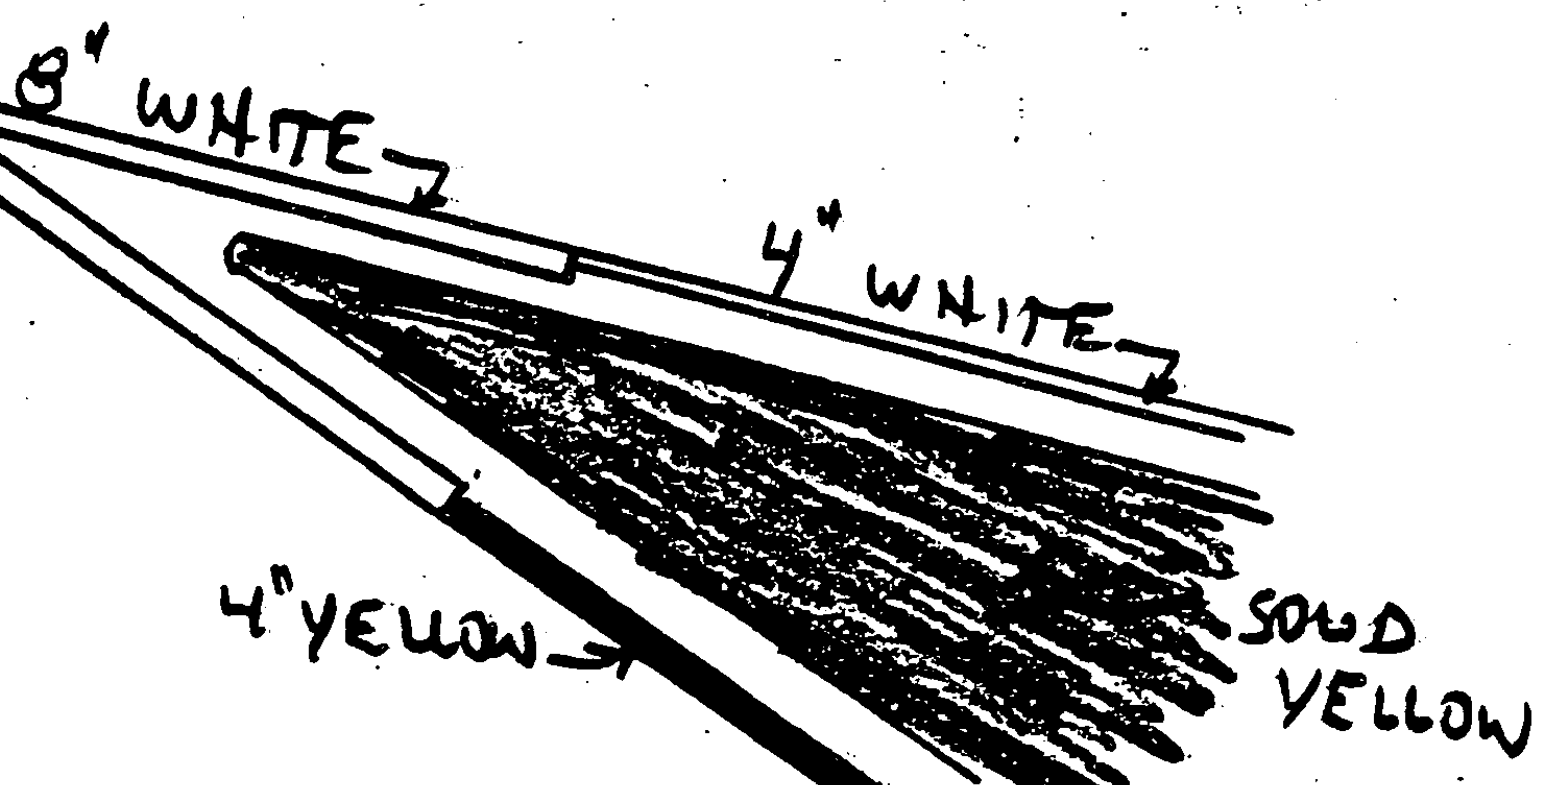

ISLAND DETAIL (ALL DURABLE MARKINGS)

ALL DIMENSIONS APPROX. TRAFFIC CONTROL REQUIRED FOR LAYOUT SUBS. TO OTHER ITEMS.

INTERSECTION LAYOUT
US RT 2 & VT 117

END DURABLE 4" YELLOW
VT 117 TO ESSEX JCT