

* NOTE: All Elevation and dimensions shown on Sheet Key Sections may be revised at the discretion of the Engineer.

15+50L ~ 17+50L
 All Stone Fill to be excavated and disposed of prior to excavating for Rock Borrow Sheet Key.
 Excavation to be paid as Common Excavation, Item 203.15

MH
 170
 170
 0409
 0100

Rock Borrow Item 203.33

STRUCTURE EXCAV. LIMITS OF ITEM 204.25

12.0 5.0 Si & St MTW to 1g St

CMPF

14.58

15.18 24' 50"

15+50

15+25 RI
 Begin Gravel Backfill for Slope Stabilization, Item 203.35

15+25 RI 17+49 RI

15+25 RI 22' Li. Coe drain, Item 605.101

15+25 RI Underdrain Flushing Basin, Item 605.95

15+25 RI 17' Fabric Material, Type III, Item 649.12

200 CI MTW

800 CI (Sat)

35.5 Coarse Gravel (Sat) CMPF

15+50 RI 20'

1950

C-105 71/96


C-538

From B / F = 638

C-1155 39

5B 74

DETAIL FOR Item 649.12 with Underdrain

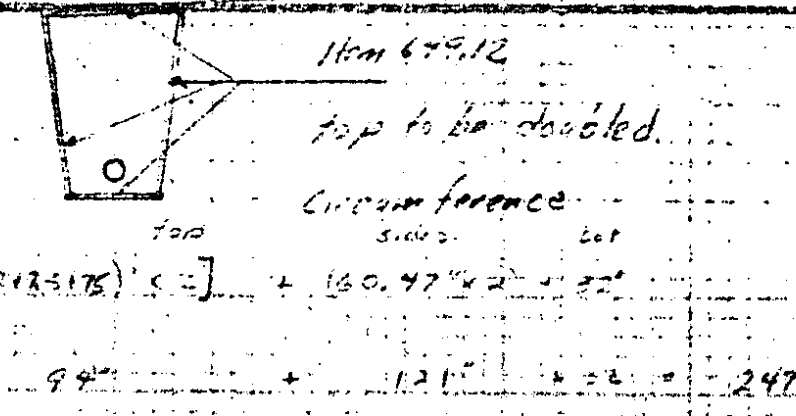

Struct Exc 201 Item 17+49 zero 15+42
 RB 405 Item 15+50
 Filter B 17

15+50 Lt
 Begin Filter Fabric Material Type II, Item 649.12

Rock Borrow Item 203.33

LIMITS OF STRUCTURE EXCAV. Item 204.25

15+00

Struct Exc 38
 RB 106

14+75 Lt
 Begin Rock Borrow, Item 203.33
 Begin Structure Excavation, Item 204.25

FROM STA. 15+00	TO STA. 15+50
PROJECT NAME	JERICO RIVER
NO.	RS0224(3)
SURVEYED BY	BEARD
SHEET 52 OF 60 SHEETS	PLOTTED 01/17/84
	JAN 1984

SCALE 10 FEET