



\* Note: All Elevations and Dimensions Shown on Shear Key Sections may be revised at the discretion of the Engineer.

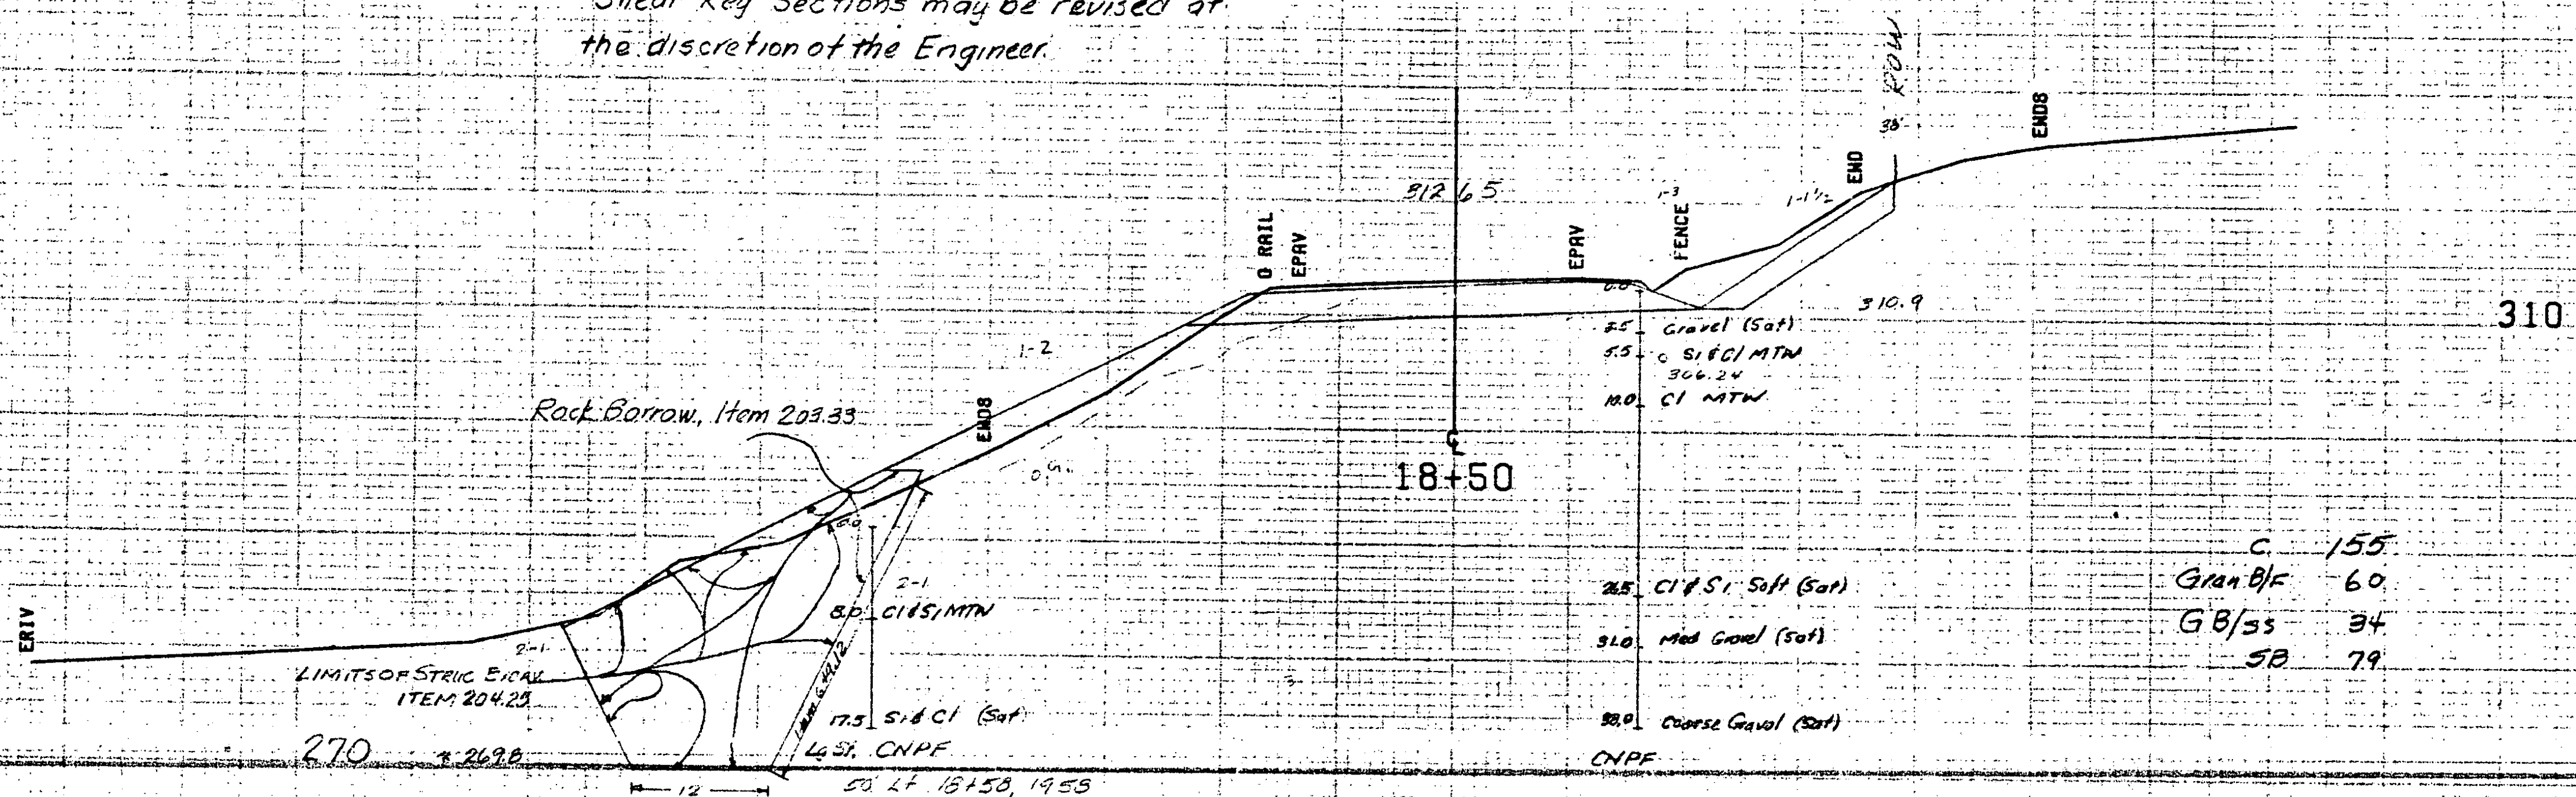

C	155
Gran Bk	60
GB/SS	34
SB	79

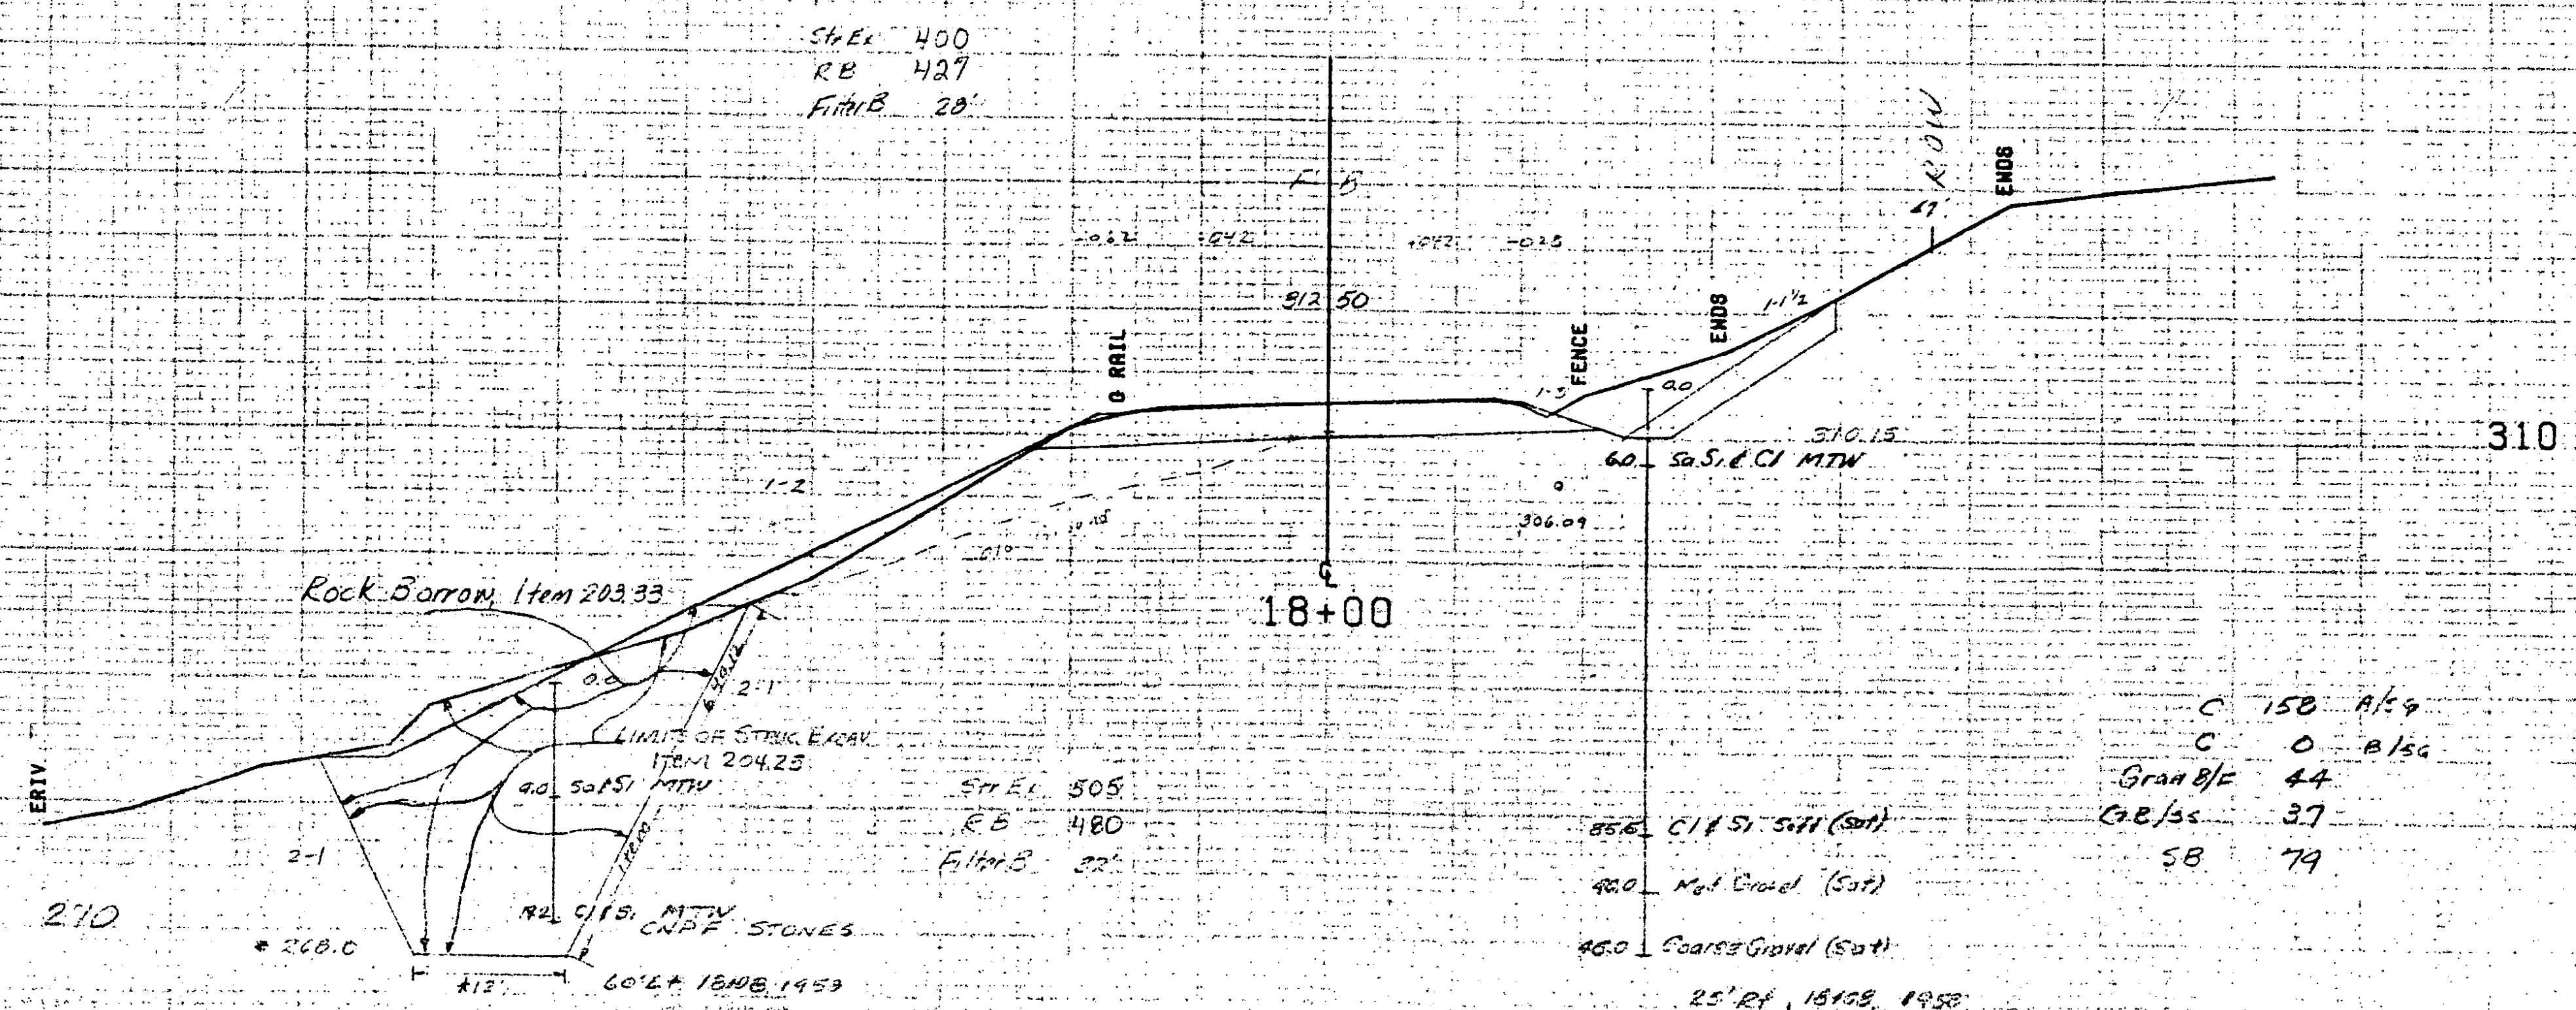

C	150	A/59
C	0	B/50
Gran Bk	44	
GB/SS	37	
SB	79	

FROM STA. 18+00 TO STA. 18+50  
 PROJECT NAME JERICHO RIVER  
 NO. RS0224(3) PLOTTED 01/17/84  
 SURVEYED BY BEARD  
 SHEET 51 OF 60 SHEETS JAN 1984

SCALE 10 FEET