



TYPICAL SECTIONS & DESIGN DATA

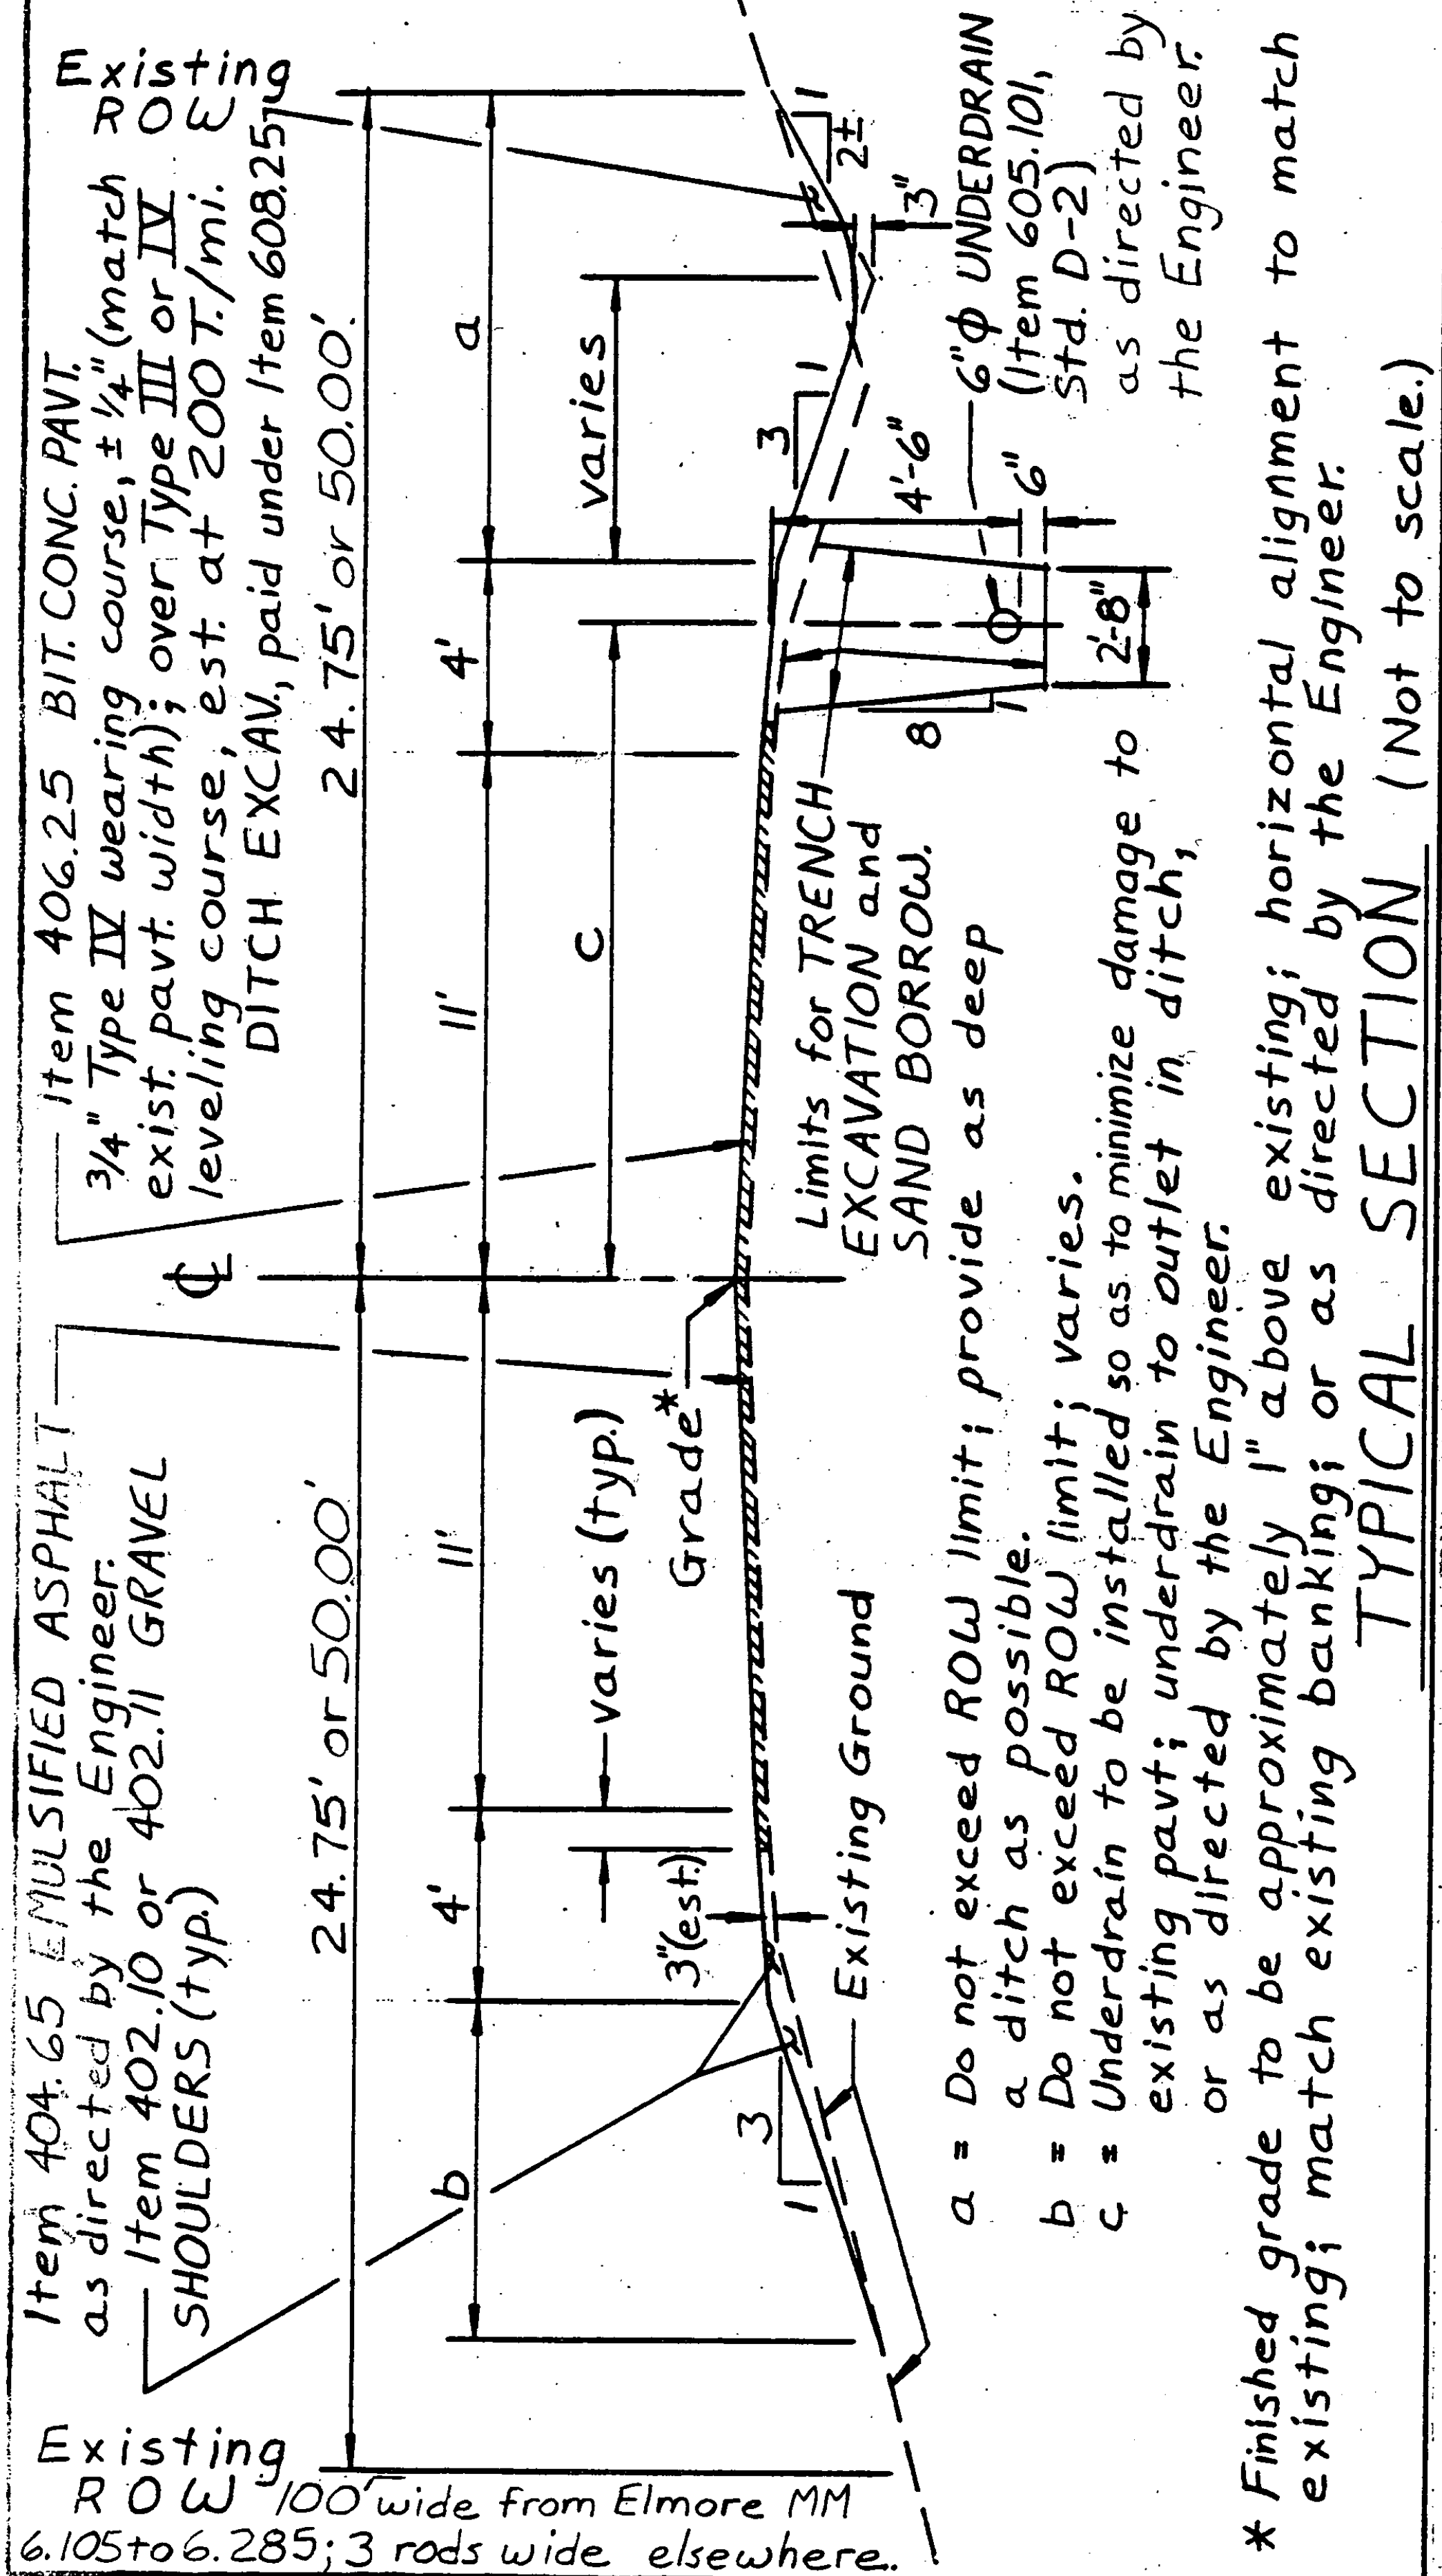

a = Do not exceed ROW limit; provide as deep a ditch as possible.
b = Do not exceed ROW limit; varies.
c = Underdrain to be installed so as to minimize damage to existing pavt; underdrain to outlet in ditch, or as directed by the Engineer.

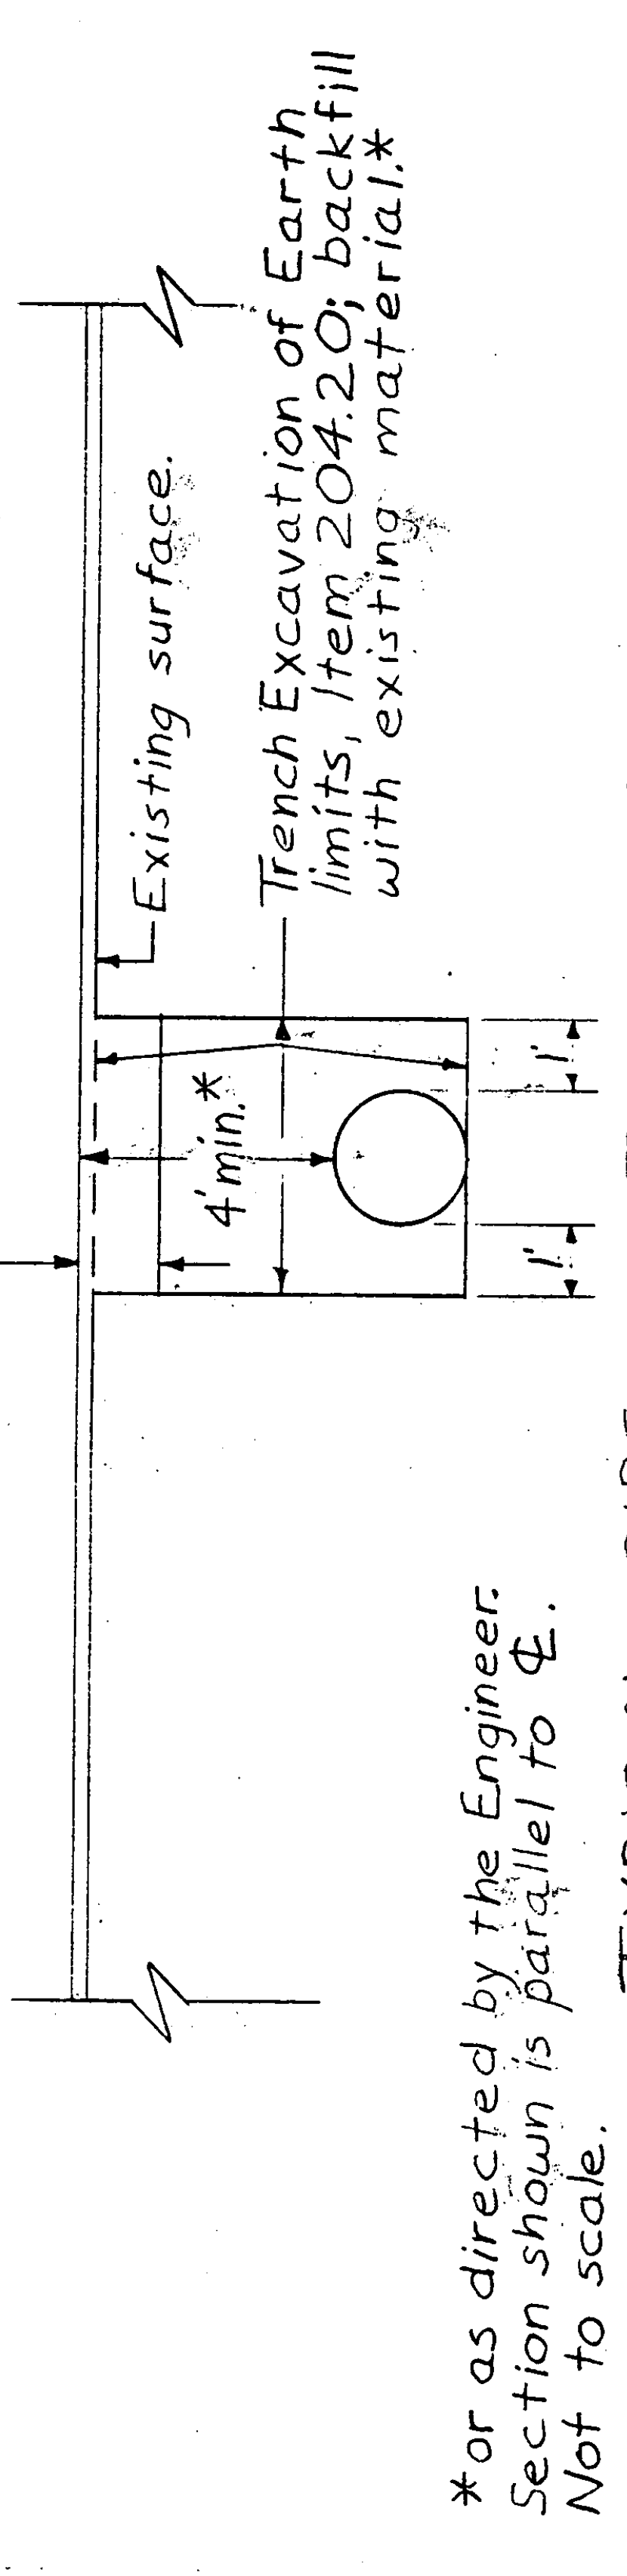

NO. RS 024 - 1 (15)
SHEET 3 OF 13 SHEETS