


**DETOUR TYPICAL**


STA. 300+00 TO  
STA. 304+26

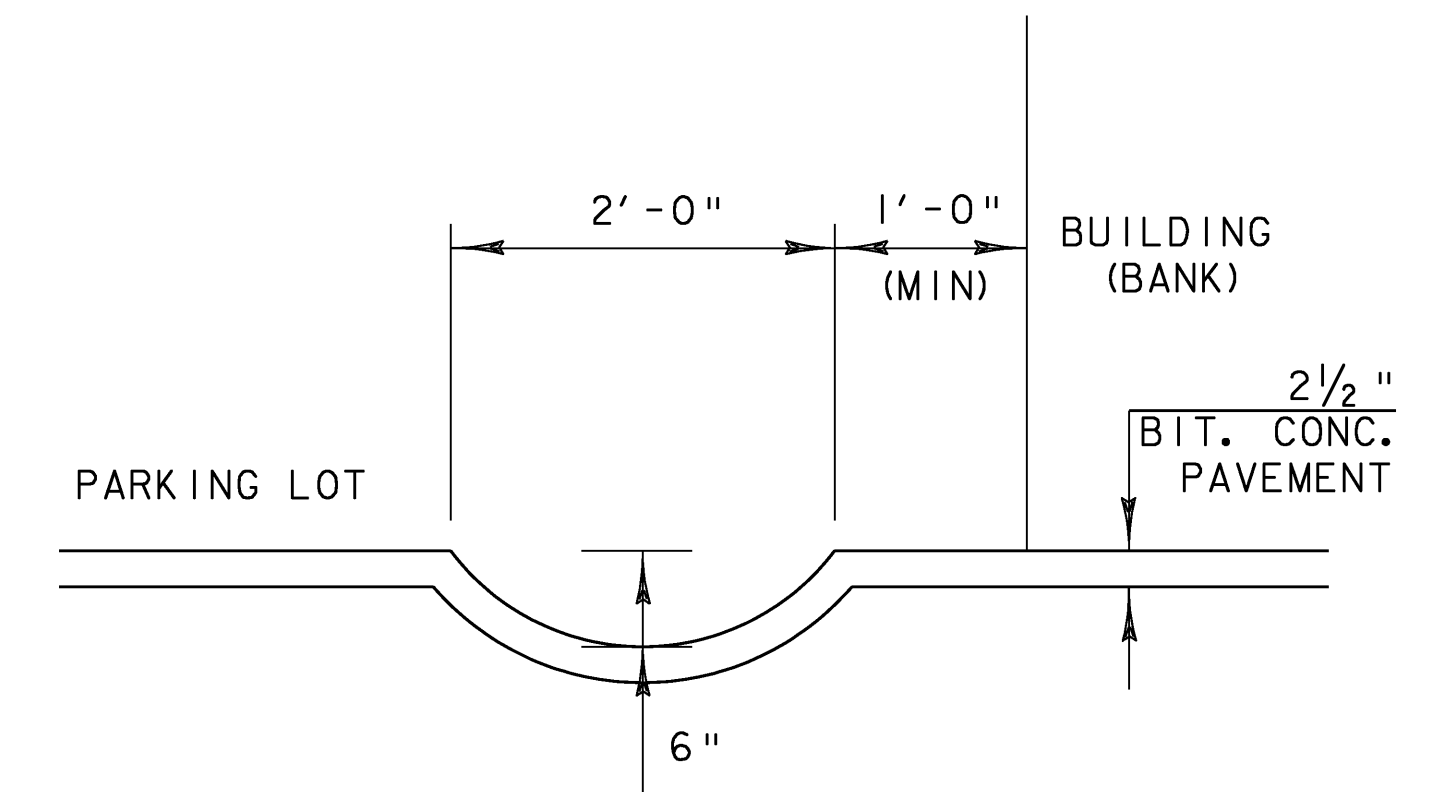

**PAVED DRAINAGE DITCH**

STA. 305+23 LT 19.5' TO  
STA. 305+23 LT 38.5'


SCALE 1" = 1'-0"  
1 9 6 3 0 1 2

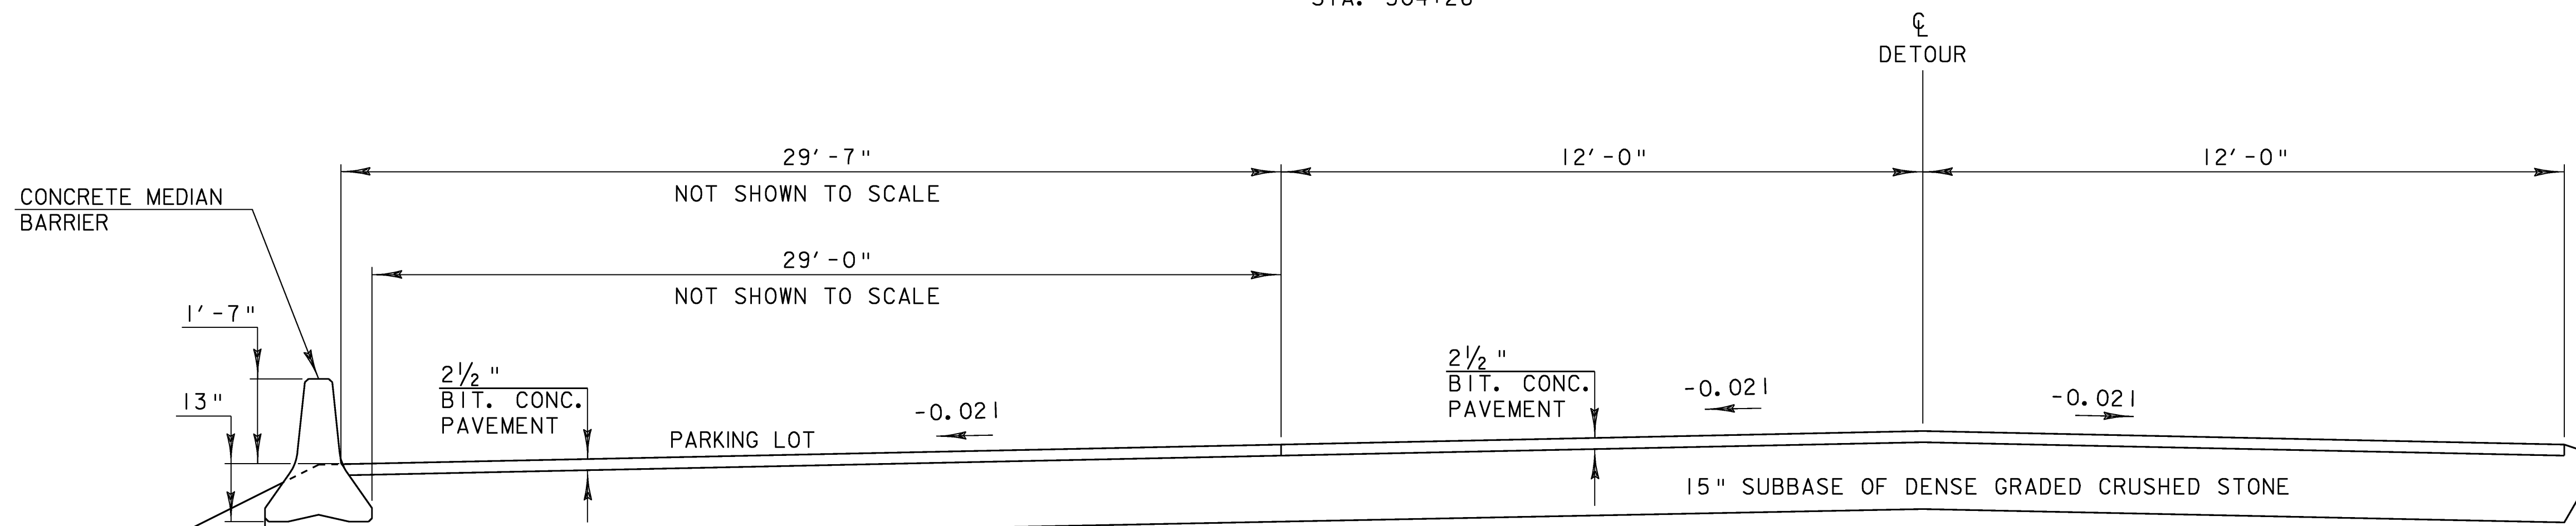

**DETOUR TYPICAL**

STA. 304+26 TO  
STA. 305+25

SCALE 1/2" = 1'-0"  
1 0 1 2

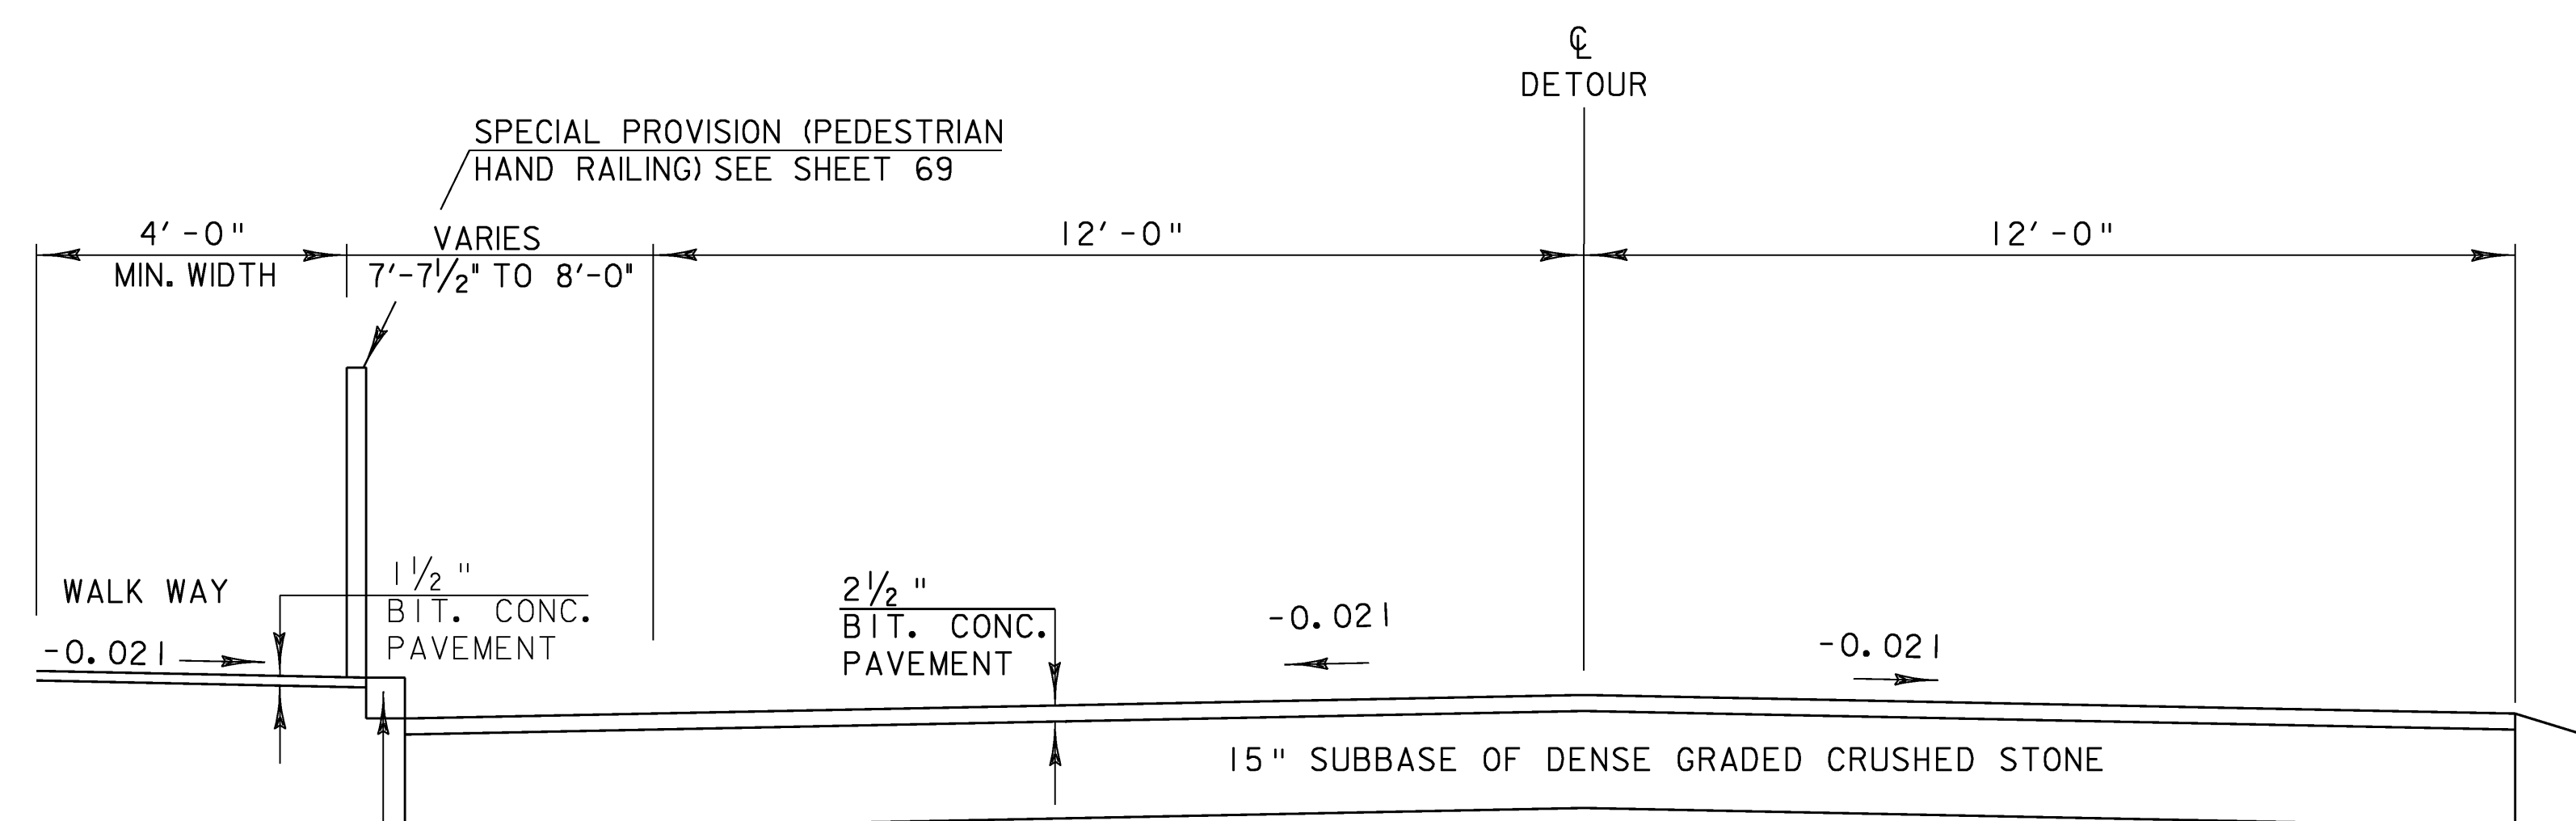

**DETOUR TYPICAL**

STA. 305+25 TO  
STA. 305+67

SCALE 1/2" = 1'-0"  
1 0 1 2

**DETOUR TYPICAL SECTIONS**

PROJECT NAME: WILLIAMSTOWN  
PROJECT NUMBER: BRS 0204(4)

FILE NAME: /structures/selltyp PLOT DATE: 07-APR-2008  
PROJECT LEADER: M. EVANS-MONGEON DRAWN BY: L. DUQUETTE  
DESIGNED BY: U. STANLEY CHECKED BY: EVANS-MONGEON  
selldettyp.i SHEET 5 OF 108