

RIGHT - OF - WAY DETAIL SHEET


TABLE OF PROPERTY ACQUISITION

PARCEL NO.	PROPERTY OWNER	SHEET NO.	BEGINNING STATION	ENDING STATION	TAKE	REMAINDER	RIGHT			RECORDING DATA				REMARKS	
					AREA±	AREA±	TYPE	(T)(P)	AREA±	TITLE	DATE	TOWN / CITY	BOOK		PAGE
1	BEATTIE, CONRAD A. & DONAH H.	18,19	217+59.00 LT.	217+76.42 LT.			DRIVE	(T)		WD	01/04/08	WILLIAMSTOWN	136	273-275	13' GRAVEL MM 0410
			217+55.46 LT.	217+76.42 LT.			SLOPE	(T)	54.0 SF						
			217+61.94 LT.	217+88.20 LT.			INSTALL	(T)							EROSION CONTROL
			217+76.46 LT.	218+36.75 LT.			CHANNEL	(P)	360.0 SF						
			217+93.97 LT.	218+53.85 LT.			INSTALL	(T)							COFFER DAM
			218+02.63 LT.	218+42.75 LT.			INSTALL	(T)							EROSION CONTROL
			218+10.45 LT.	218+26.96 LT.			CHANNEL	(P)	84.3 SF						
			218+21.39 LT.	218+94.46 LT.			INSTALL & MAINTAIN	(P)	420.7 SF						FOOTING & WINGWALL
			218+26.96 LT.	219+26.81 LT.			SLOPE	(T)	1117.6 SF						
			218+18.12 LT.	218+75.62 LT.			INSTALL	(T)							COFFER DAM
			219+34.00 LT.				DRIVE	(T)							15' GRAVEL MM 0413
			219+81.00 LT.				DRIVE	(T)							14' GRAVEL MM 0414
			220+21.44 LT.	220+40.70 LT.			INSTALL	(T)							EROSION CONTROL
			220+25.20 LT.	220+41.72 LT.			SLOPE	(T)	173.8 SF						
			219+72.02 LT.												MONITOR WELL W-1
			220+38.57 LT.				REMOVE & RESET	(T)							PROPERTY PIN
1B		18,19	218+22.36 LT.	220+38.57 LT.	0.24 A		ALL R.T. & I.								HWY. EASE. VT. RTE. 64
2A	YOUNG, ROSALIE A.	19	218+37.54 RT.	218+60.91 RT.	39.8 SF					WDIF	01/23/08	WILLIAMSTOWN	136	329-330	INCLUDES EROSION CONTROL EROSION CONTROL
			217+66.69 RT.	217+98.15 RT.			SLOPE	(T)	61.3 SF						
			217+98.51 RT.	218+57.71 RT.			INSTALL	(T)							
			217+86.02 RT.	218+57.71 RT.			UTILITY	(T)							INCLUDE POLE & ANCHOR
			218+24.91 RT.	218+60.91 RT.			SLOPE	(T)	217.2 SF						INCLUDES EROSION CONTROL
			218+52.16 RT.				REMOVE	(T)							CULVERT
			217+55.00 RT.												DRIVE 13' PAVED MM 0410 INCLUDES RIGHT OF WAY IN COMMON / PARCEL #9
			218+50.00 RT.	218+62.04 RT.			DETOUR	(T)	8.0 SF						
2B		19	217+40.49 RT.	218+60.91 RT.	3006.0 SF		ALL R.T. & I.								HWY. EASE. VT. RTE. 64
3A	FORD, PATRICIA R.	19	218+60.91 RT.	220+01.04 RT.	1322.0 SF							WILLIAMSTOWN			12' GRAVEL MM 0412; ALSO ROW FOR PARCEL # 6 & # 7
			218+74.00 RT.				DRIVE	(T)							
			218+57.71 RT.	DETOUR 303+31.42 RT.			UTILITY	(T)							PROPERTY PIN
			218+60.91 RT.				REMOVE & RESET	(T)							EROSION CONTROL
			218+57.71 RT.	218+62.77 RT.			INSTALL	(T)							
			DETOUR 301+00.00 RT.				ACCESS	(T)							15' ALSO ACCESS FOR PARCEL #6&7
			218+80.32 RT.				INSTALL & MAINTAIN	(P)							GUARD RAIL
			218+79.76 RT.	220+15.33 RT.			SLOPE	(T)	1423 SF						INCLUDES EROSION CONTROL
			218+79.76 RT.	220+01.04 RT.			LANDSCAPE	(T)							SHRUBS AND TREES
			218+95.93 RT.	219+00.00 RT.			INSTALL	(T)							GUY WIRE & ANCHOR
			219+11.25 RT.	220+08.54 RT.			CONST.	(T)	0.06 A						
			219+31.66 RT.	219+92.88 RT.			ALL R.T. & I.								HOUSE AND APPURTENANCES
			219+31.66 RT.	219+92.88 RT.			REMOVE	(T)	1580 SF						HOUSE AND APPURTENANCES
			218+60.91 RT.	DETOUR 303+34.25 LT.			DETOUR	(T)	0.18 A						2-WAY VEHICULAR
			220+37.94 RT.	220+86.59 RT.			INSTALL	(T)							COFFER DAM
			220+53.82 RT.	220+55.74 RT.			CULVERT	(P)							
			220+40.24 RT.	220+61.34 RT.			SLOPE	(P)	45.1 SF						
			220+76.65 RT.	DETOUR 303+34.55 LT.			UTILITY	(T)							
			DETOUR 302+11.97 RT.				ACCESS	(T)							13' WIDE ACCESS FROM DETOUR
			220+01.04 RT.	220+04.84 RT.			INSTALL	(T)							COFFER DAM
			DETOUR 303+29.00 RT.				REMOVE & RESET	(T)							FENCE
			DETOUR 302+41.02 LT.	DETOUR 303+31.07 LT.			INSTALL	(T)							EROSION CONTROL
3B		19	218+60.91 RT.	221+13.55 RT.	0.14 A		ALL R.T. & I.								HWY. EASE. VT. RTE. 64

TABLE OF REVISIONS

REVISION NO.	SHEET NO.	DESCRIPTION	DATE
1	16	PARCEL NO. 2 YOUNG. CHANGE ENDING STATION OF INSTALL (T) FROM 218+66.96 RT. TO 218+57.71 RT. CHANGE TAKE AREA OF PARCEL 2B FROM 2435 SF± TO 3006.0 SF±. PER C.O. 9501. MADE BY:MR APPROVED BY:HP	11/06/07
2	16,17,19,20	PARCEL NO. 14 TRUSTEES OF CENTENARY METHODIST CHURCH-LESSOR. RANDOLPH NATIONAL BANK-LESSEE. ADD SHEET 19 TO SHEET NUMBER ON DETAIL SHEET. ADD ADDITIONAL LEASE AREA TO SHEET 19. CHANGE DETOUR BEGINNING STA. TO +00.79 AND INCREASED AREA TO 0.11A±. CHANGE BEGINNING STA. FOR PAVED AREA TO +00.79 AND INCREASED AREA TO 3167SF±. CHANGE BEGINNING STA FOR UTILITY(T) TO +10.03RT. PER C.O. 9403. MADE BY: JAB APPROVED BY: HP	12/13/07
3	16,17,19,20	PARCEL NO. 5 TRUSTEES OF CENTENARY METHODIST CHURCH. CHANGE AREA OF DETOUR FROM 2950.2 SF TO 2534.2 SF. CHANGE ENDING STA. OF UTILITY (T) FROM 26.73LT TO 10.03RT. CHANGE ENDING STA. INSTALL (T) FROM +25.00LT TO +00.79LT. PER C.O. 9504. MADE BY: JAB APPROVED BY: HP	12/13/07
4	16	PARCEL NO. 1 BEATTIE. CREATED TWO PARCELS ON THE DETAIL SHEET. PARCEL 1 AND 1B. PARCEL 1 WILL SHOW ALL THE (T) AND (P) RIGHTS. PARCEL 1B WILL SHOW ALL R.T.&I IN HWY EASE. VT RTE 64. RIGHT OF WAY SHEETS 18 AND 19 WILL SHOW THE EXISTING RIGHT OF WAY AS PARCEL 1B. PER C.O. 9506. MADE BY: JAB APPROVED BY: HP	12/28/07

PLAN LEGEND

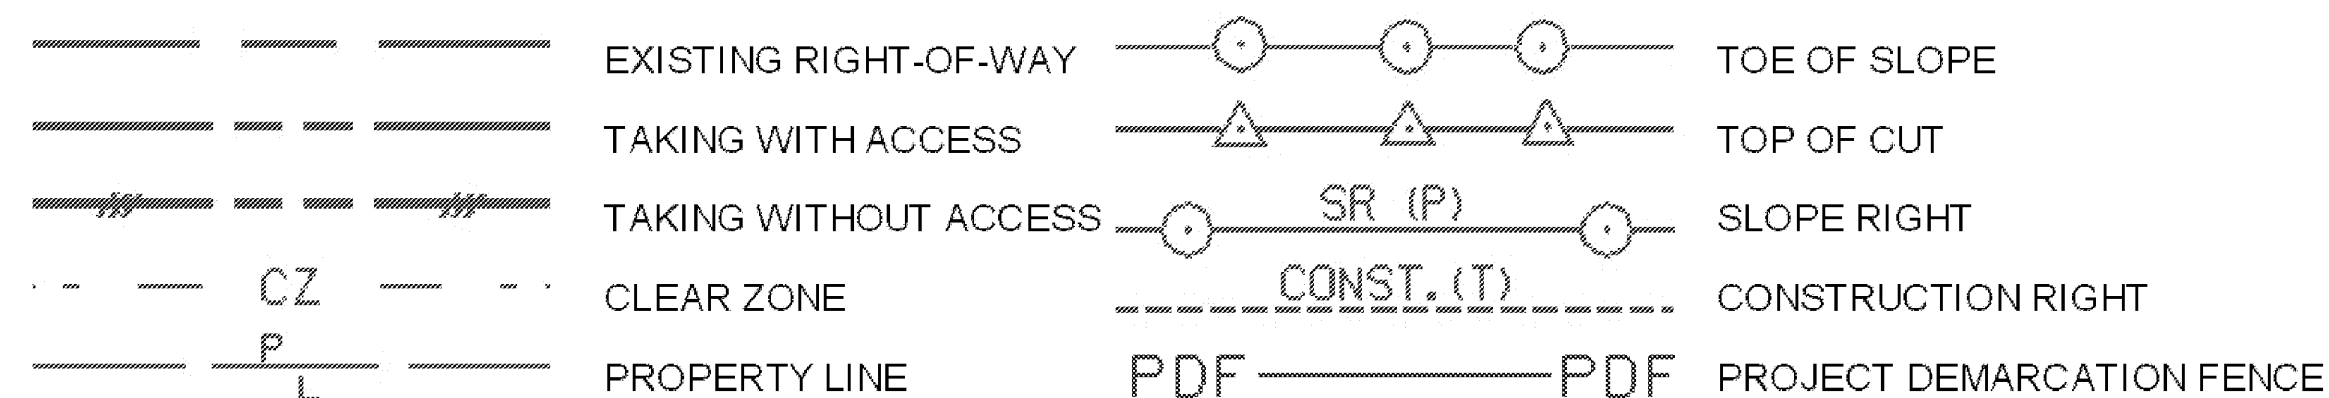

- EC - EROSION CONTROL
- (P) - PERMANENT
- (T) - TEMPORARY
- DR. - DRAINAGE RIGHT
- DIT. - DITCHING RIGHT
- CH. - CHANNEL RIGHT
- DRIVE - DRIVE RIGHT
- CUL. - CULVERT RIGHT
- C&T - CLEARING & TRIMMING RIGHT
- SR - SLOPE RIGHT
- UE - UTILITY EASEMENT

APPROVED: ROGER P. DUMAS DATE: 06-30-2006
CHIEF, PLANS & TITLES

PLOT DATE 03/05/08

PROJECT NAME:	WILLIAMSTOWN	PLOT DATE:	Date
PROJECT NUMBER:	BRS 0204(4)	DRAWN BY:	MR
FILE NAME:	83E111DET.XLS	CHECKED BY:	FM
PROJECT LEADER:	EVANS-MONGEON	SHEET	11 OF 108
DESIGNED BY:	LACKEY		
R.O.W. SHEET 16 of 20			