
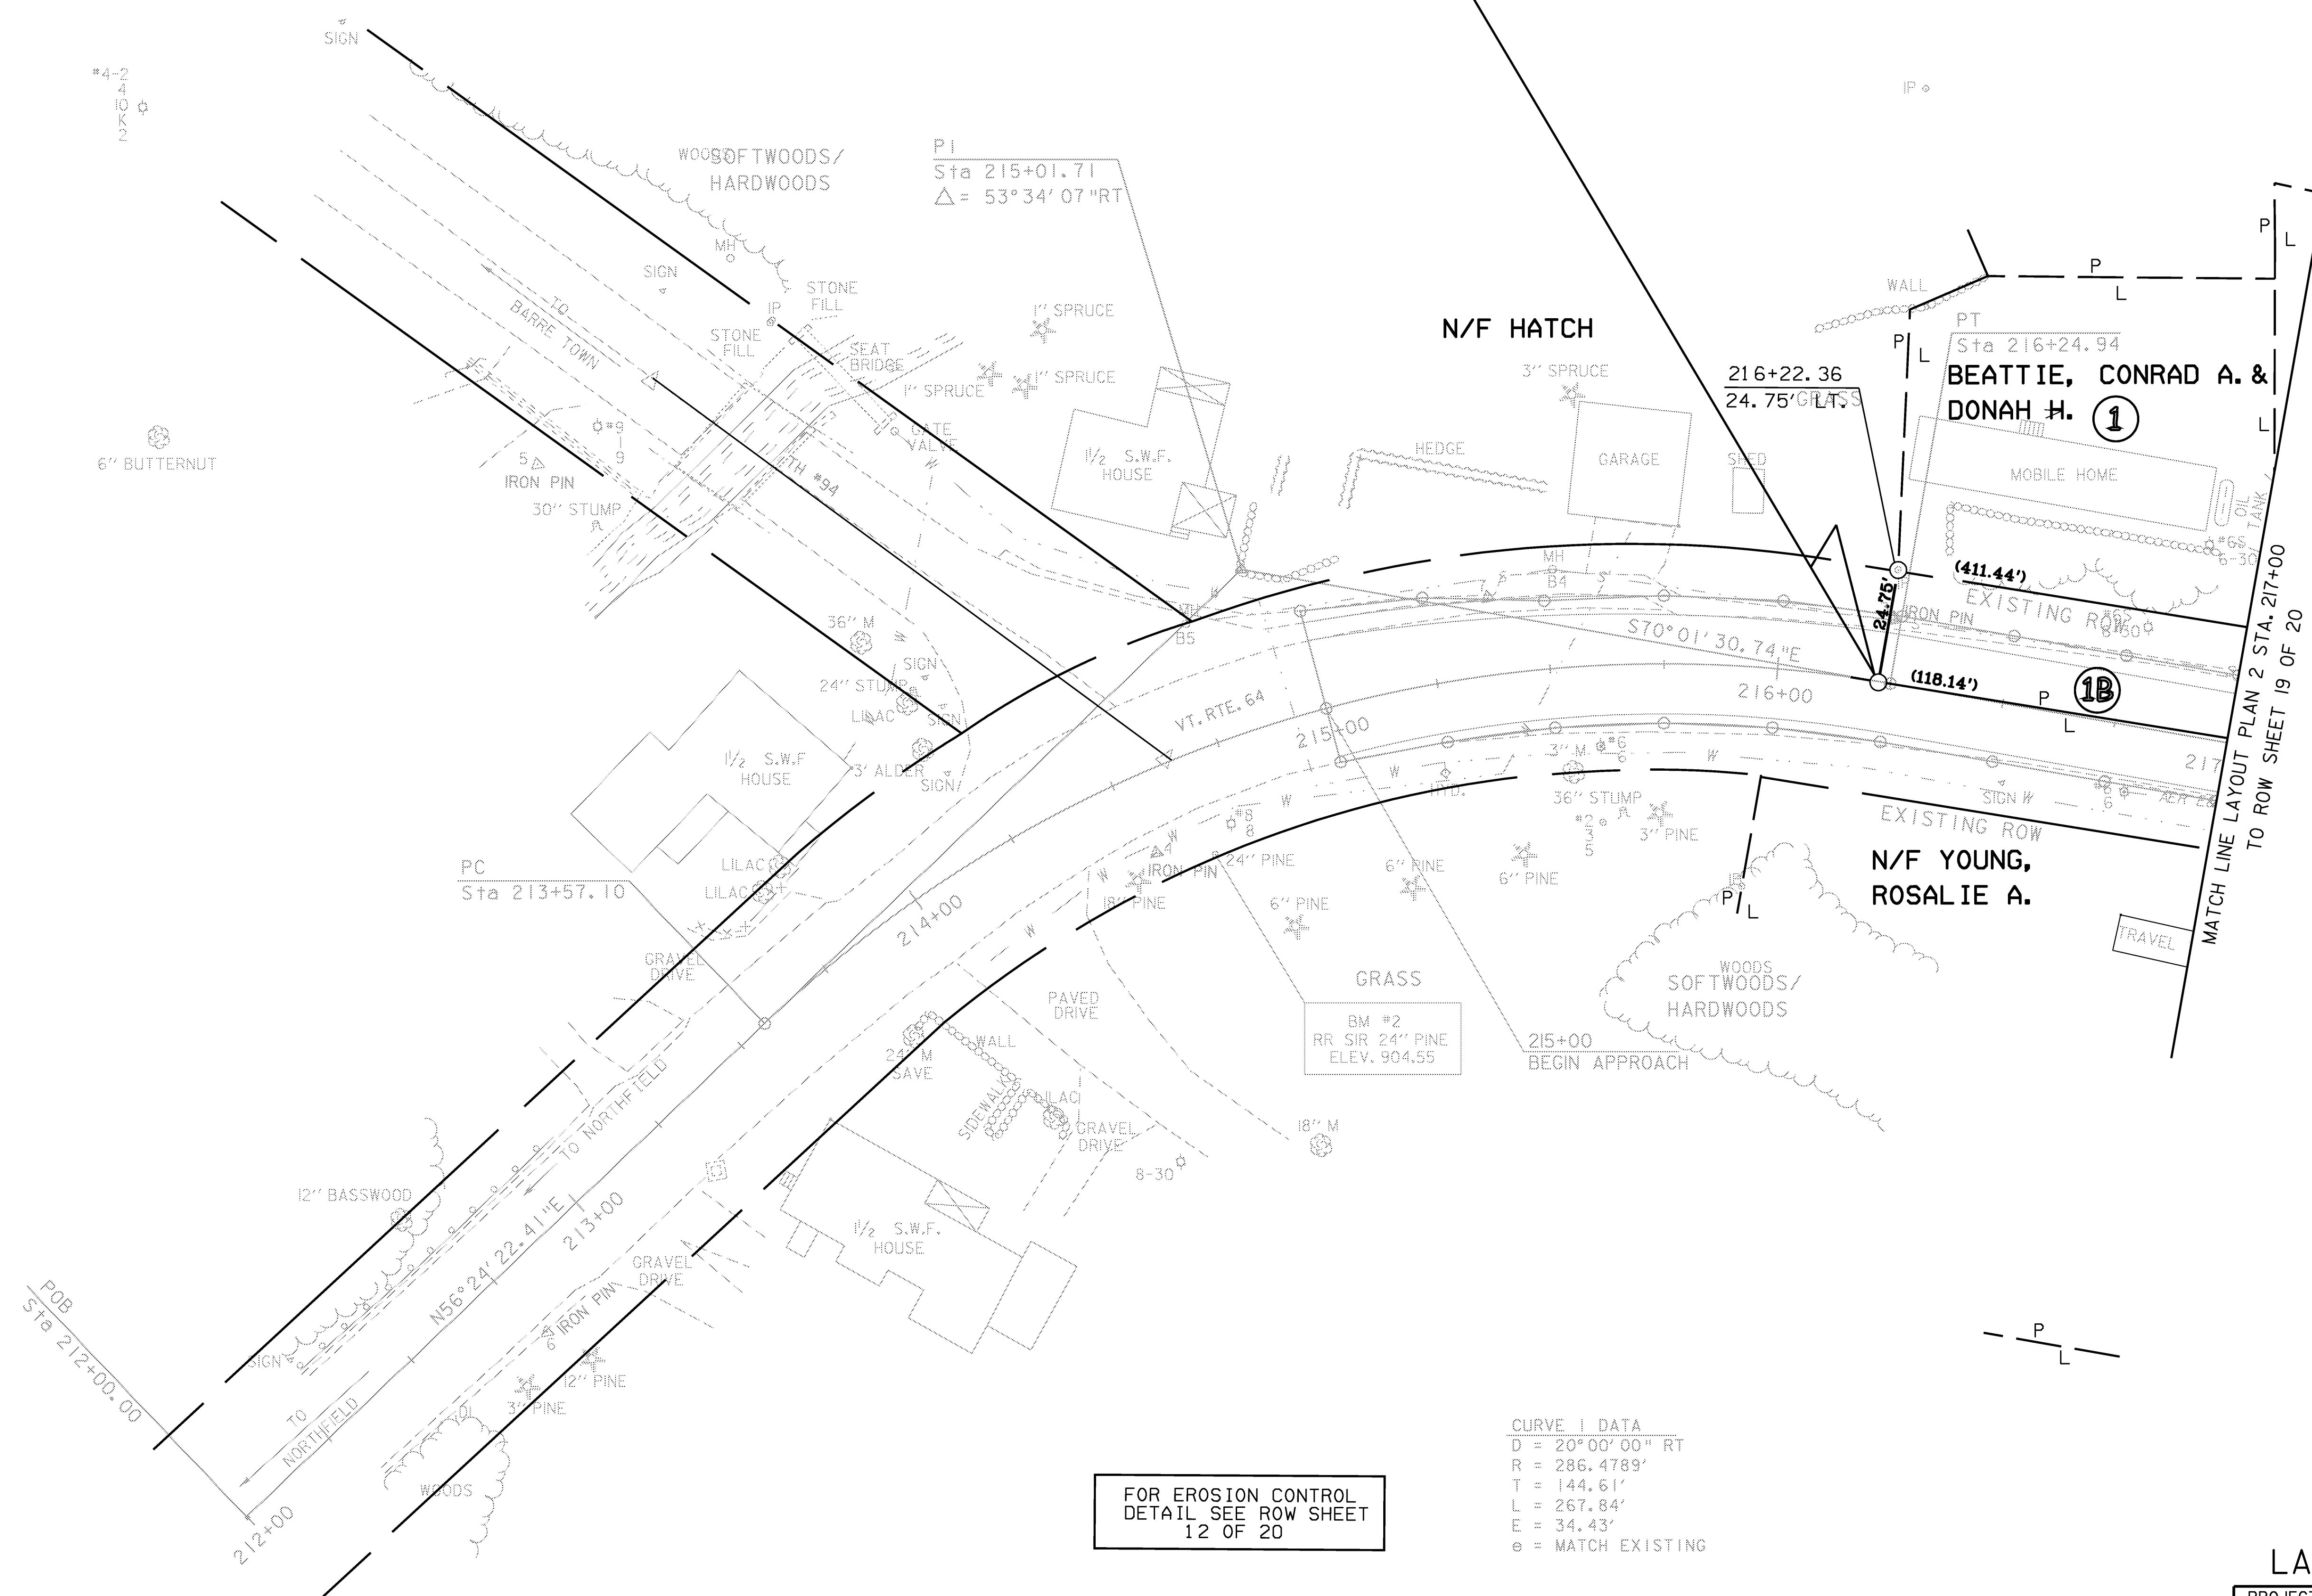



BEGIN ROW PROJECT

BRS 0204(4) Sta. 216+22.36 CL

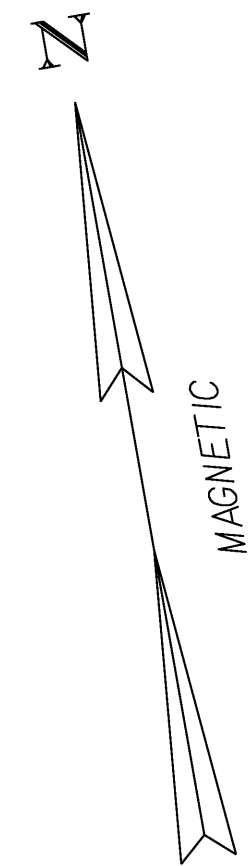

FOR EROSION CONTROL
DETAIL SEE ROW SHEET
12 OF 20

CURVE DATA
D = 20°00'00" RT
R = 286.4789'
T = 144.61'
L = 267.84'
E = 34.43'
e = MATCH EXISTING

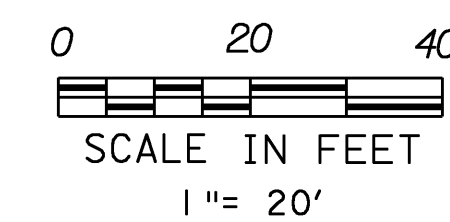

LAYOUT PLAN I

**FOR R.O.W.
USE ONLY**

PROJECT: WILLIAMSTOWN	PROJECT NO. : BRS 0204(4)
DESIGN FILE NAME: /str2/83ell/dellbdr.dgn	PLOT DATE: 07-APR-2008
IPARM FILE NAME: dellpl1	SURVEY DATE: 9/89
SURVEYED BY: GILMAN	DRAWN BY: LACKEY
SQUAD LEADER: EVANS-MONGEON	SHEET 13 OF 108
ROW SHEET 18 OF 20 SHEETS	

DATUM	
VERTICAL	NGVD 1929
HORIZONTAL	