


TO ROW SHEET 19 OF 20
MATCH LINE LAYOUT PLAN 2 STA 222+00

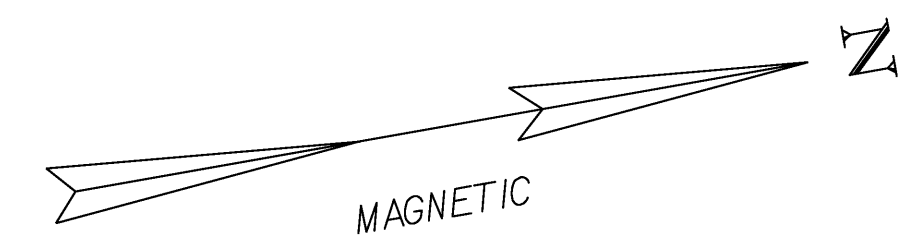


HD STEEL BEAM GUARD RAIL,
GALVANIZED
W/ 8 FEET POSTS
222+00 RT. - 223+45.5 RT.

ANCHOR FOR STEEL BEAM RAIL
223+45.5 RT. (GI-D)


END ROW PROJECT
BRS 0204(4) Sta.223+79.23
91.87' RT.

FOR EROSION CONTROL
DETAIL SEE ROW SHEET
14 OF 20

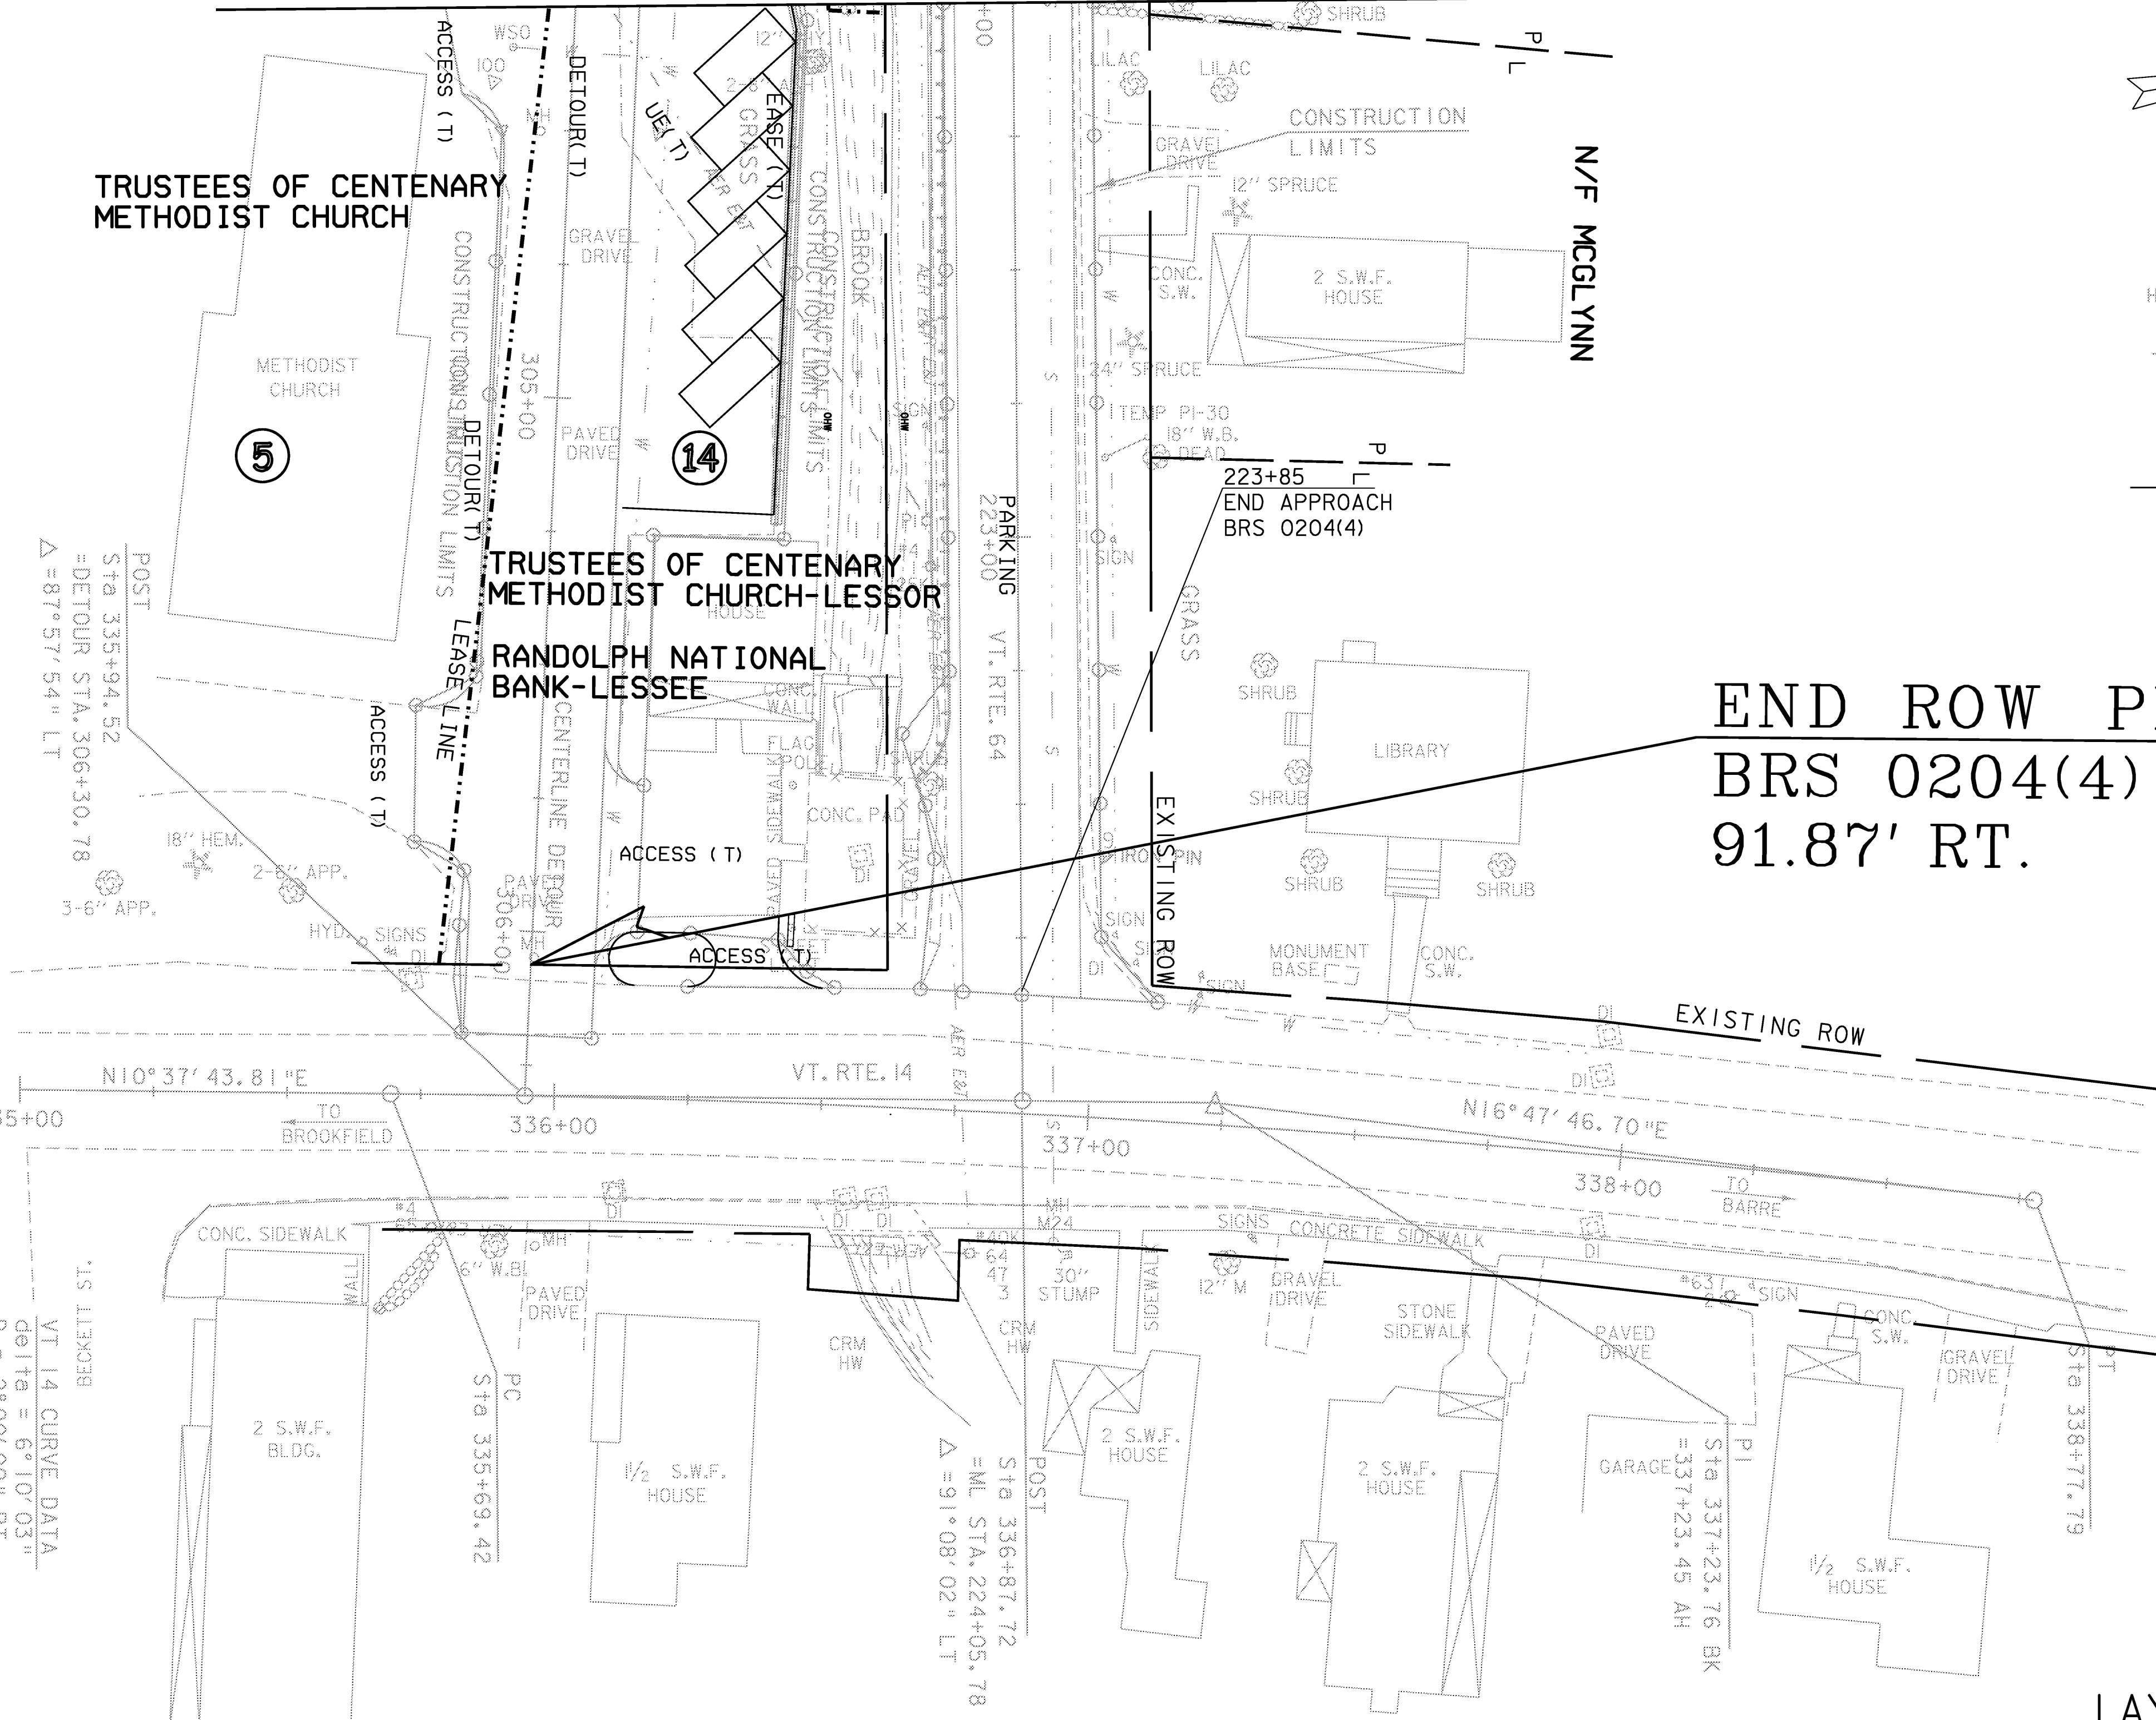

VT 14 CURVE DATA
delta = 5° 10' 03"
D = 2° 00' 00" RT
R = 2864.7890'
T = 154.34'
L = 308.37'
E = 4.15'

BM S-15
DISK ON GRANITE STEP
ELEV. 872.22

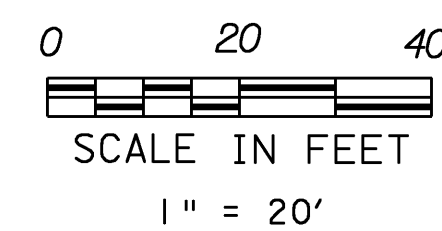

LAYOUT PLAN 3

**FOR R.O.W.
USE ONLY**

PROJECT: WILLIAMSTOWN	PROJECT NO. : BRS 0204(4)
DESIGN FILE NAME: str2/83ell/dellbdr.dgn	PLOT DATE: 07-APR-2008
IPARM FILE NAME: dellpl3.1	SURVEY DATE: 9/89
SURVEYED BY: GILMAN	DRAWN BY: LACKEY
SQUAD LEADER: EVANS-MONGEON	SHEET 15 OF 108
ROW SHEET 20 OF 20 SHEETS	

DATUM	
VERTICAL	NGVD 1929
HORIZONTAL	