


**CURVE 1 DATA**  
 D = 20°00'00" RT  
 R = 286.4789'  
 T = 144.61'  
 L = 267.84'  
 E = 34.43'  
 e = MATCH EXISTING

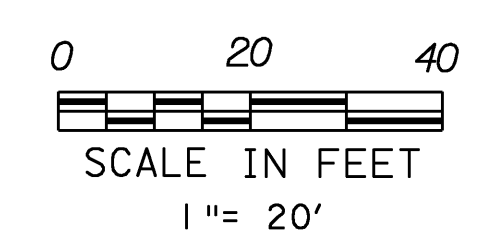

**PLAN SHEET 1**

|   |                                    |
|---|------------------------------------|
| PROJECT:<br><b>WILLIAMSTOWN</b>                         | PROJECT NO.:<br><b>BRS 0204(4)</b> |
| DESIGN FILE NAME: projects/83ell/structures/sellbdr.dgn | PLOT DATE: 07-APR-2008             |
| IPARM FILE NAME: s83ellpl1                              | SURVEYED BY: GILMAN                |
| SQUAD LEADER: EVANS-MONGEON                             | DRAWN BY: STANLEY                  |
| s83ellpl1   | SHEET: 17 OF 108                   |

**DATUM**  
 VERTICAL NGVD 1929  
 HORIZONTAL ASSUMED