


HD STEEL BEAM GUARD RAIL,
GALVANIZED
W/ 8 FEET POSTS
222+00 RT. - 223+45.5 RT.
48

ANCHOR FOR STEEL BEAM RAIL
223+45.5 RT. (GI-D)

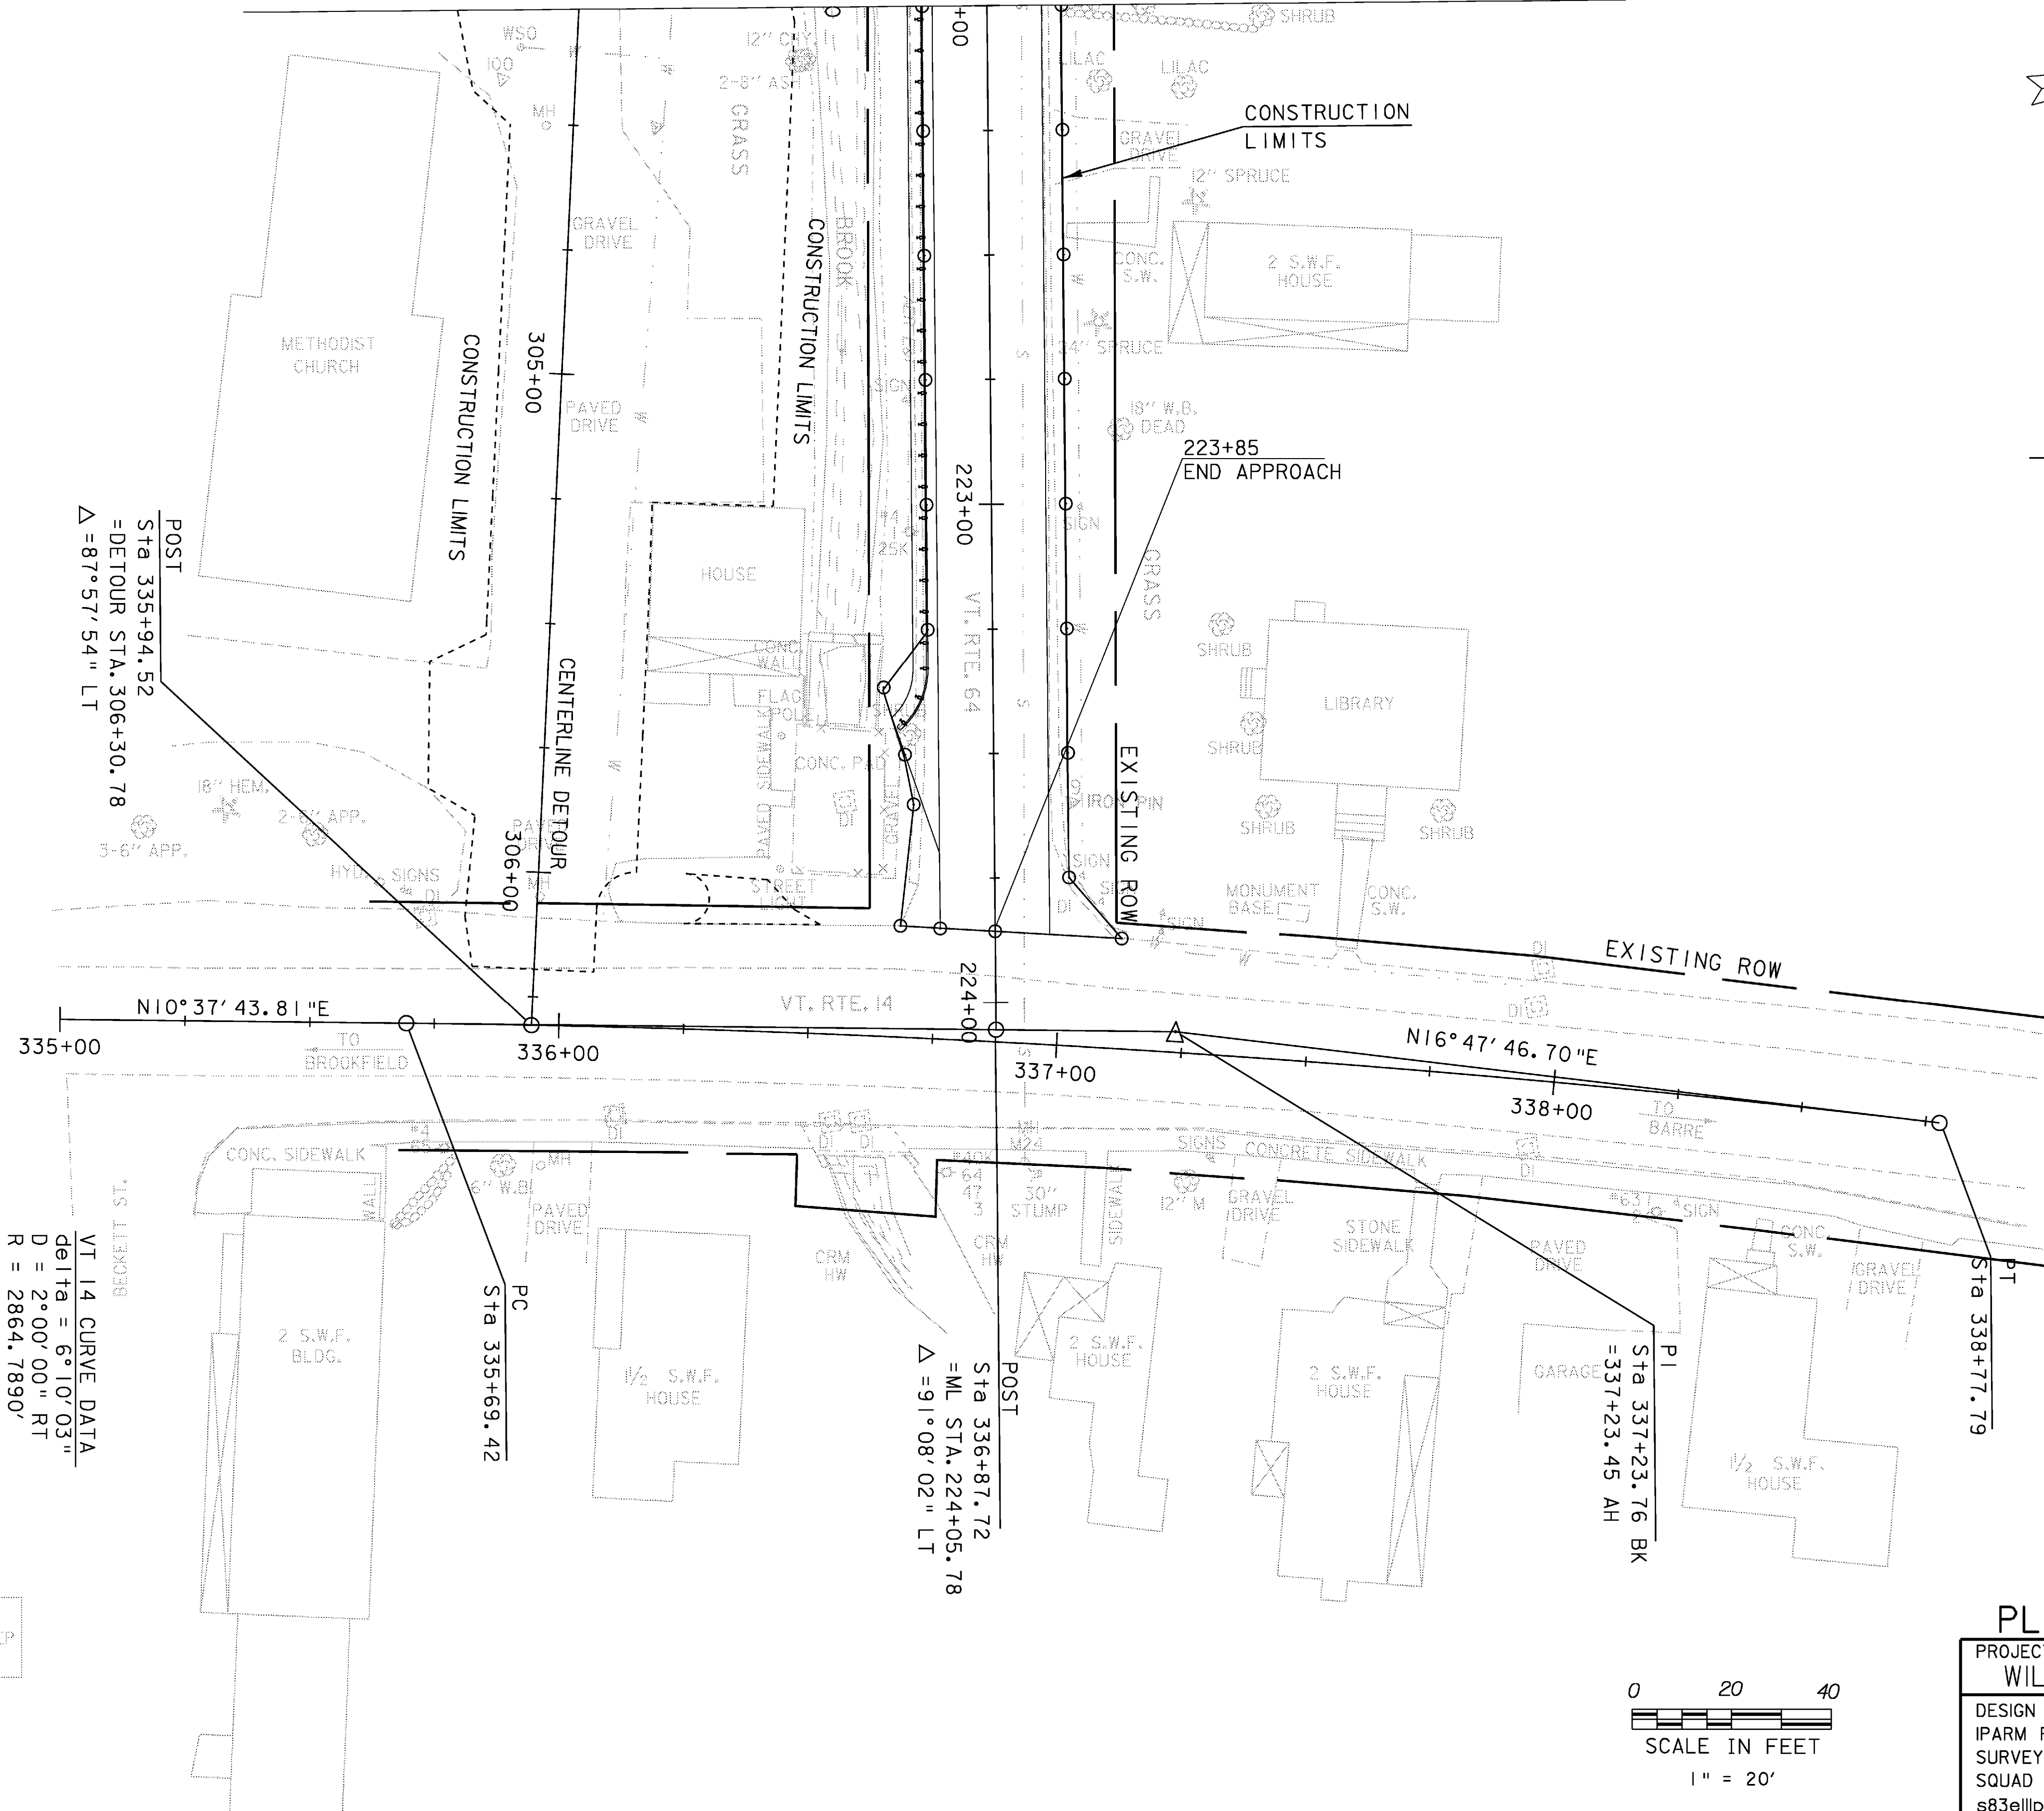


VT 14 CURVE DATA
delta = 6° 10' 03"
D = 2° 00' 00" RT
R = 2864.7890'
T = 154.34'
L = 308.37'
E = 4.15'

BM S-15
DISK ON GRANITE STEP
ELEV. 872.22

PLAN SHEET 3

PROJECT: WILLIAMSTOWN	PROJECT NO.: BRS 0204(4)
DESIGN FILE NAME: projects/83ell/structures/sellbdr.dgn	PLOT DATE: 07-APR-2008
IPARM FILE NAME: s83ellp3	SURVEY DATE: 9/89
SURVEYED BY: GILMAN	DRAWN BY: U. STANLEY
SQUAD LEADER: M. EVANS-MONGEON	SHEET: 19 OF 108
s83ellp3.1	

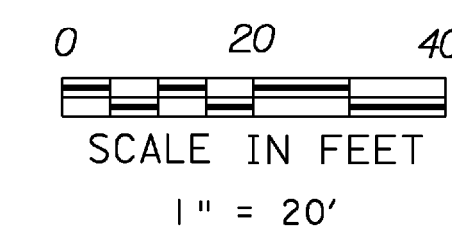

DATUM
VERTICAL NGVD 1929
HORIZONTAL ASSUMED