


MATCH LINE FINAL CONDITIONS PLAN SHEET 2 STA. 217+00

DATUM
 VERTICAL NGVD 1929
 HORIZONTAL ASSUMED

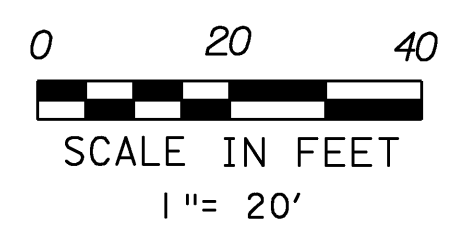

REFER TO CROSS SECTIONS FOR FINAL GRADING INFORMATION

FINAL CONDITIONS PLAN SHEET 1	
PROJECT: WILLIAMSTOWN	PROJECT NO.: BRS 0204(4)
DESIGN FILE NAME: /str2/83ell/dellero.dgn	PLOT DATE: 07-APR-2008
IPARM FILE NAME: sellfnl1	SURVEY DATE: 9/89
SURVEYED BY: GILMAN	DRAWN BY: U. STANLEY
SQUAD LEADER: M. EVANS-MONGEON	SHEET: 33 OF 108