
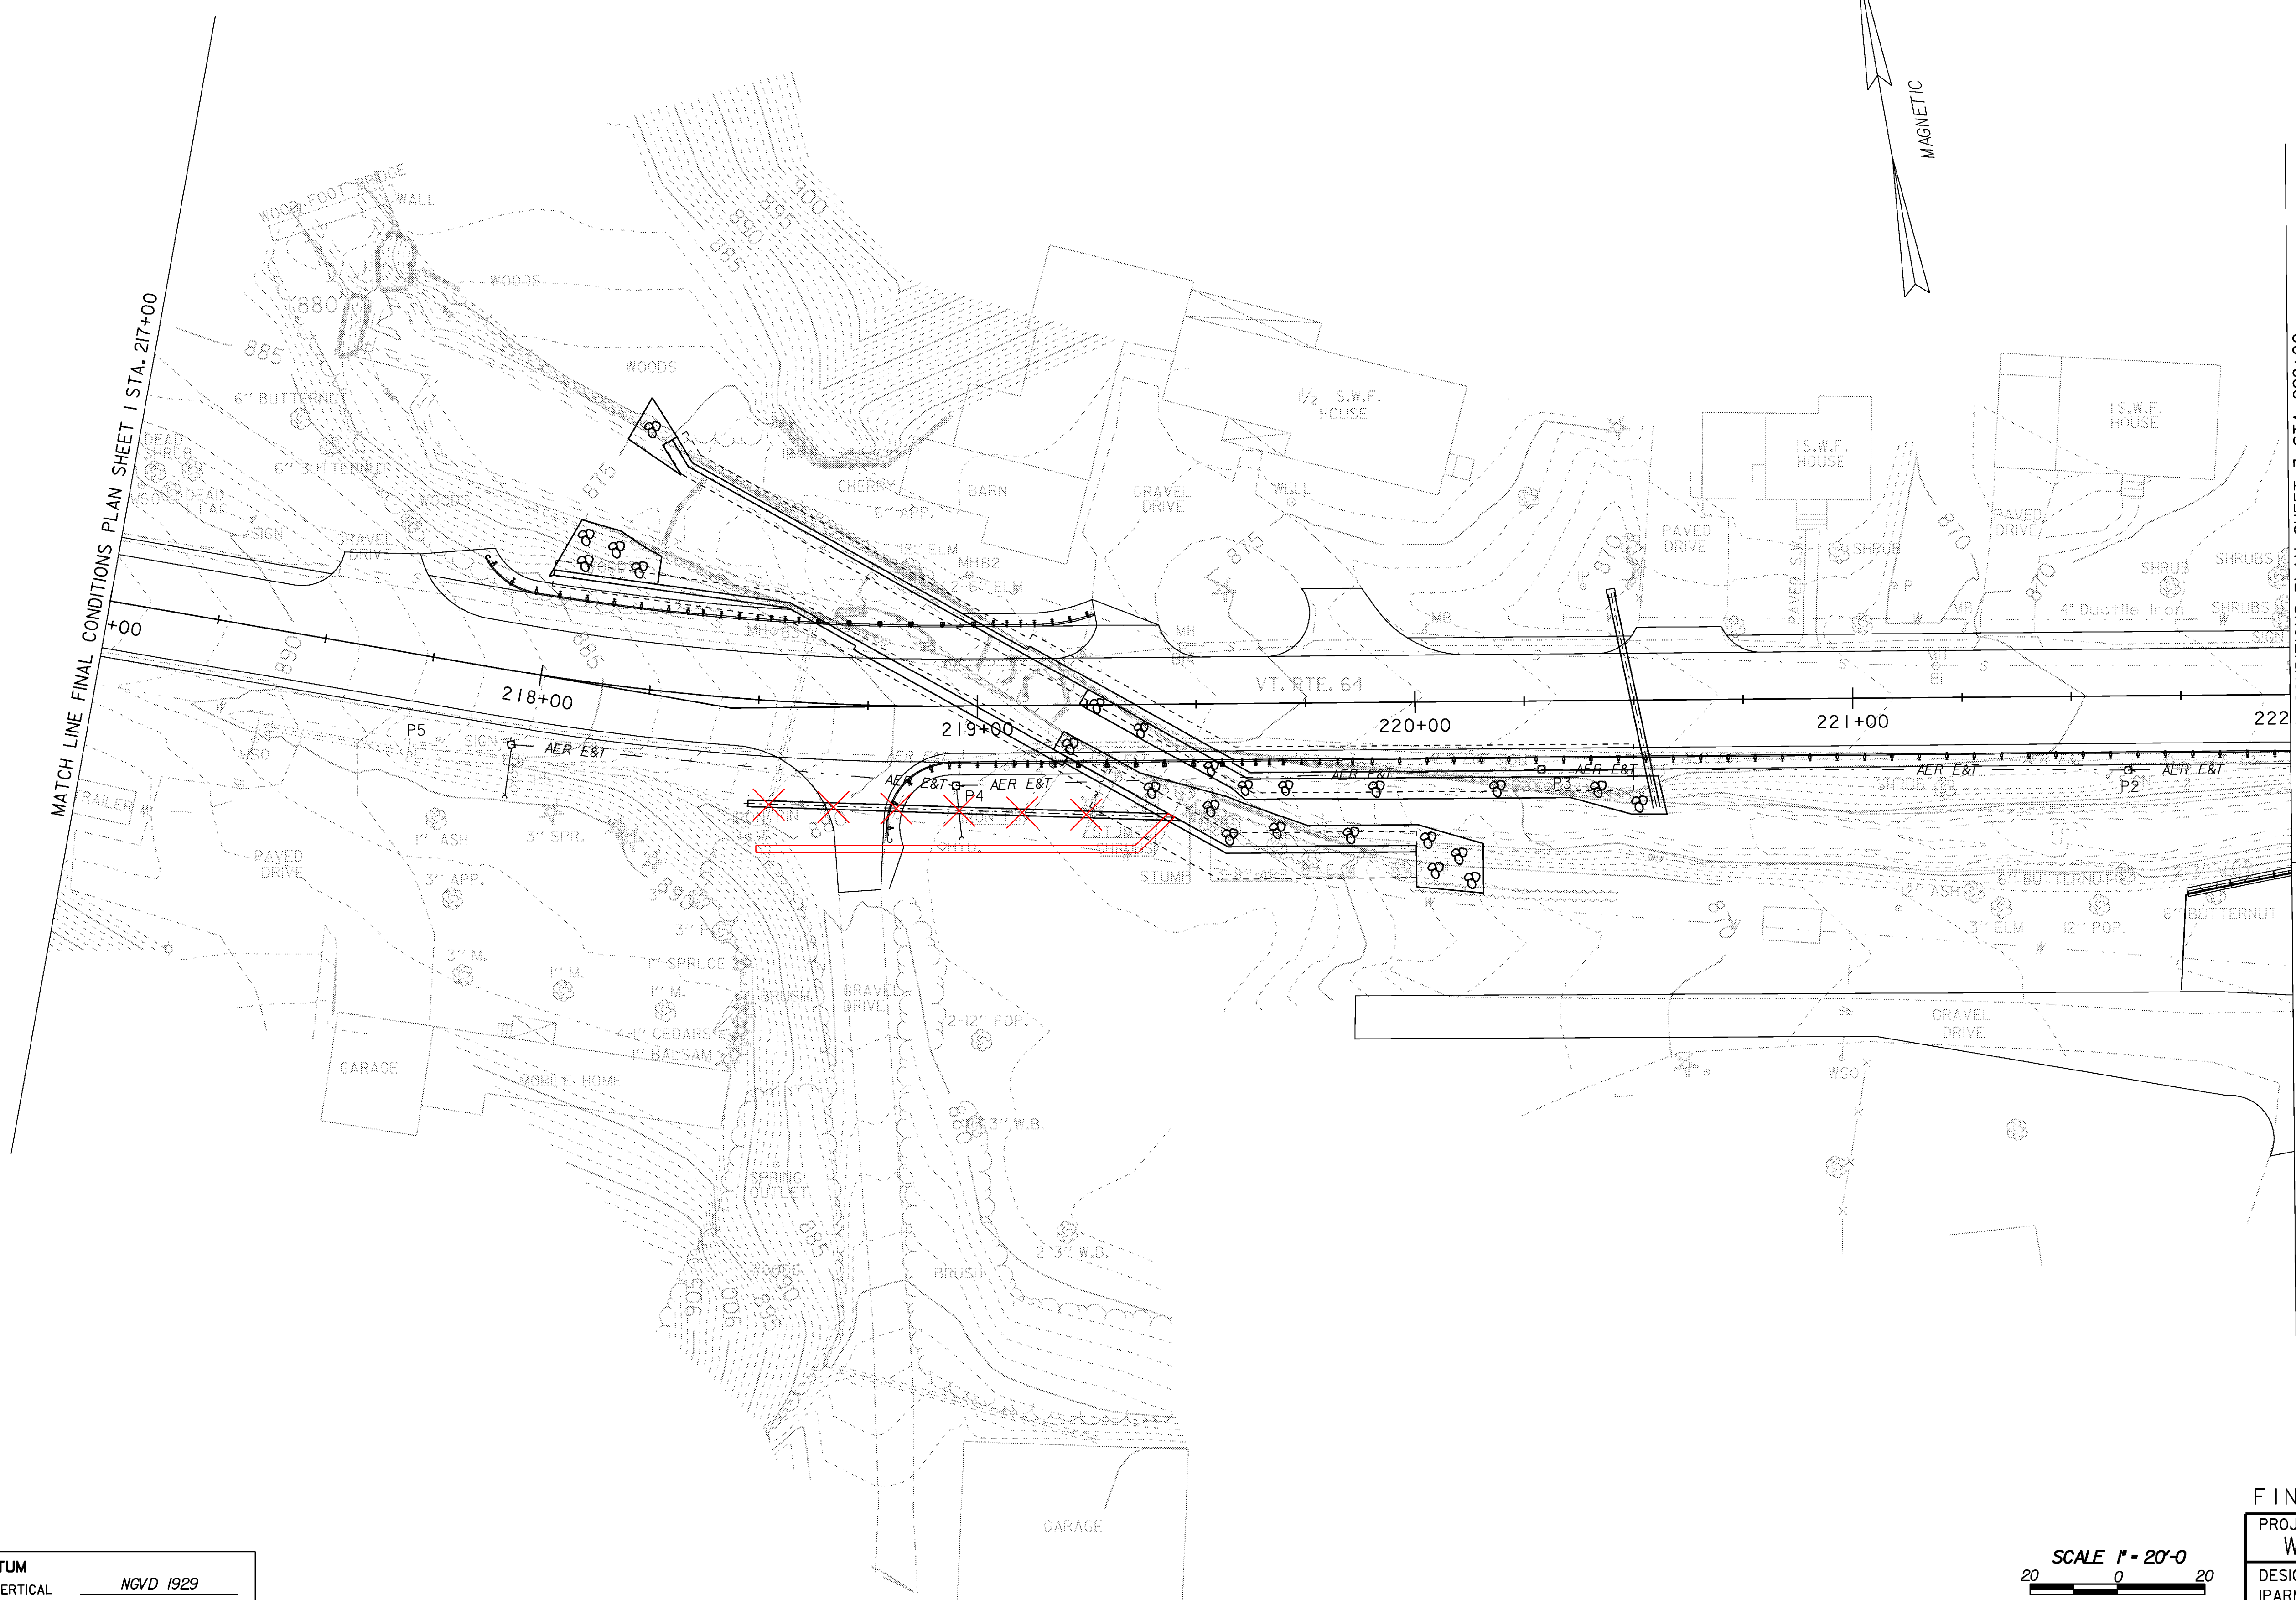



MATCH LINE FINAL CONDITIONS PLAN SHEET 1 STA. 217+00

MATCH LINE FINAL CONDITIONS PLAN SHEET 3 STA 222+00

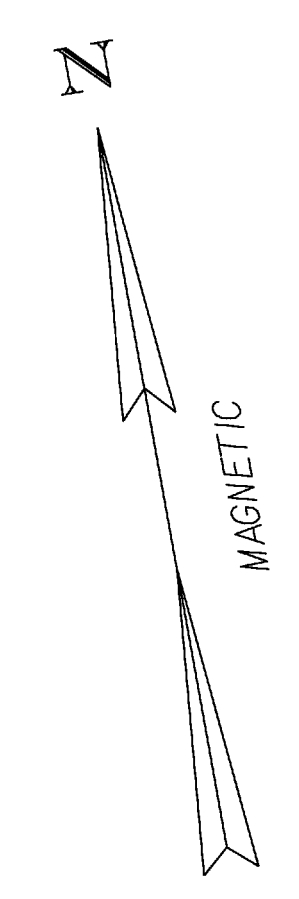

DATUM	
VERTICAL	NGVD 1929
HORIZONTAL	ASSUMED

REFER TO CROSS SECTIONS FOR FINAL GRADING INFORMATION

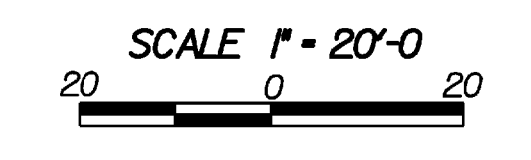

FINAL CONDITIONS PLAN SHEET 2	
PROJECT: WILLIAMSTOWN	PROJECT NO.: BRS 0204(4)
DESIGN FILE NAME: /str2/83ell/dellero.dgn	PLOT DATE: 07-APR-2008
IPARM FILE NAME: sellfni2	SURVEY DATE: 9/89
SURVEYED BY: GILMAN	DRAWN BY: U. STANLEY
SQUAD LEADER: M. EVANS-MONGEON	SHEET: 34 OF 108