

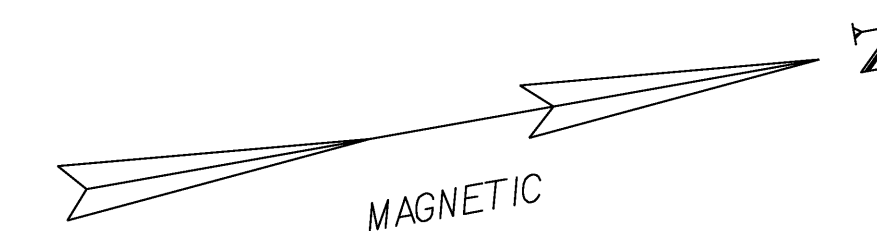


MATCH LINE FINAL CONDITIONS PLAN SHEET 2 STA 222+00

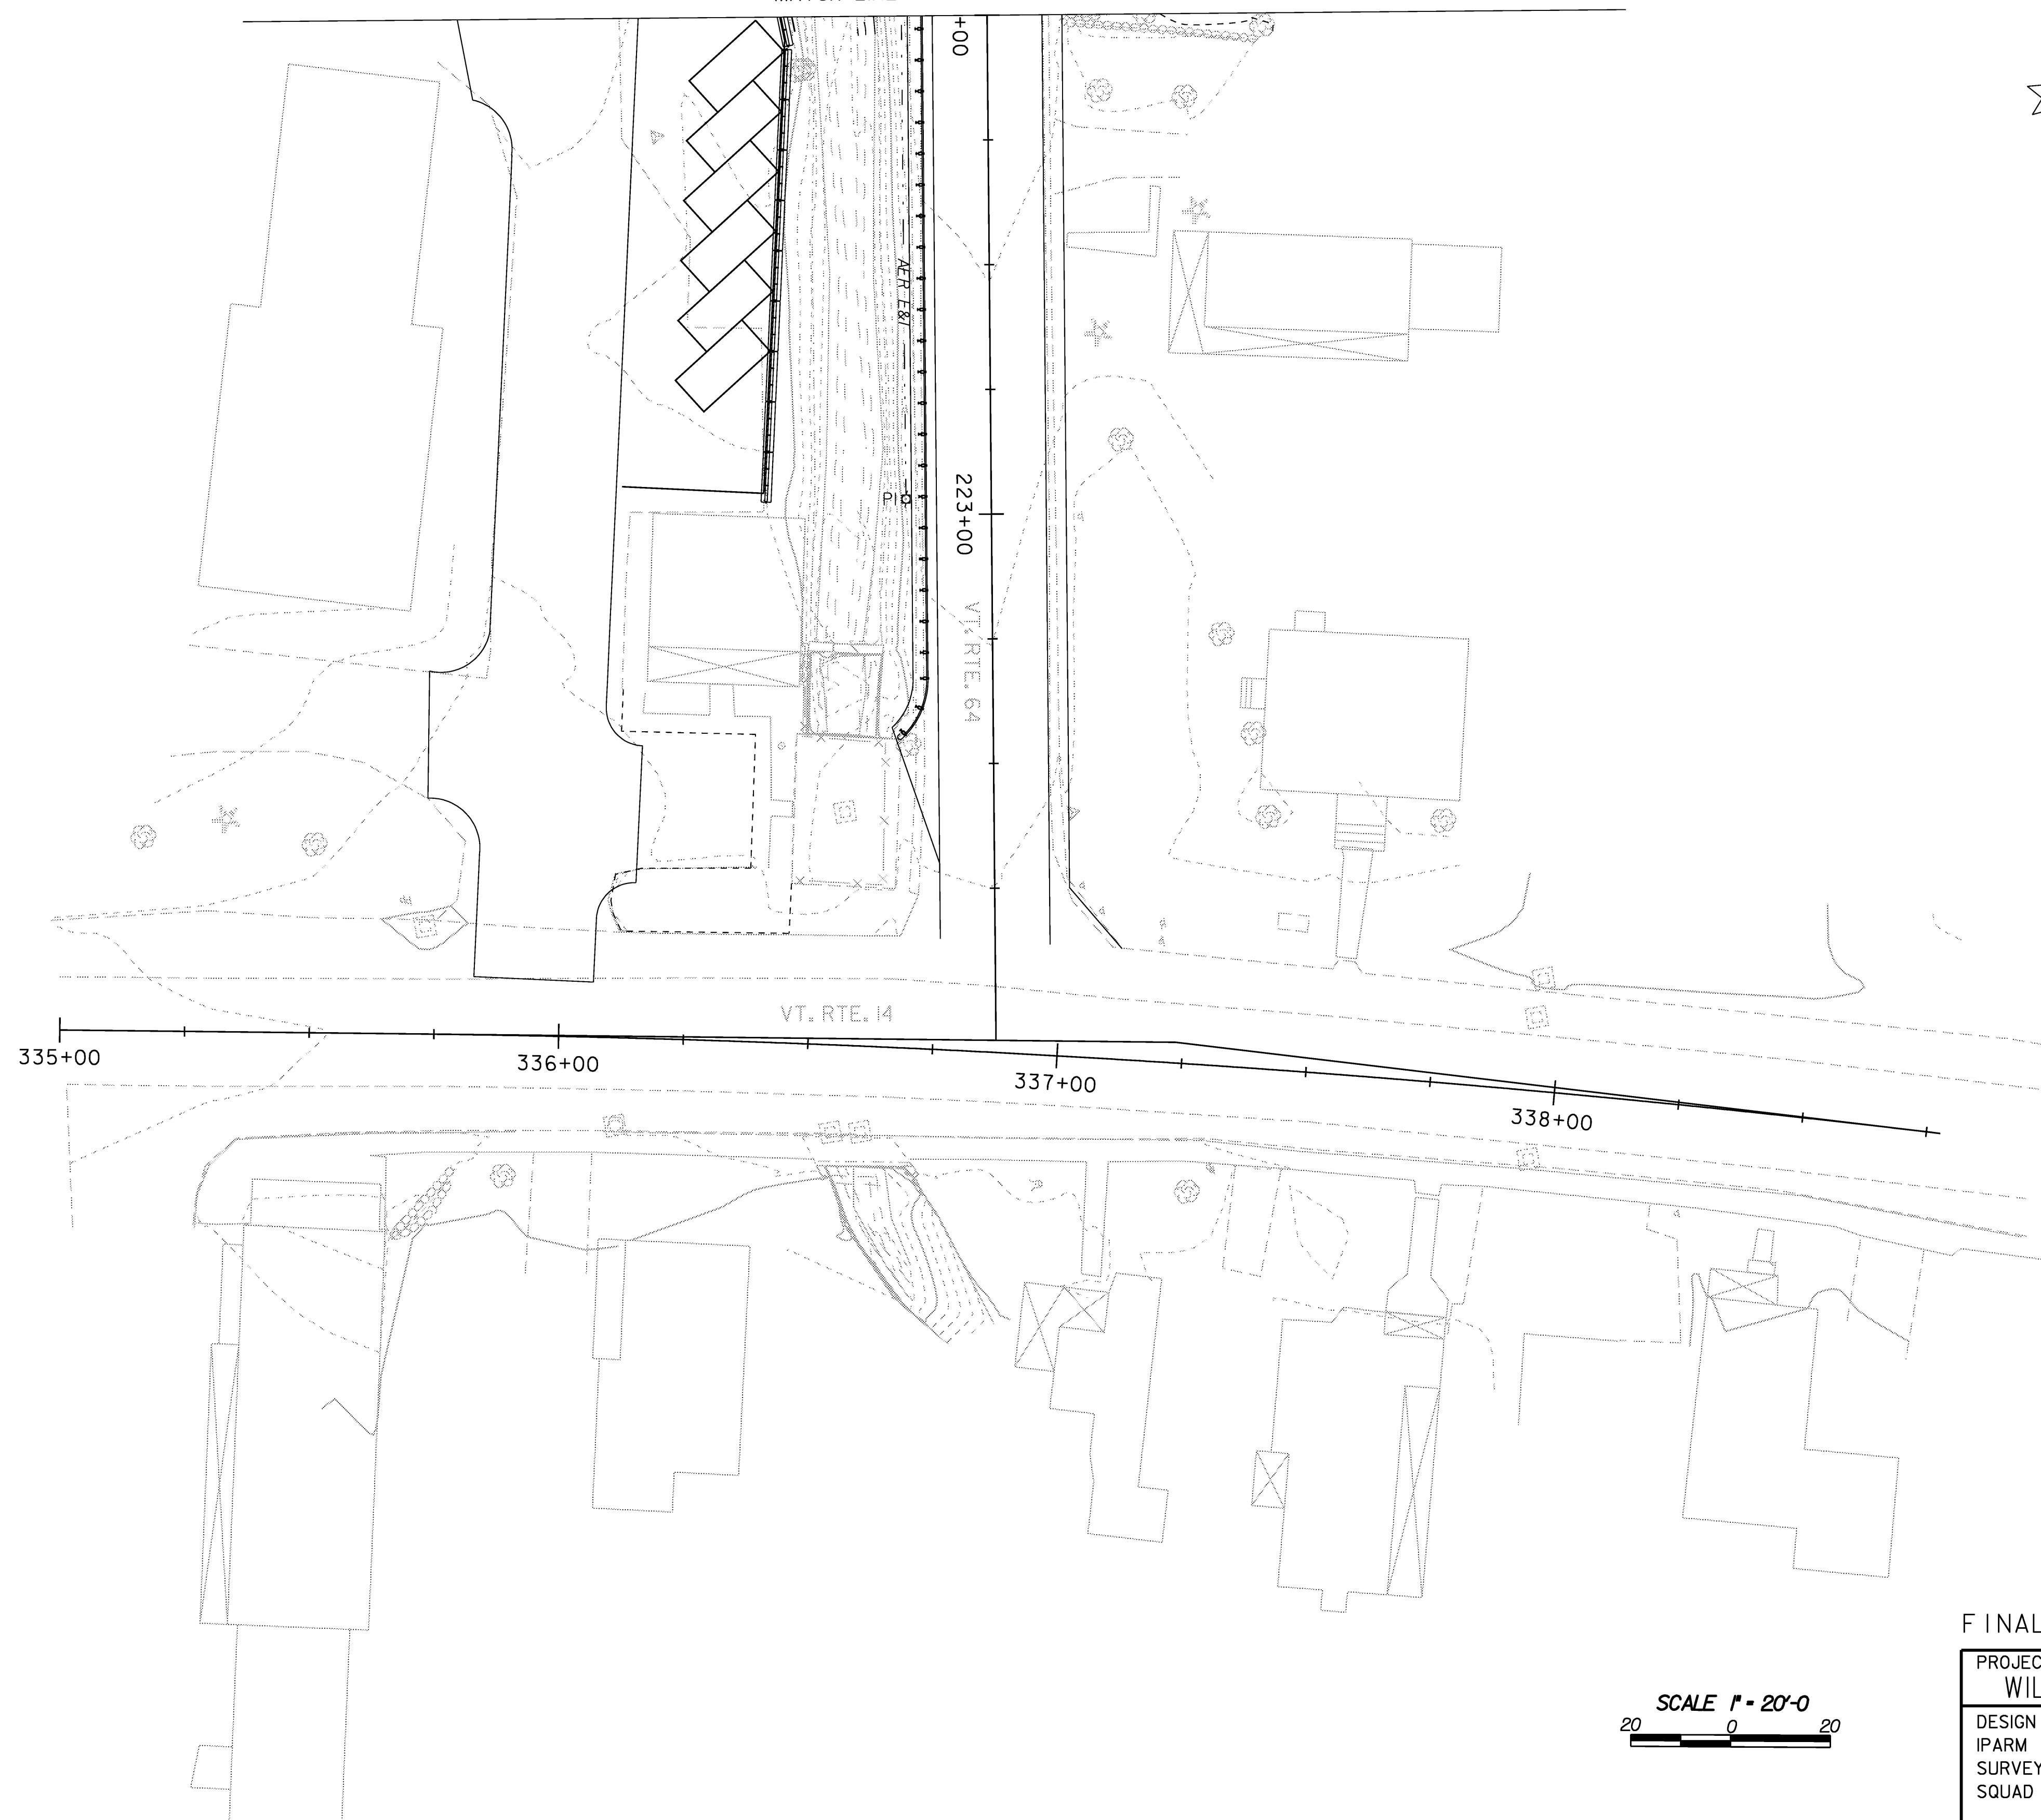

FINAL CONDITIONS PLAN SHEET 3

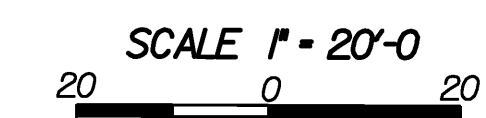

DATUM	
VERTICAL	NGVD 1929
HORIZONTAL	ASSUMED

PROJECT: WILLIAMSTOWN	PROJECT NO.: BRS 0204(4)
DESIGN FILE NAME: str2/83ell/dellero.dgn	PLOT DATE: 07-APR-2008
IPARM FILE NAME: sellfn13	SURVEY DATE: 9/89
SURVEYED BY: GILMAN	DRAWN BY: U. STANLEY
SQUAD LEADER: M. EVANS-MONGEON	SHEET: 35 OF 108