


# TRAFFIC CONTROL NOTES

1. THE NO PARKING SIGNS, R8-3a, ARE TEMPORARY AND SHALL BE REMOVED AT THE END OF CONSTRUCTION.
2. PORTABLE CHANGABLE MESSAGE BOARDS SHALL BE PLACED ON I89 AT THE FOLLOWING LOCATIONS:  
 SB I89 @ MM ~~47.2~~ AT EXISTING TRUCK WARNING SIGN ~~48.80~~  
 NB I89 @ MM ~~42.2~~ AT EXISTING TRUCK WARNING SIGN ~~39.45~~
3. TEMPORARY 4" WHITE LINES SHALL BE USED TO MARK THE RANDOLF NATIONAL BANK EMPLOYEE PARKING LOCATED ON VT ROUTE 64. THESE MARKING SHALL BE REMOVED PRIOR TO TRAFFIC RETURNING TO VT ROUTE 64, AFTER THE TEMPORARY ROADWAY IS NO LONGER IN USE.

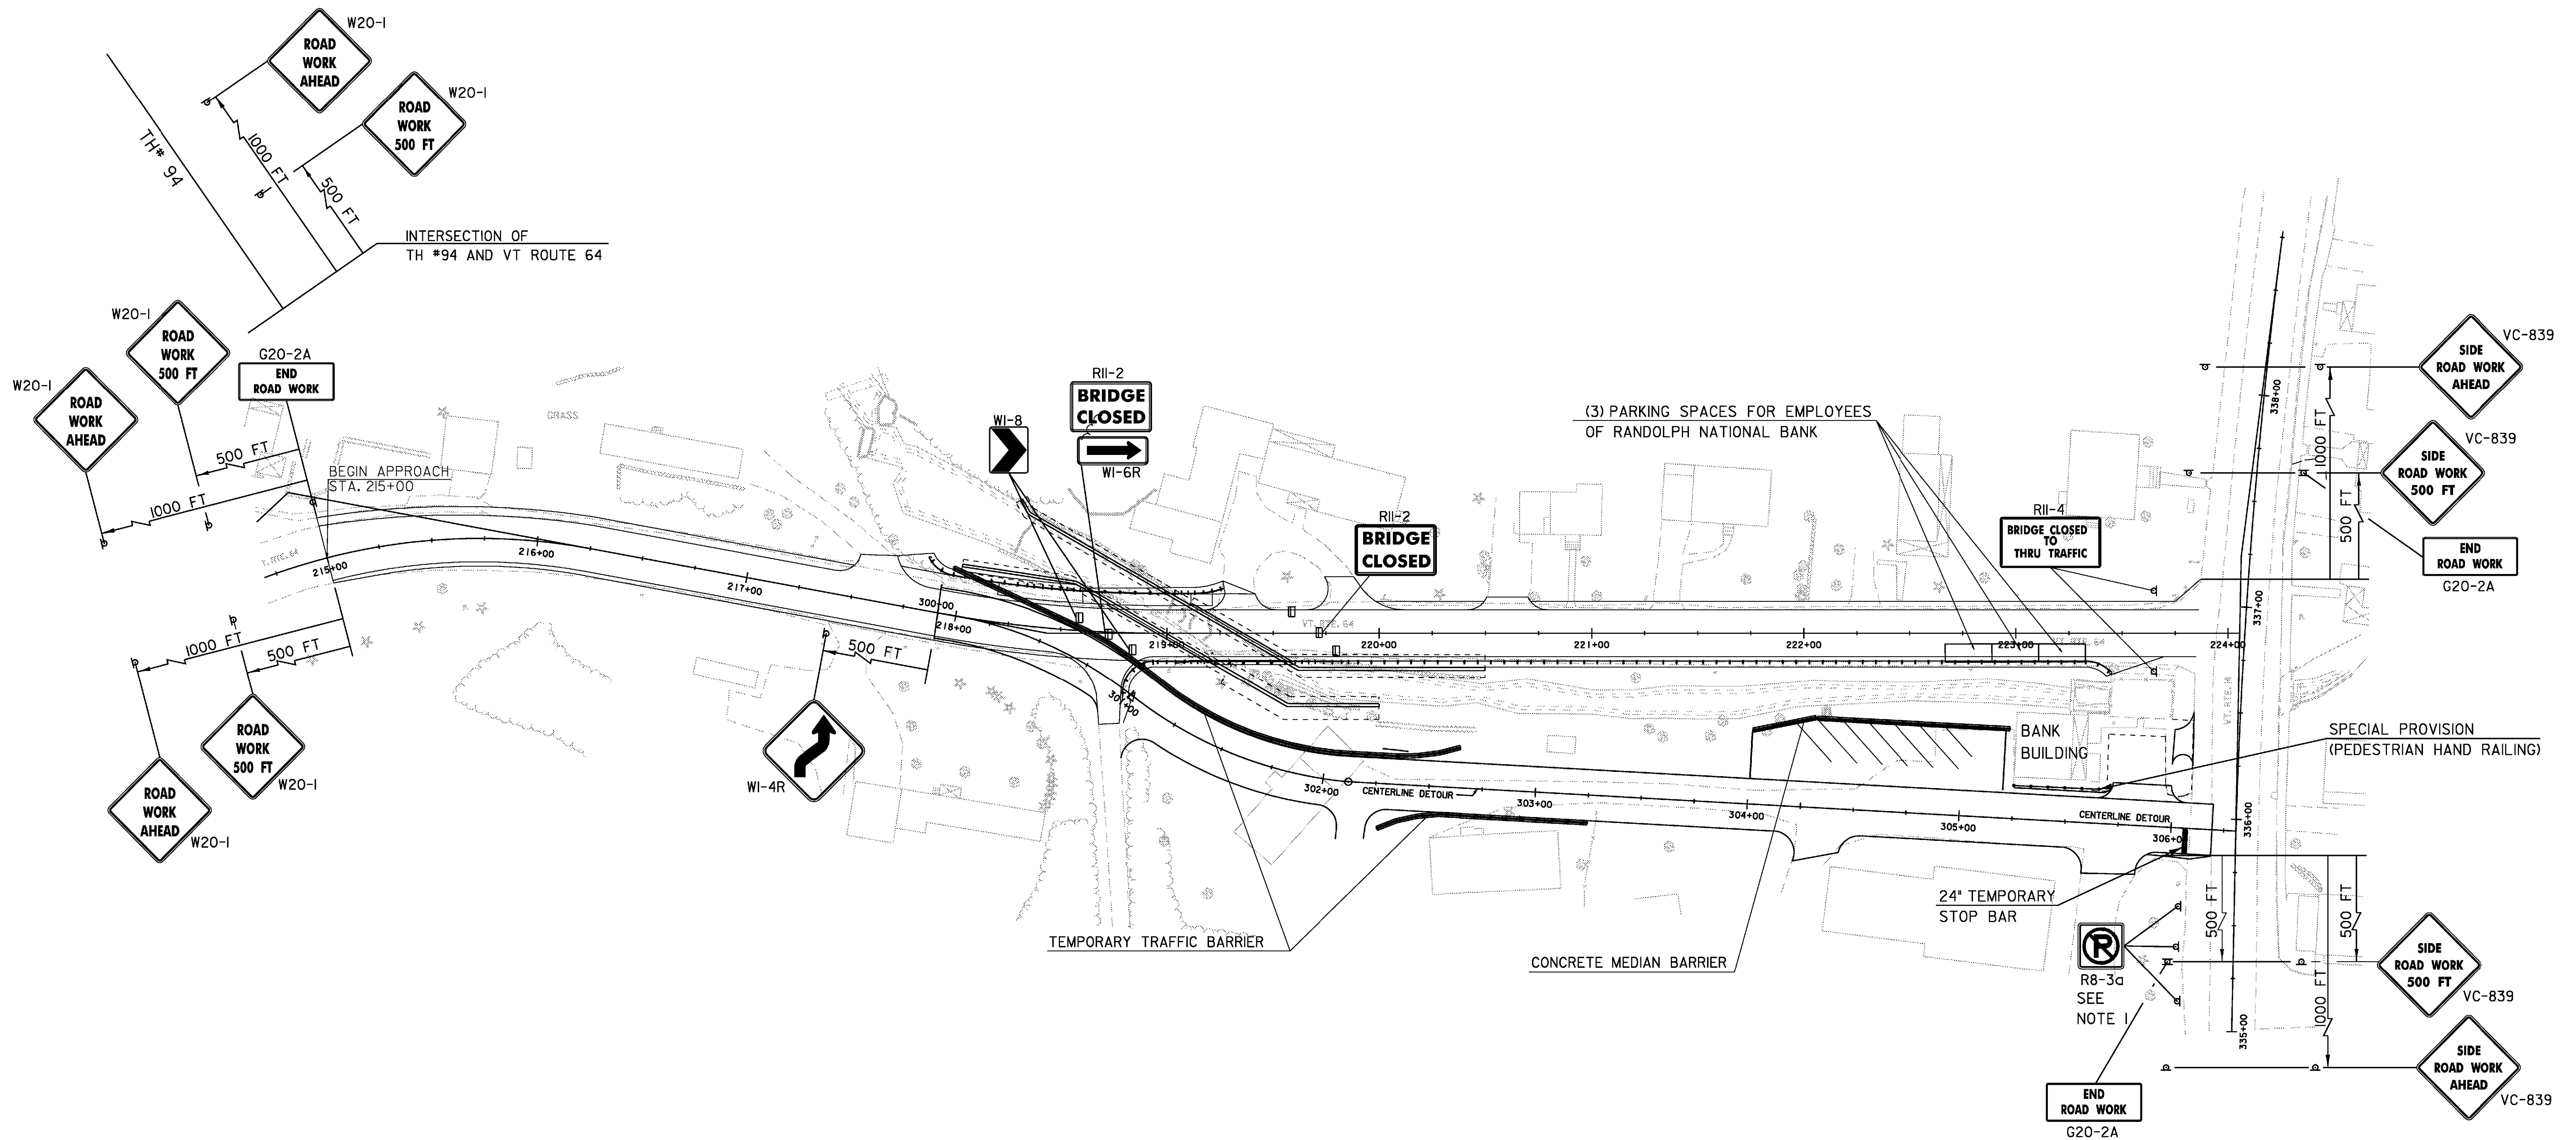

DRAWING NOT TO SCALE

LEGEND	
	TYPE III BARRICADE

## TRAFFIC CONTROL SHEET

PROJECT NAME: WILLIAMSTOWN  
 PROJECT NUMBER: BRS 0204(4)

FILE NAME: 83eill\structures\seill\ts.dgn	PLOT DATE: 07-APR-2008
PROJECT LEADER: M. EVANS-MONGEON	DRAWN BY: U. STANLEY
DESIGNED BY: U. STANLEY	CHECKED BY: EVANS-MONGEON
	SHEET 38 OF 108