


PLAN  
 CURB TRANSITION DETAIL  
 VT ROUTE 64 STA. 219+04.5 TO 219+19.0 RT

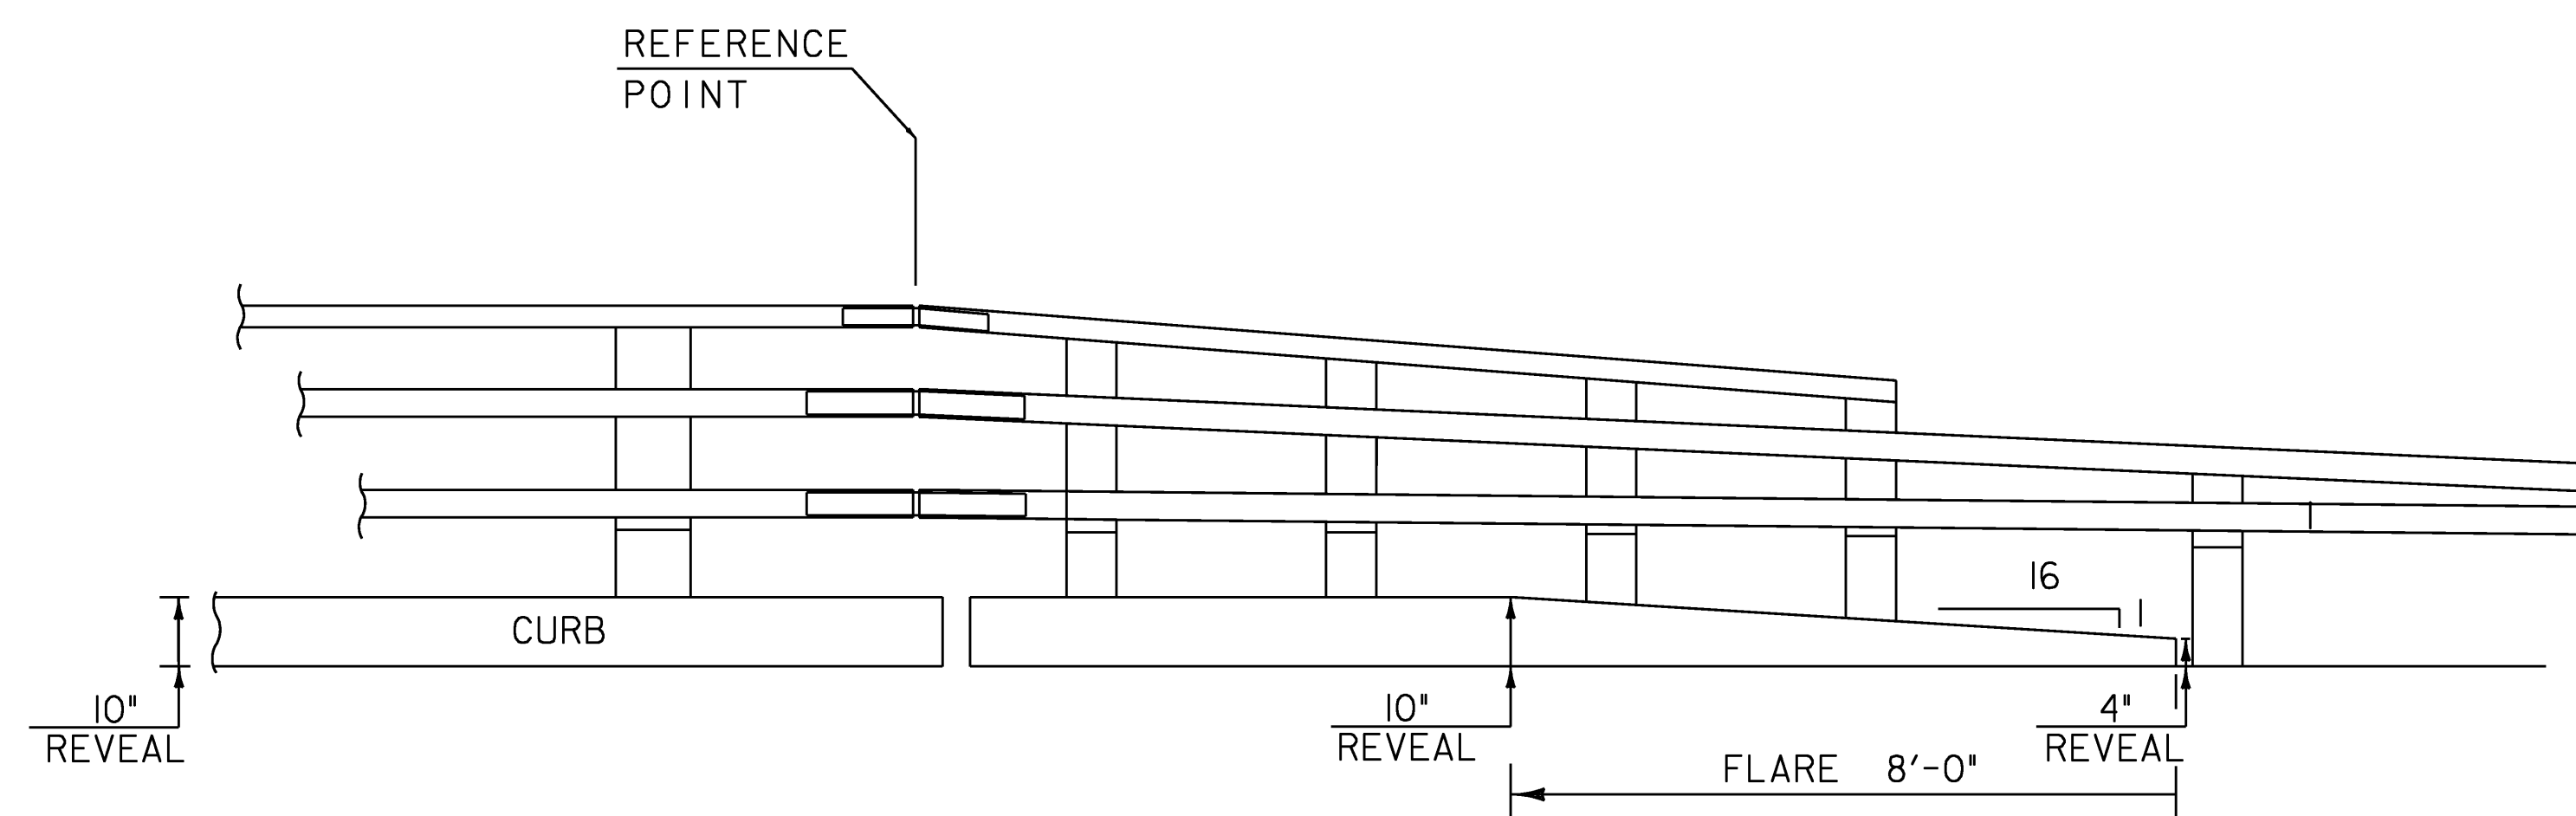

ELEVATION  
 CURB TRANSITION DETAIL  
 VT ROUTE 64 STA. 219+04.5 TO 219+19.0 RT

CURB TRANSITION DETAIL

PROJECT NAME: WILLIAMSTOWN  
 PROJECT NUMBER: BRS 0204(4)

FILE NAME: sellbr1dgerall.dgn  
 PROJECT LEADER: M. EVANS-MONGEON  
 DESIGNED BY: U. STANLEY  
 IPARM s83ellcurb

PLOT DATE:  
 DRAWN BY: U. STANLEY  
 CHECKED BY: EVANS-MONGEON  
 SHEET 47 OF 108

ALL DRAWINGS NTS