


ELEVATION

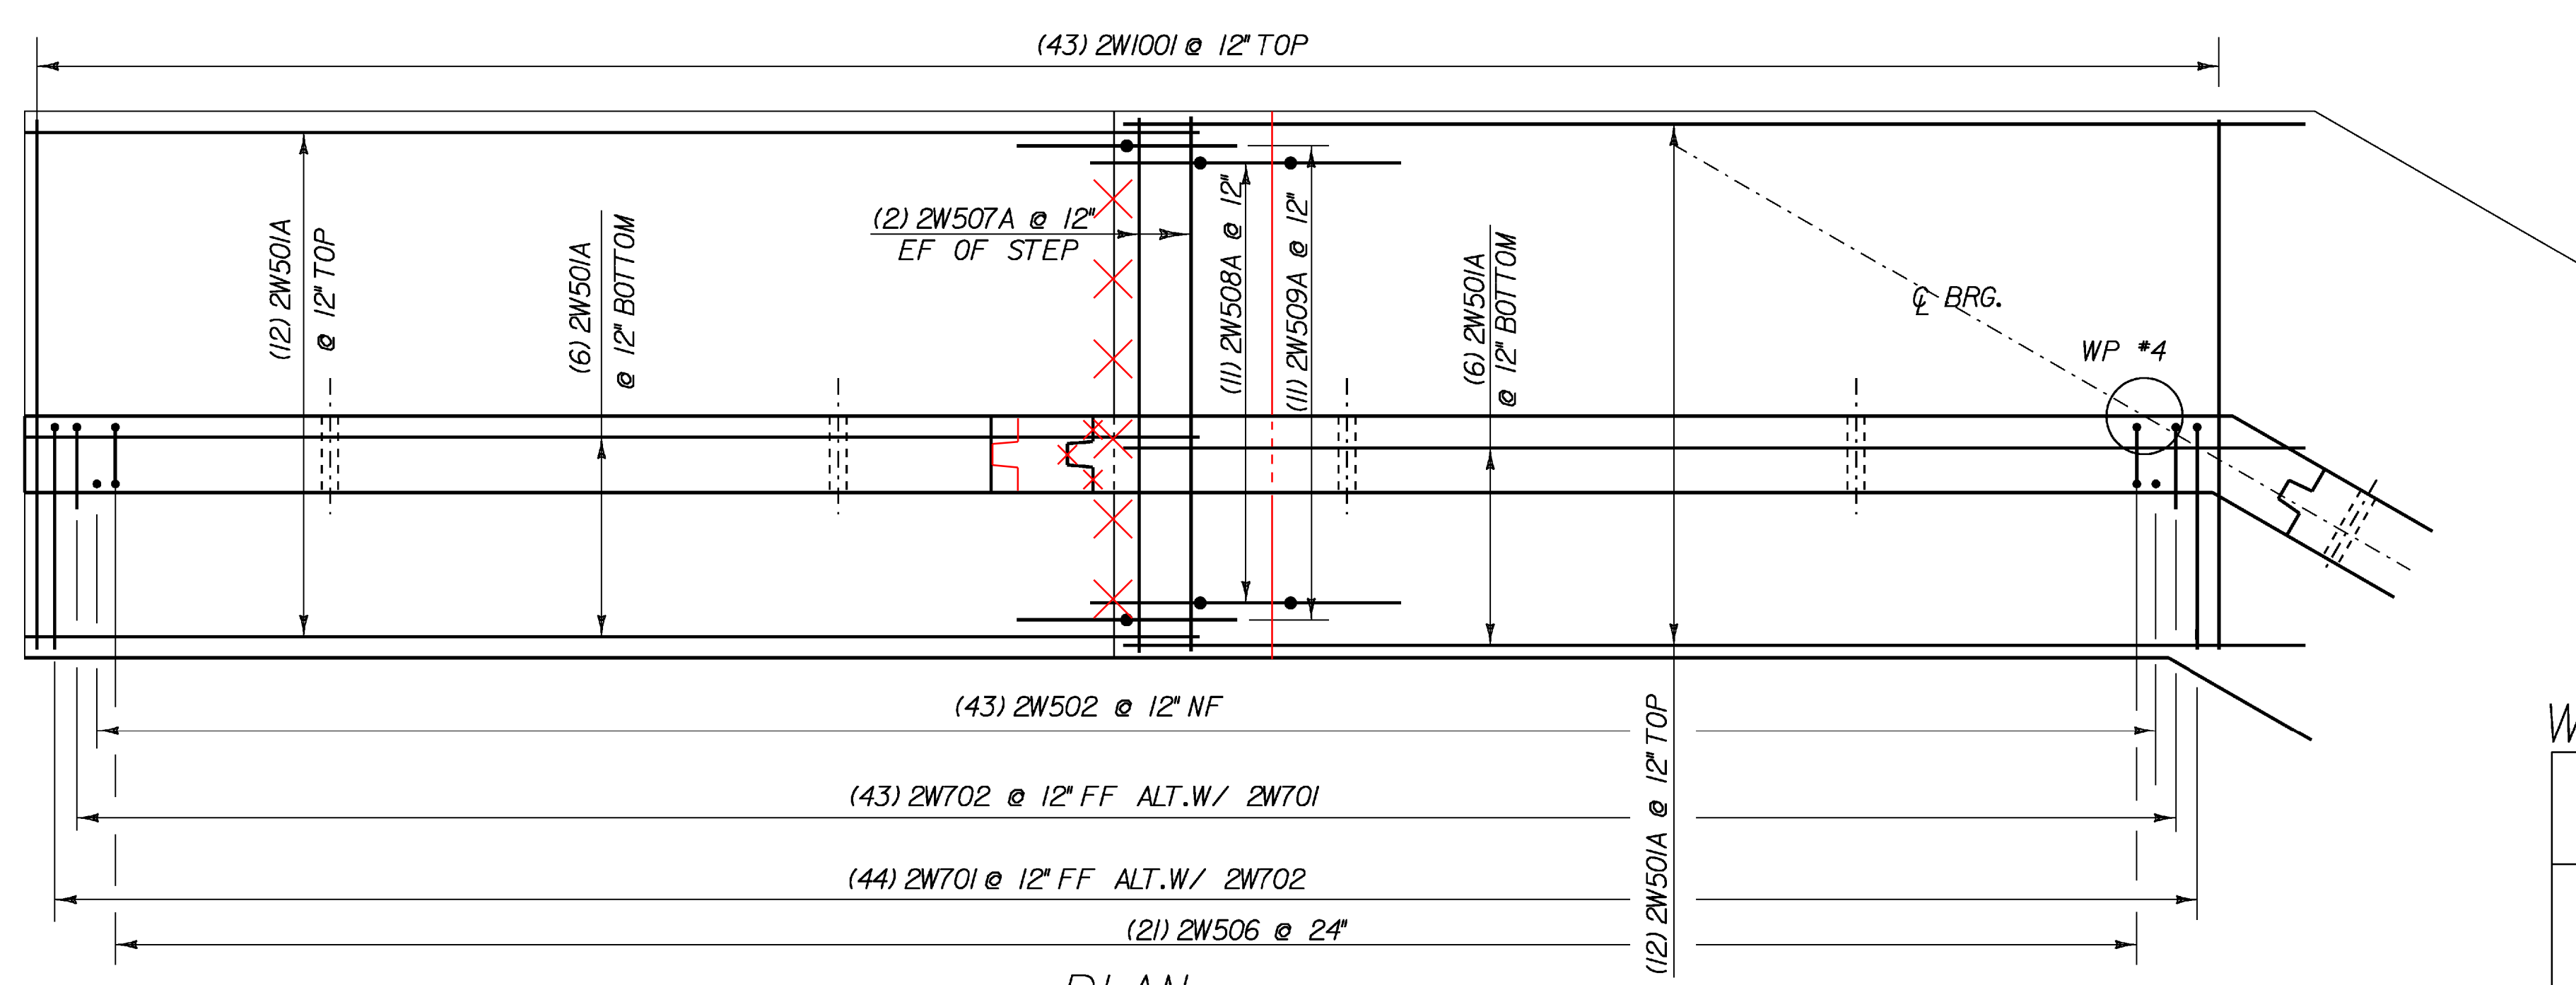

PLAN

WINGWALL #2
 SCALE 3/8" = 1'-0"
 1 0 1 2 3 4

NOTE:
 NF = NEAR FACE
 FF = FAR FACE
 EF = EACH FACE
 ▲ = CUT TO FIT IN FIELD
 3" CLR. UNLESS OTHERWISE
 SPECIFIED ON THE PLANS.

WINGWALL #2 REINFORCING SHEET 2

PROJECT NAME:	WILLIAMSTOWN	FILE NAME:	83ell\str.\sellabu1.dg	PLOT DATE:	07-APR-2008
PROJECT NUMBER:	BRS 0204(4)	PROJECT LEADER:	M.EVANS-MONGEON	DRAWN BY:	G.ROKES
		DESIGNED BY:	M.EVANS-MONGEON	CHECKED BY:	U. STANLEY
		IPARM:	sellsub9.1	SHEET:	61 OF 108