


ELEVATION

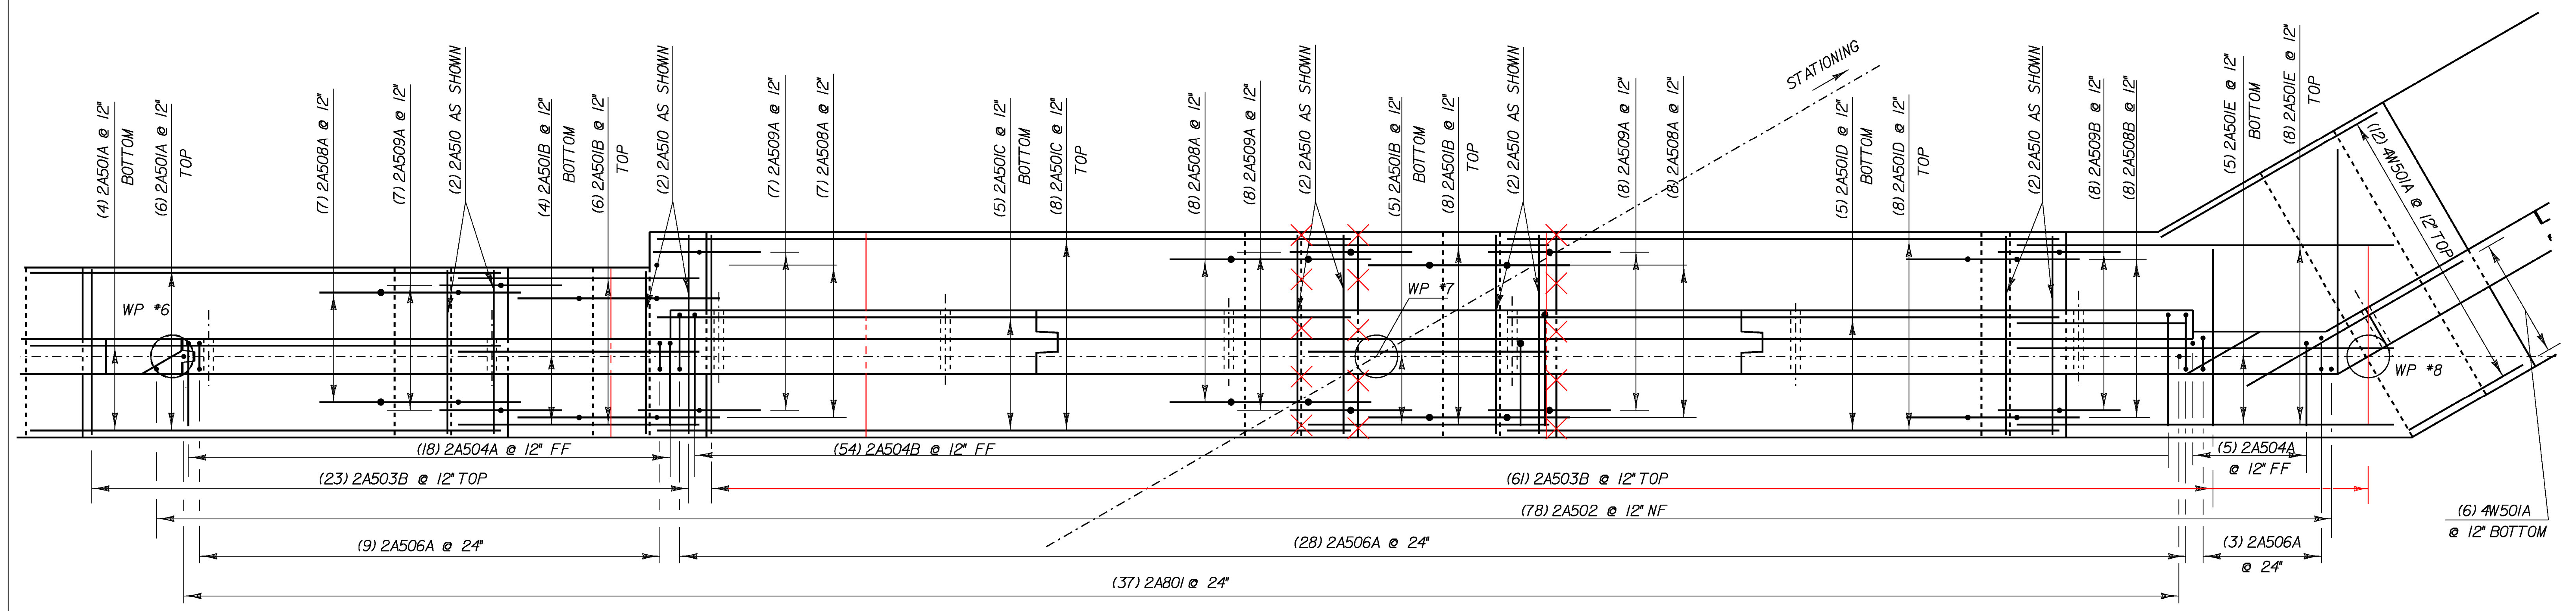

PLAN

ABUTMENT #2

SCALE 3/8" = 1'-0"
 1 0 1 2 3 4

NOTE:

NF = NEAR FACE
 FF = FAR FACE
 EF = EACH FACE
 ▲ = CUT TO FIT IN FIELD
 3" CLR. UNLESS OTHERWISE SPECIFIED ON THE PLANS.

ABUTMENT #2 REINFORCING

PROJECT NAME:	WILLIAMSTOWN	PLOT DATE:	07-APR-2008
PROJECT NUMBER:	BRS 0204(4)	DRAWN BY:	EVANS-MONGEON
FILE NAME:	83ell\str\sell\abut2.dgn	DESIGNED BY:	M.EVANS-MONGEON
IPARM	sellsub10.I	CHECKED BY:	U. STANLEY
		SHEET	62 OF 108