


ROADWAY CROSS SECTIONS

PROJECT NAME:	WILLIAMSTOWN	PLOT DATE:	07-APR-2008
PROJECT NUMBER:	BRS 0204(4)	DRAWN BY:	G.ROKES
FILE NAME:	83ell\Struct\sellxs.dgn	CHECKED BY:	EVANS-MONGEON
PROJECT LEADER:	EVANS-MONGEON	SHEET	73 OF 108
DESIGNED BY:	U. STANLEY		
IPARM:	sellxs.21		

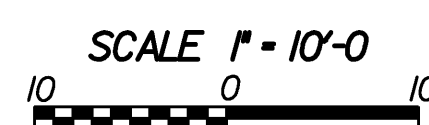

STA. 215+80 TO STA. 216+40